

# SURVEY MAP

OF PART OF

## ORIGINAL RIDGEVILLE TOWNSHIP


### LOT NOS 11 & 14

CITY OF N. RIDGEVILLE - COUNTY OF LORAIN -  
STATE OF OHIO -

DATE: MAY 14, 1974

SCALE: 1" = 30'

FRED LEE  
DV 986  
ANGELIE BLACK  

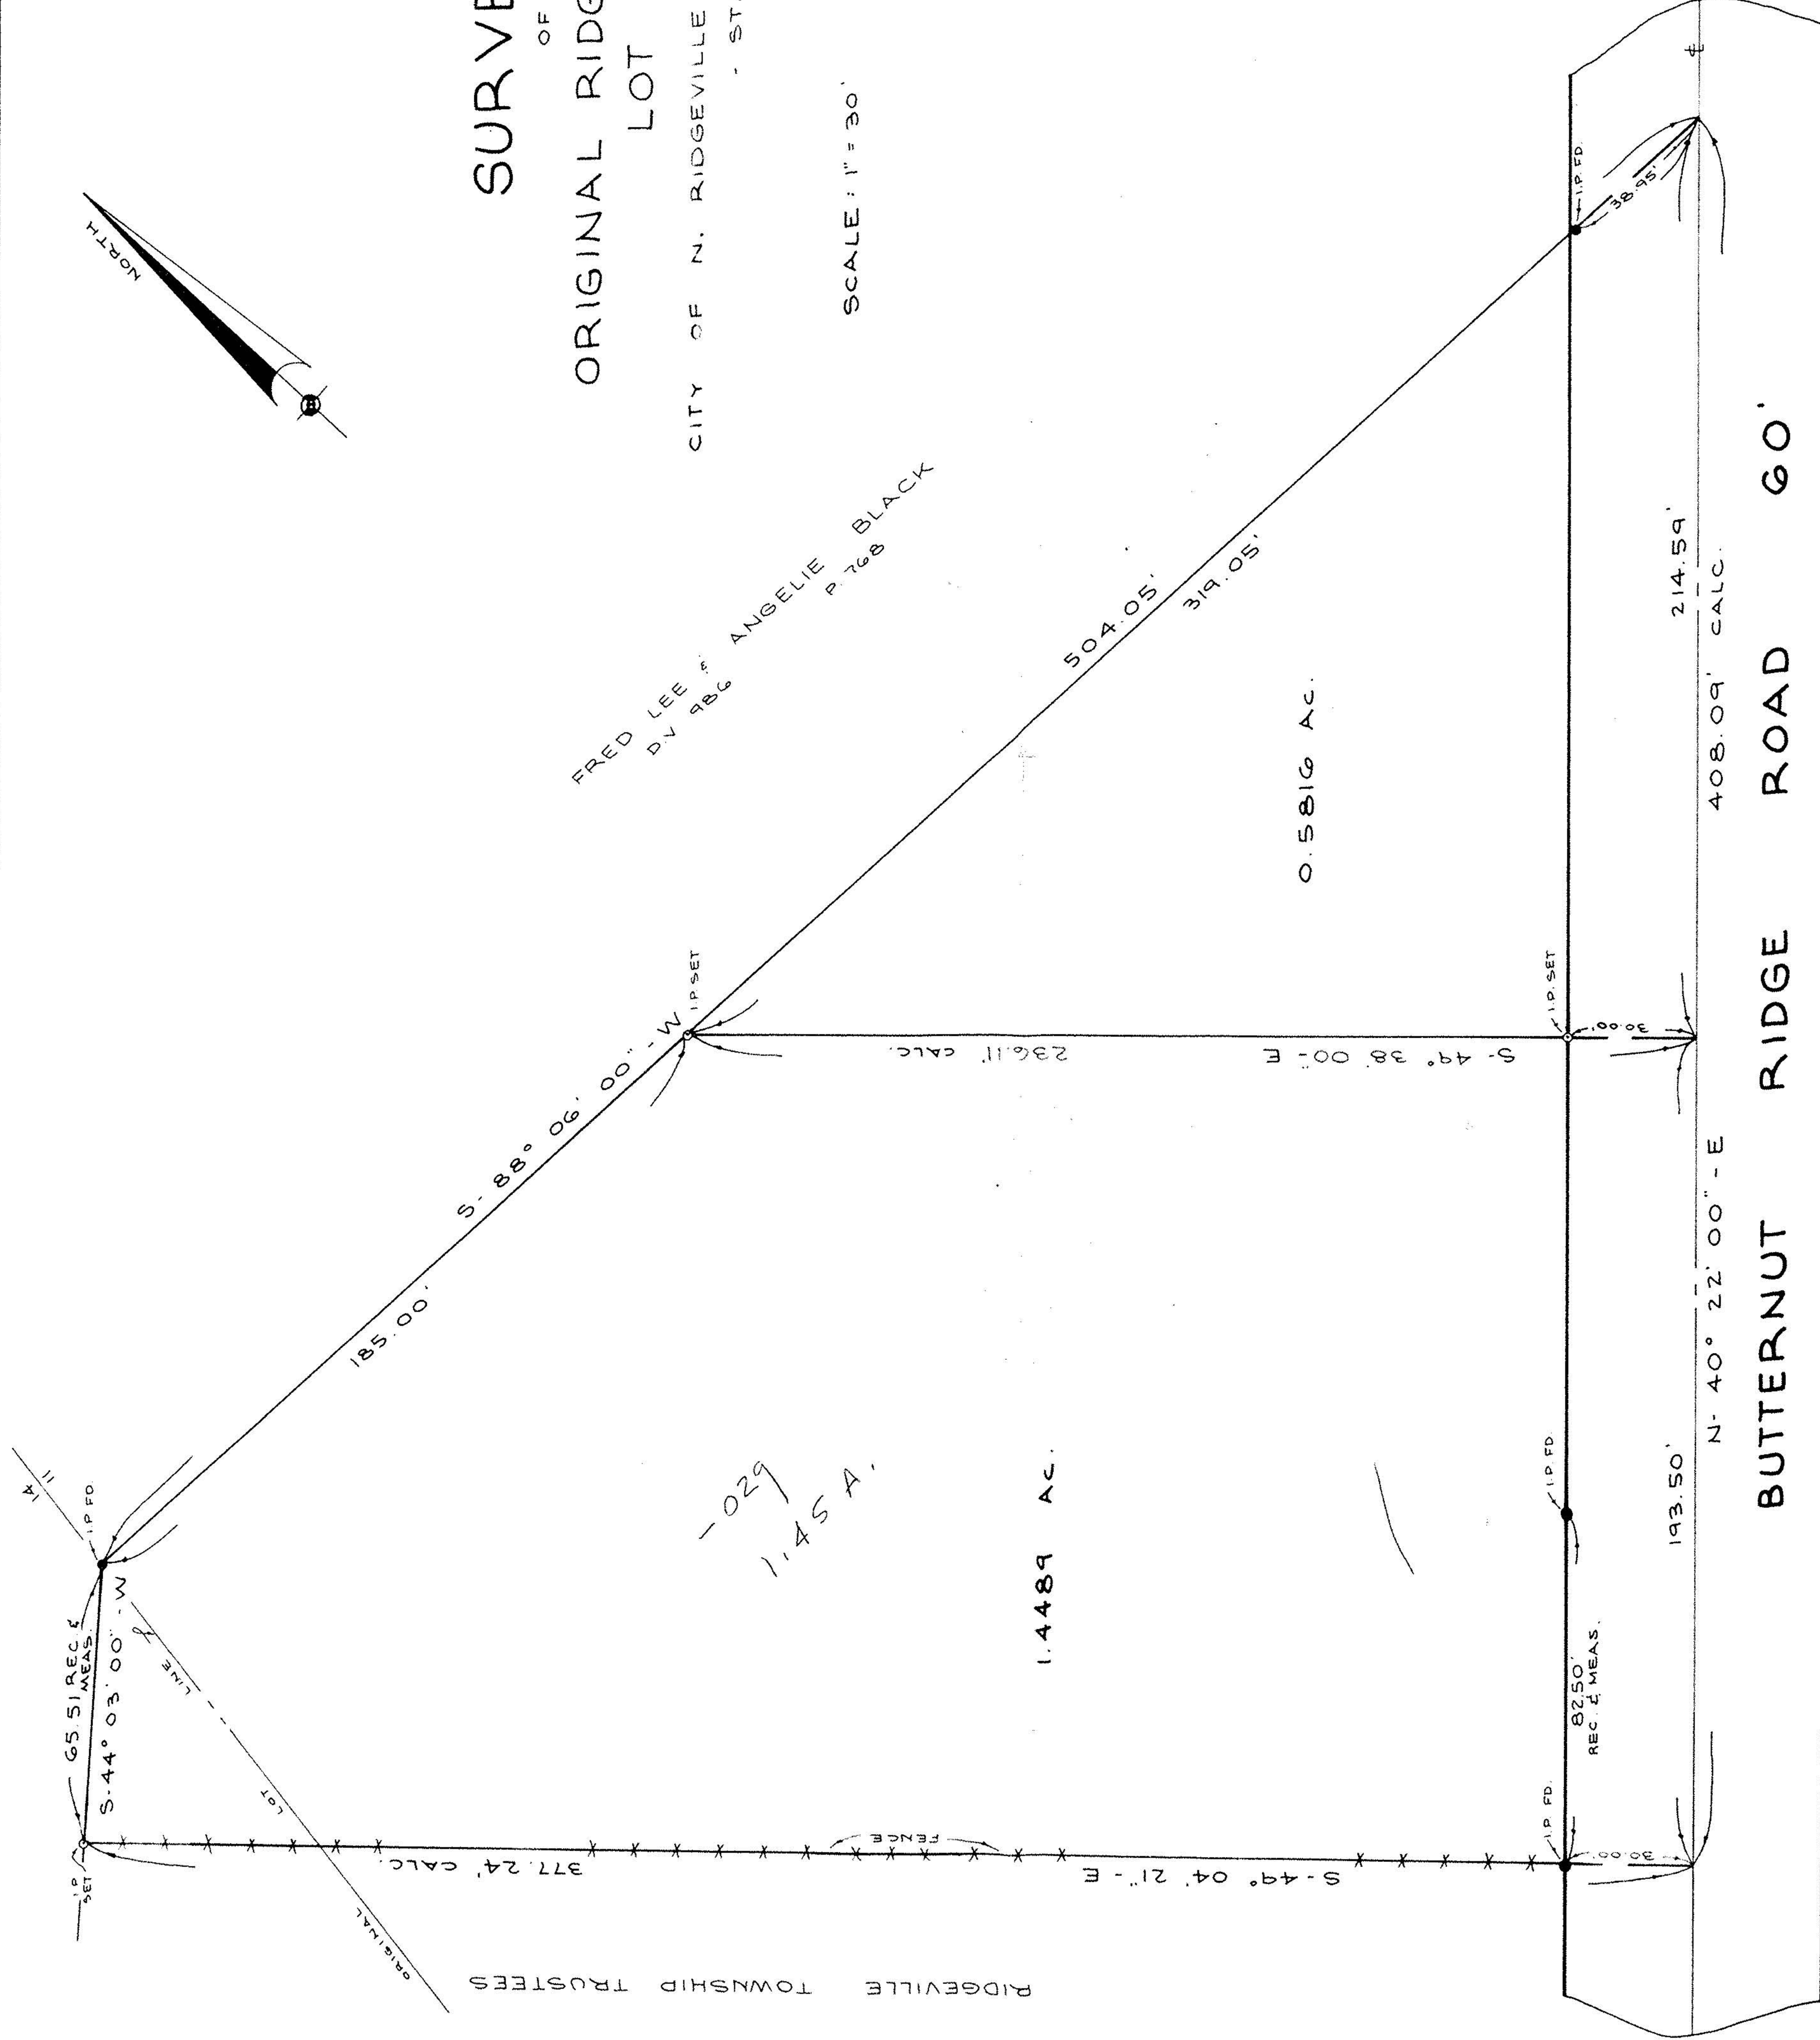

#15036

APPROVED
LORAIN CO.
MAP DEPT.
DATE 3-30-83
PAGE 1-00-011-78
BY C. Francis
VOID AFTER