SURVEY

OF PART OF

ORIGINAL RIDGEVILLE TOWNSHIP LOT NO. 20

CITY OF NORTH RIDGEVILLE COUNTY OF LORAIN

STATE OF OHIO

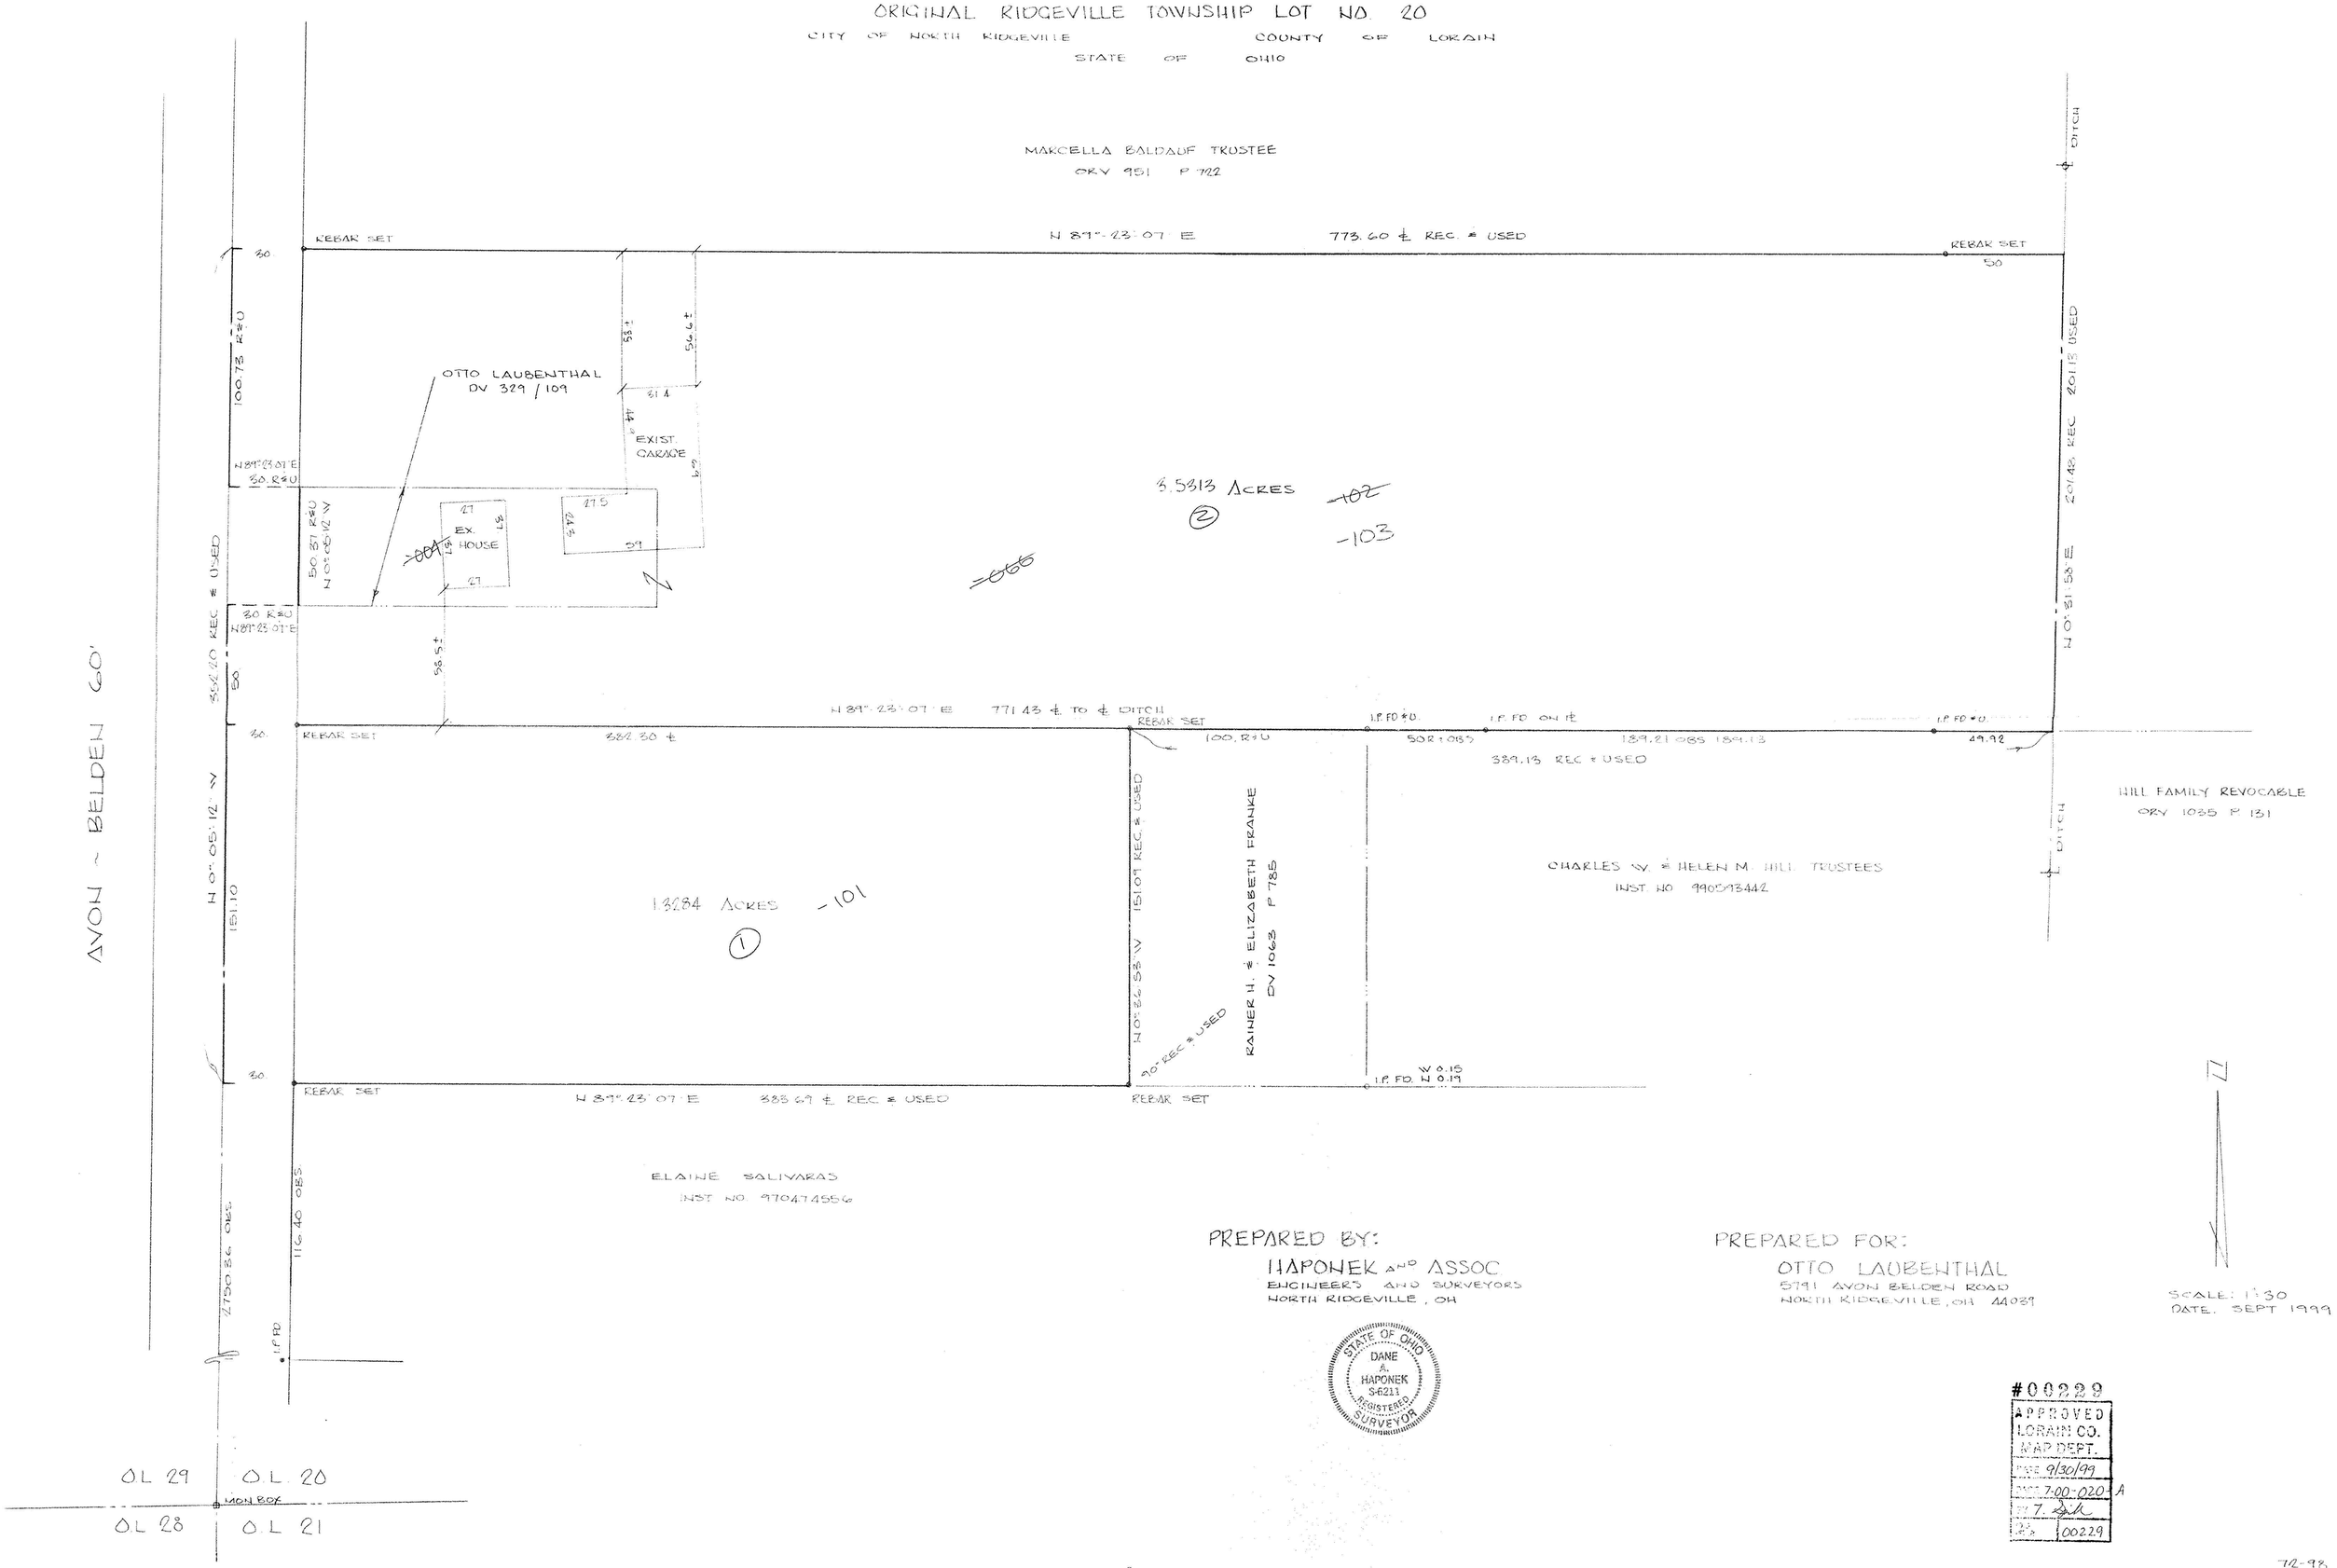

PREPARED BY:
HAPONEK AND ASSOC
ENGINEERS AND SURVEYORS
NORTH RIDGEVILLE, OH

STATE OF OHIO
DANE A. HAPONEK
S-6211
REGISTERED SURVEYOR

PREPARED FOR:
OTTO LAUBENTHAL
5791 AVON BELDEN ROAD
NORTH RIDGEVILLE, OH 44039

SCALE: 1"=30
DATE: SEPT 1999

#00229
APPROVED
LORAIN CO.
MAP DEPT.
DATE 9/30/99
DWG 7-00-020-A
BY
PG 00229

72-98