


SURVEY





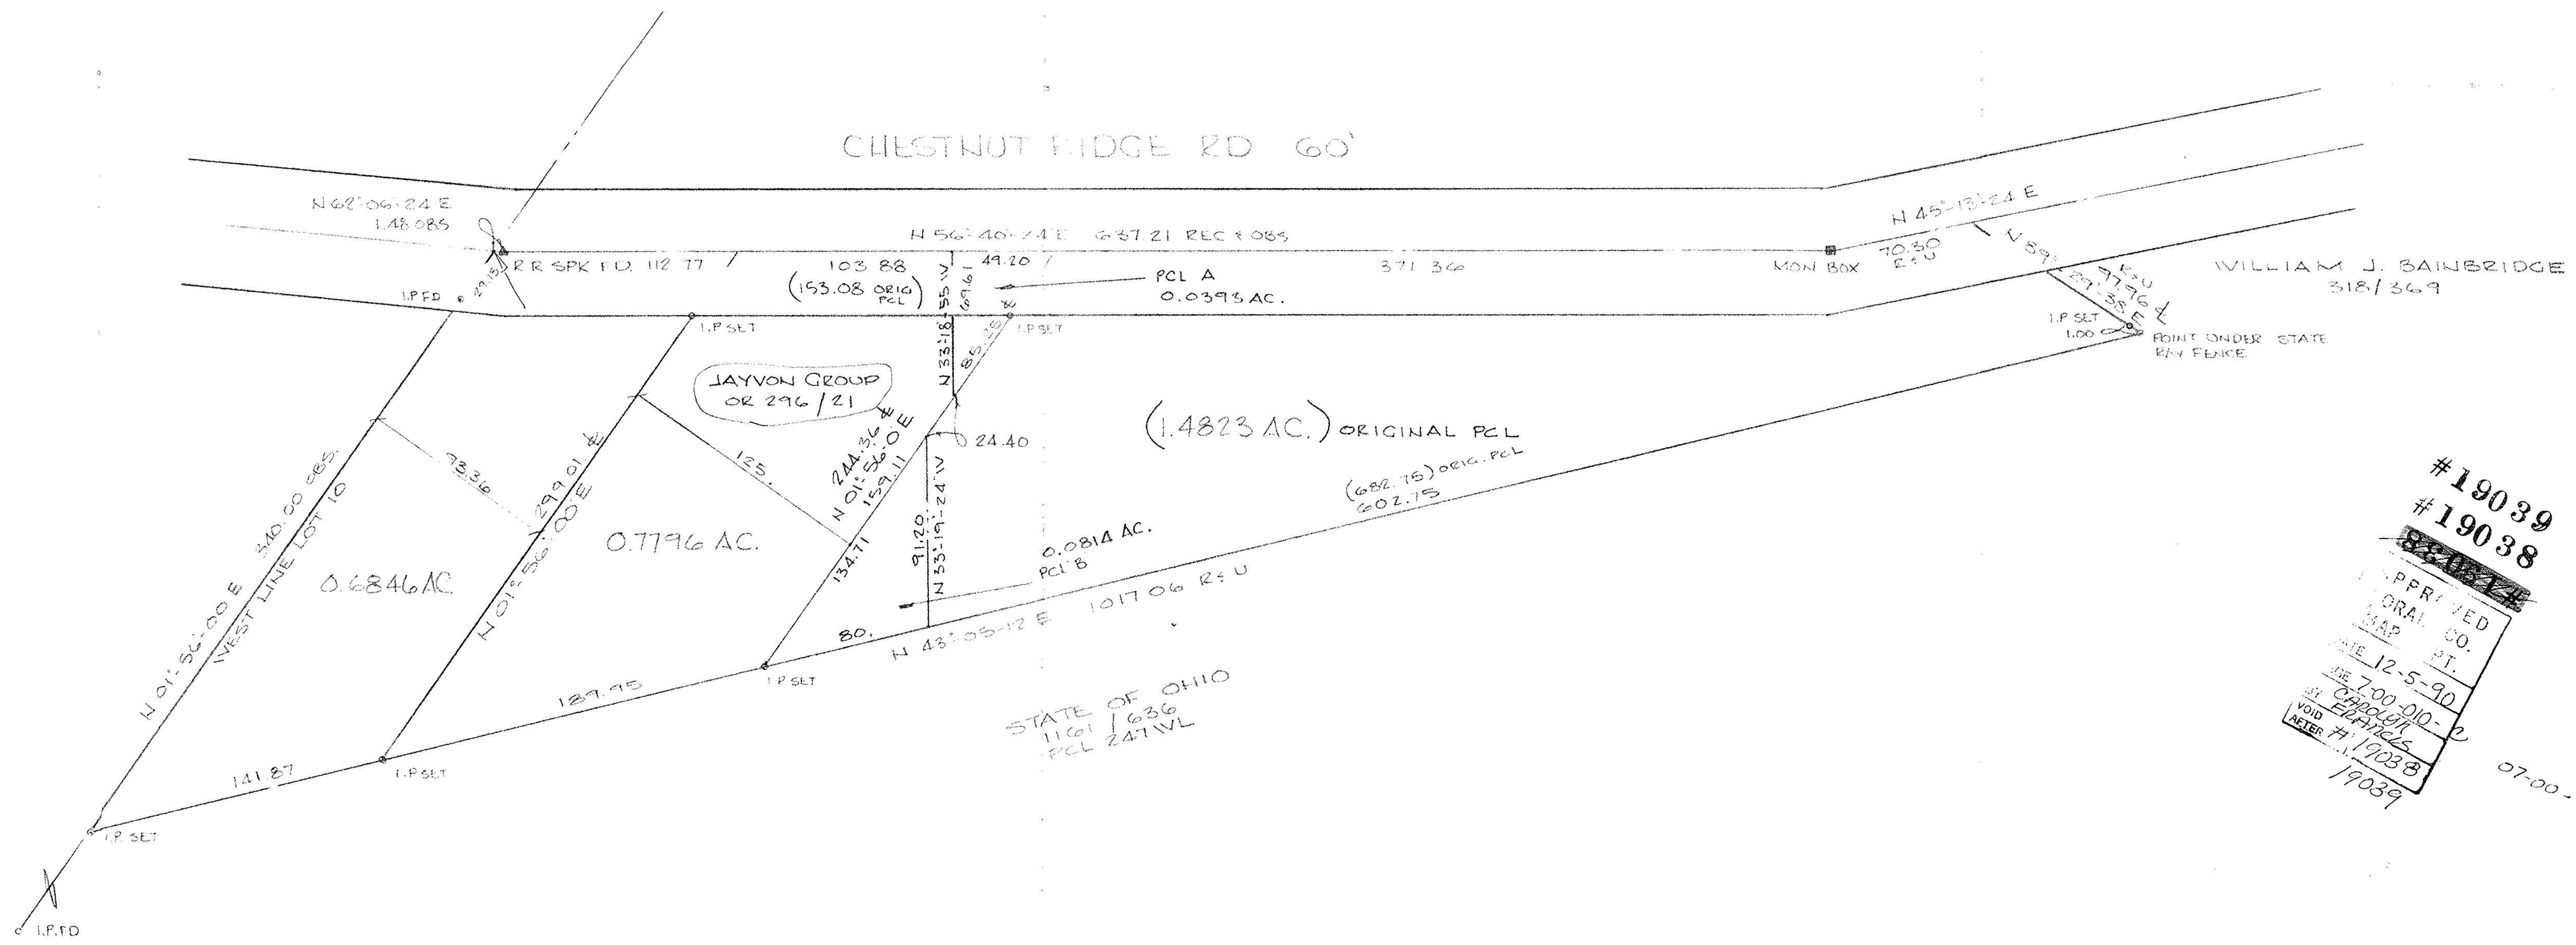

#19039
 #19038
 APPROVED
 MORAL CO.
 MAP
 DATE 12-5-90
 BY [Signature]
 VOID AFTER #19038
 19039
 07-00-010-107-

NOTES THIS PARCEL WAS SURVEYED BASED ON STATE HIGHWAY RECORDS.

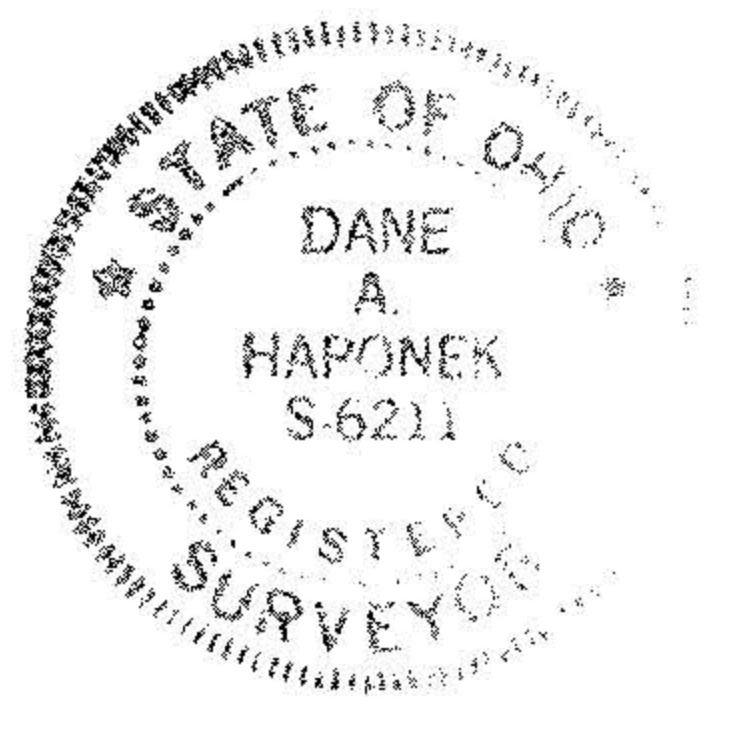

REVISED : 9-12-90 PCL SPLIT
 REVISED : 12-28-88 PCL SIZE
 REVISED : 1-20-89 PCL SIZE