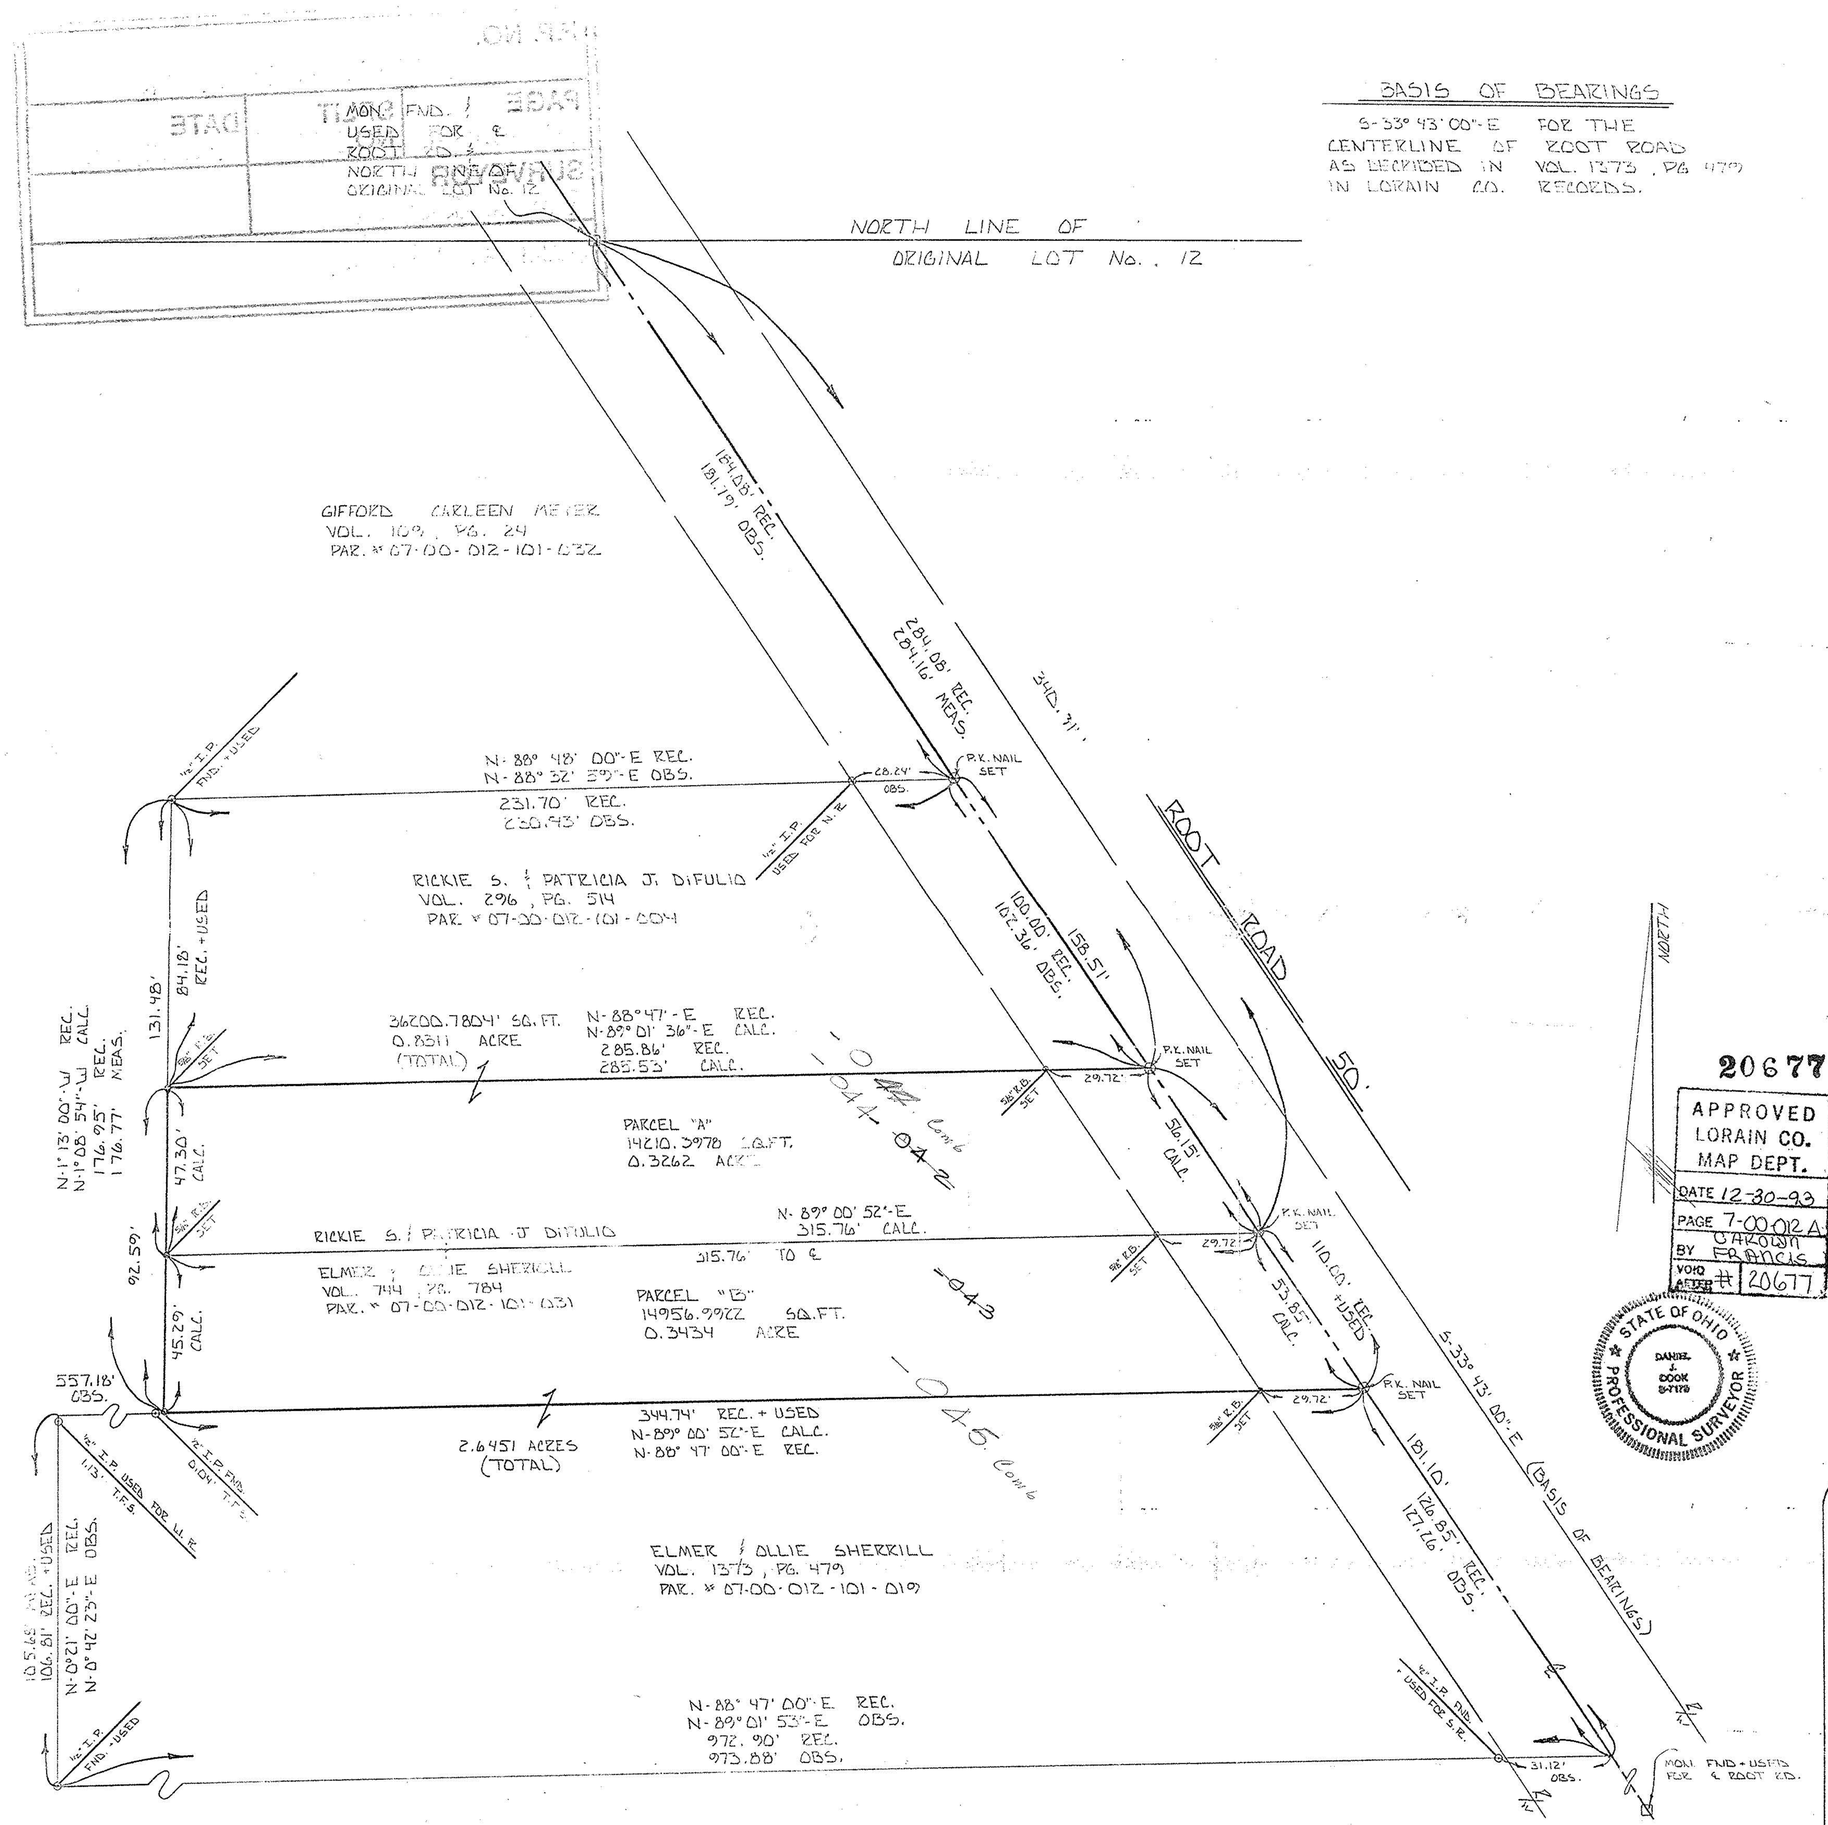


## BASIS OF BEARINGS

S-33° 43' 00"-E FOR THE CENTERLINE OF ROOT ROAD AS RECORDED IN VOL. 1373, PG 479 IN LORAIN CO. RECORDS.

## SURVEYOR'S CERTIFICATION

I HEREBY CERTIFY THAT THIS IS A TRUE & CORRECT MAP OF SURVEY AS PREPARED BY CAMPBELL & ASSOC. INC. AS A RESULT OF A FIELD SURVEY IN ACCORDANCE TO "MINIMUM STANDARDS FOR BOUNDARY SURVEYS IN THE STATE OF OHIO" (O.A.C. 4733-37) AND THAT ALL SURVEY MONUMENTATION HAS BEEN SET AS REQUIRED.

## SURVEY REFERENCE DATA

1.) LORAIN CO. TAX MAP (7-00-012-A)
2.) DEED RECORDS
- PARCEL TO BE SPLIT (VOL. 744, PG. 784)
- VARIOUS ADJOINERS DEEDS

20677

APPROVED
LORAIN CO.
MAP DEPT.
DATE 12-30-93
PAGE 7-00-012 A
BY CAROLYN FRANCIS
VOID AFTER # 20677

David J. Cook 11/16/93
DANIEL J. COOK P.S. DATE
% CAMPBELL ASSOC. INC
REGISTERED SURVEYOR # 7179

07-00-012-101-

STATE OF OHIO
DANIEL J. COOK
S-7179
PROFESSIONAL SURVEYOR

0' 30' 60' 90'
GRAPHIC SCALE . 1"= 30'

# PARCEL SPLIT & CONSOLIDATION MAP

BEING PART OF ORIGINAL RIDGEVILLE TWP. LOT 12

PREPARED FOR: RICKIE S. & PATRICIA J. DIFULIO
8934 ROOT ROAD
NORTH RIDGEVILLE, OH. 44039

CAMPBELL & ASSOC. INC.
5415 SCHAAF ROAD
INDEPENDENCE, OHIO 44131
(216) 642-8555

DATE: 15 NOVEMBER 1993
SCALE: 1"= 30'
DRAWN BY: ANTHONY J. BLASIO
CHECKED BY: DANIEL J. COOK

Copyright © 1993, by Campbell & Associates, Inc.
All rights reserved.
Reproduction or translation of any part of this work beyond that permitted by Sections 107 and 108 of the 1976 United States Copyright Act without the permission of the copyright owner is unlawful. Requests for permission or further information should be addressed to Campbell & Associates, Inc.