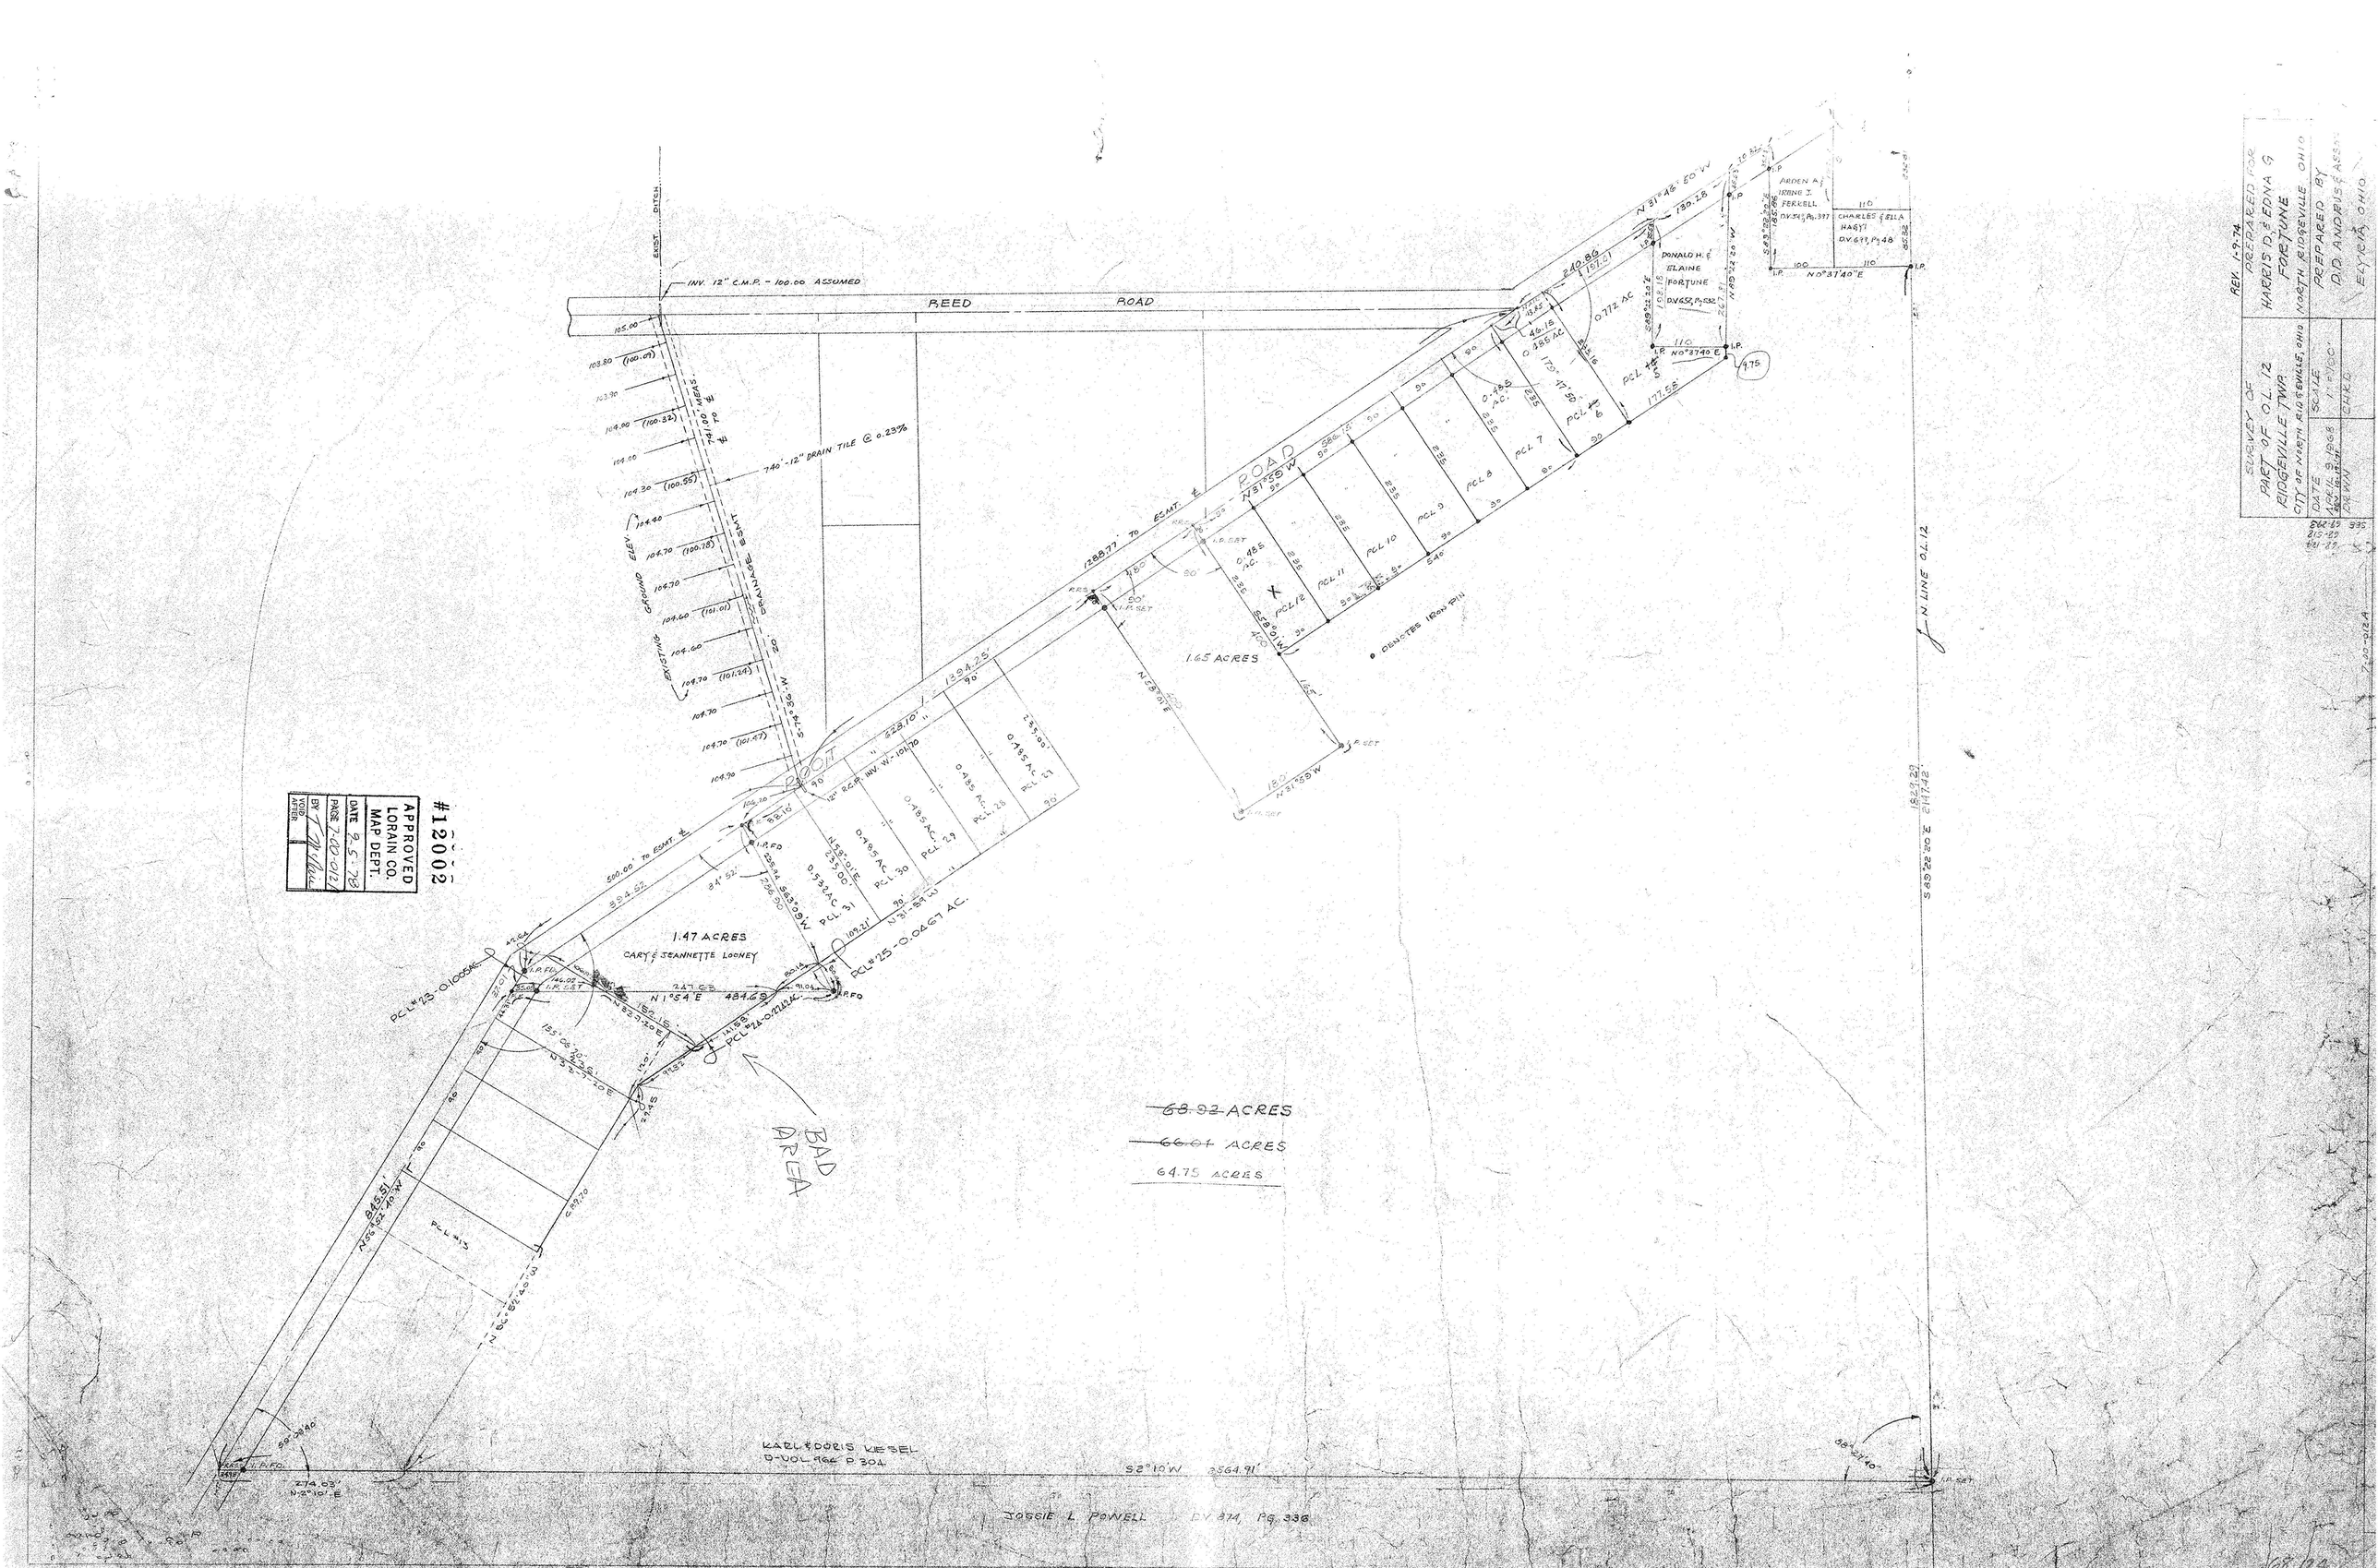
REV. 1-9-74
PREPARED FOR
HARRIS D. & EDNA G. FORTUNE
NORTH RIDGEVILLE OHIO
PREPARED BY
D.D. ANDRUS & ASSOC.
ELYRIA, OHIO
SURVEY OF
PART OF O.L. 12
RIDGEVILLE TWP.
CITY OF NORTH RIDGEVILLE, OHIO
DATE 9-1-68
APR. 16, 1968
DR. WM
SCALE 1" = 100'
CHK'D
7-20-012A
REED ROAD
INV. 12" C.M.P. - 100.00 ASSUMED
740' - 12" DRAIN TILE @ 0.23%
DRAINAGE ESMT.
EXIST. DITCH
GROUND ELEV.
N. LINE O.L. 12
1.65 ACRES
1.47 ACRES
CARY & JEANNETTE LOONEY
DONALD H. & ELAINE FORTUNE
DV. 652, Pg. 532
ARDEN A. & IRENE E. FERRELL
DV. 374, Pg. 377
CHARLES & ELLA HAGY
DV. 677, Pg. 48
KARL & DORIS KESEL
D-VOL. 966 P. 301
JESSIE L. POWELL DV. 374, Pg. 338
BAD AREA
~~68.92~~ ACRES
~~66.04~~ ACRES
64.75 ACRES
#12002
APPROVED
LORAIN CO.
MAP DEPT.
DATE 9-5-78
PAGE 7-20-012
BY
VOID AFTER