MAP OF SURVEY

FOR

RIDGEFIELD HOMES

SITUATED IN THE CITY OF NORTH RIDGEVILLE COUNTY OF LORAIN AND STATE OF OHIO AND KNOWN AS BEING PART OF ORIGINAL RIDGEVILLE TOWNSHIP LOT No. 12.

0' 200' 400' 600'

SCALE 1"=200'-0"
JANUARY 6, 1995

NORTH

MACKAY
Engineering & Surveying Company
7017 Pearl Road, Cleveland, Ohio 44130
(216) 886-4500 (216) 886-4590 Fax

DIMENSIONS SHOWN HEREON ARE EXPRESSED IN FEET AND DECIMAL PARTS THEREOF. BEARINGS SHOWN ARE TO AN ASSUMED MERIDIAN AND ARE USED TO EXPRESS ANGLES ONLY. MONUMENTS WERE FOUND OR SET AS INDICATED HEREON. ALL OF WHICH I CERTIFY TO BE CORRECT.

Richard R. Mackay
RICHARD R. MACKAY

STATE OF OHIO
RICHARD ROY MACKAY
4195
REGISTERED PROFESSIONAL SURVEYOR

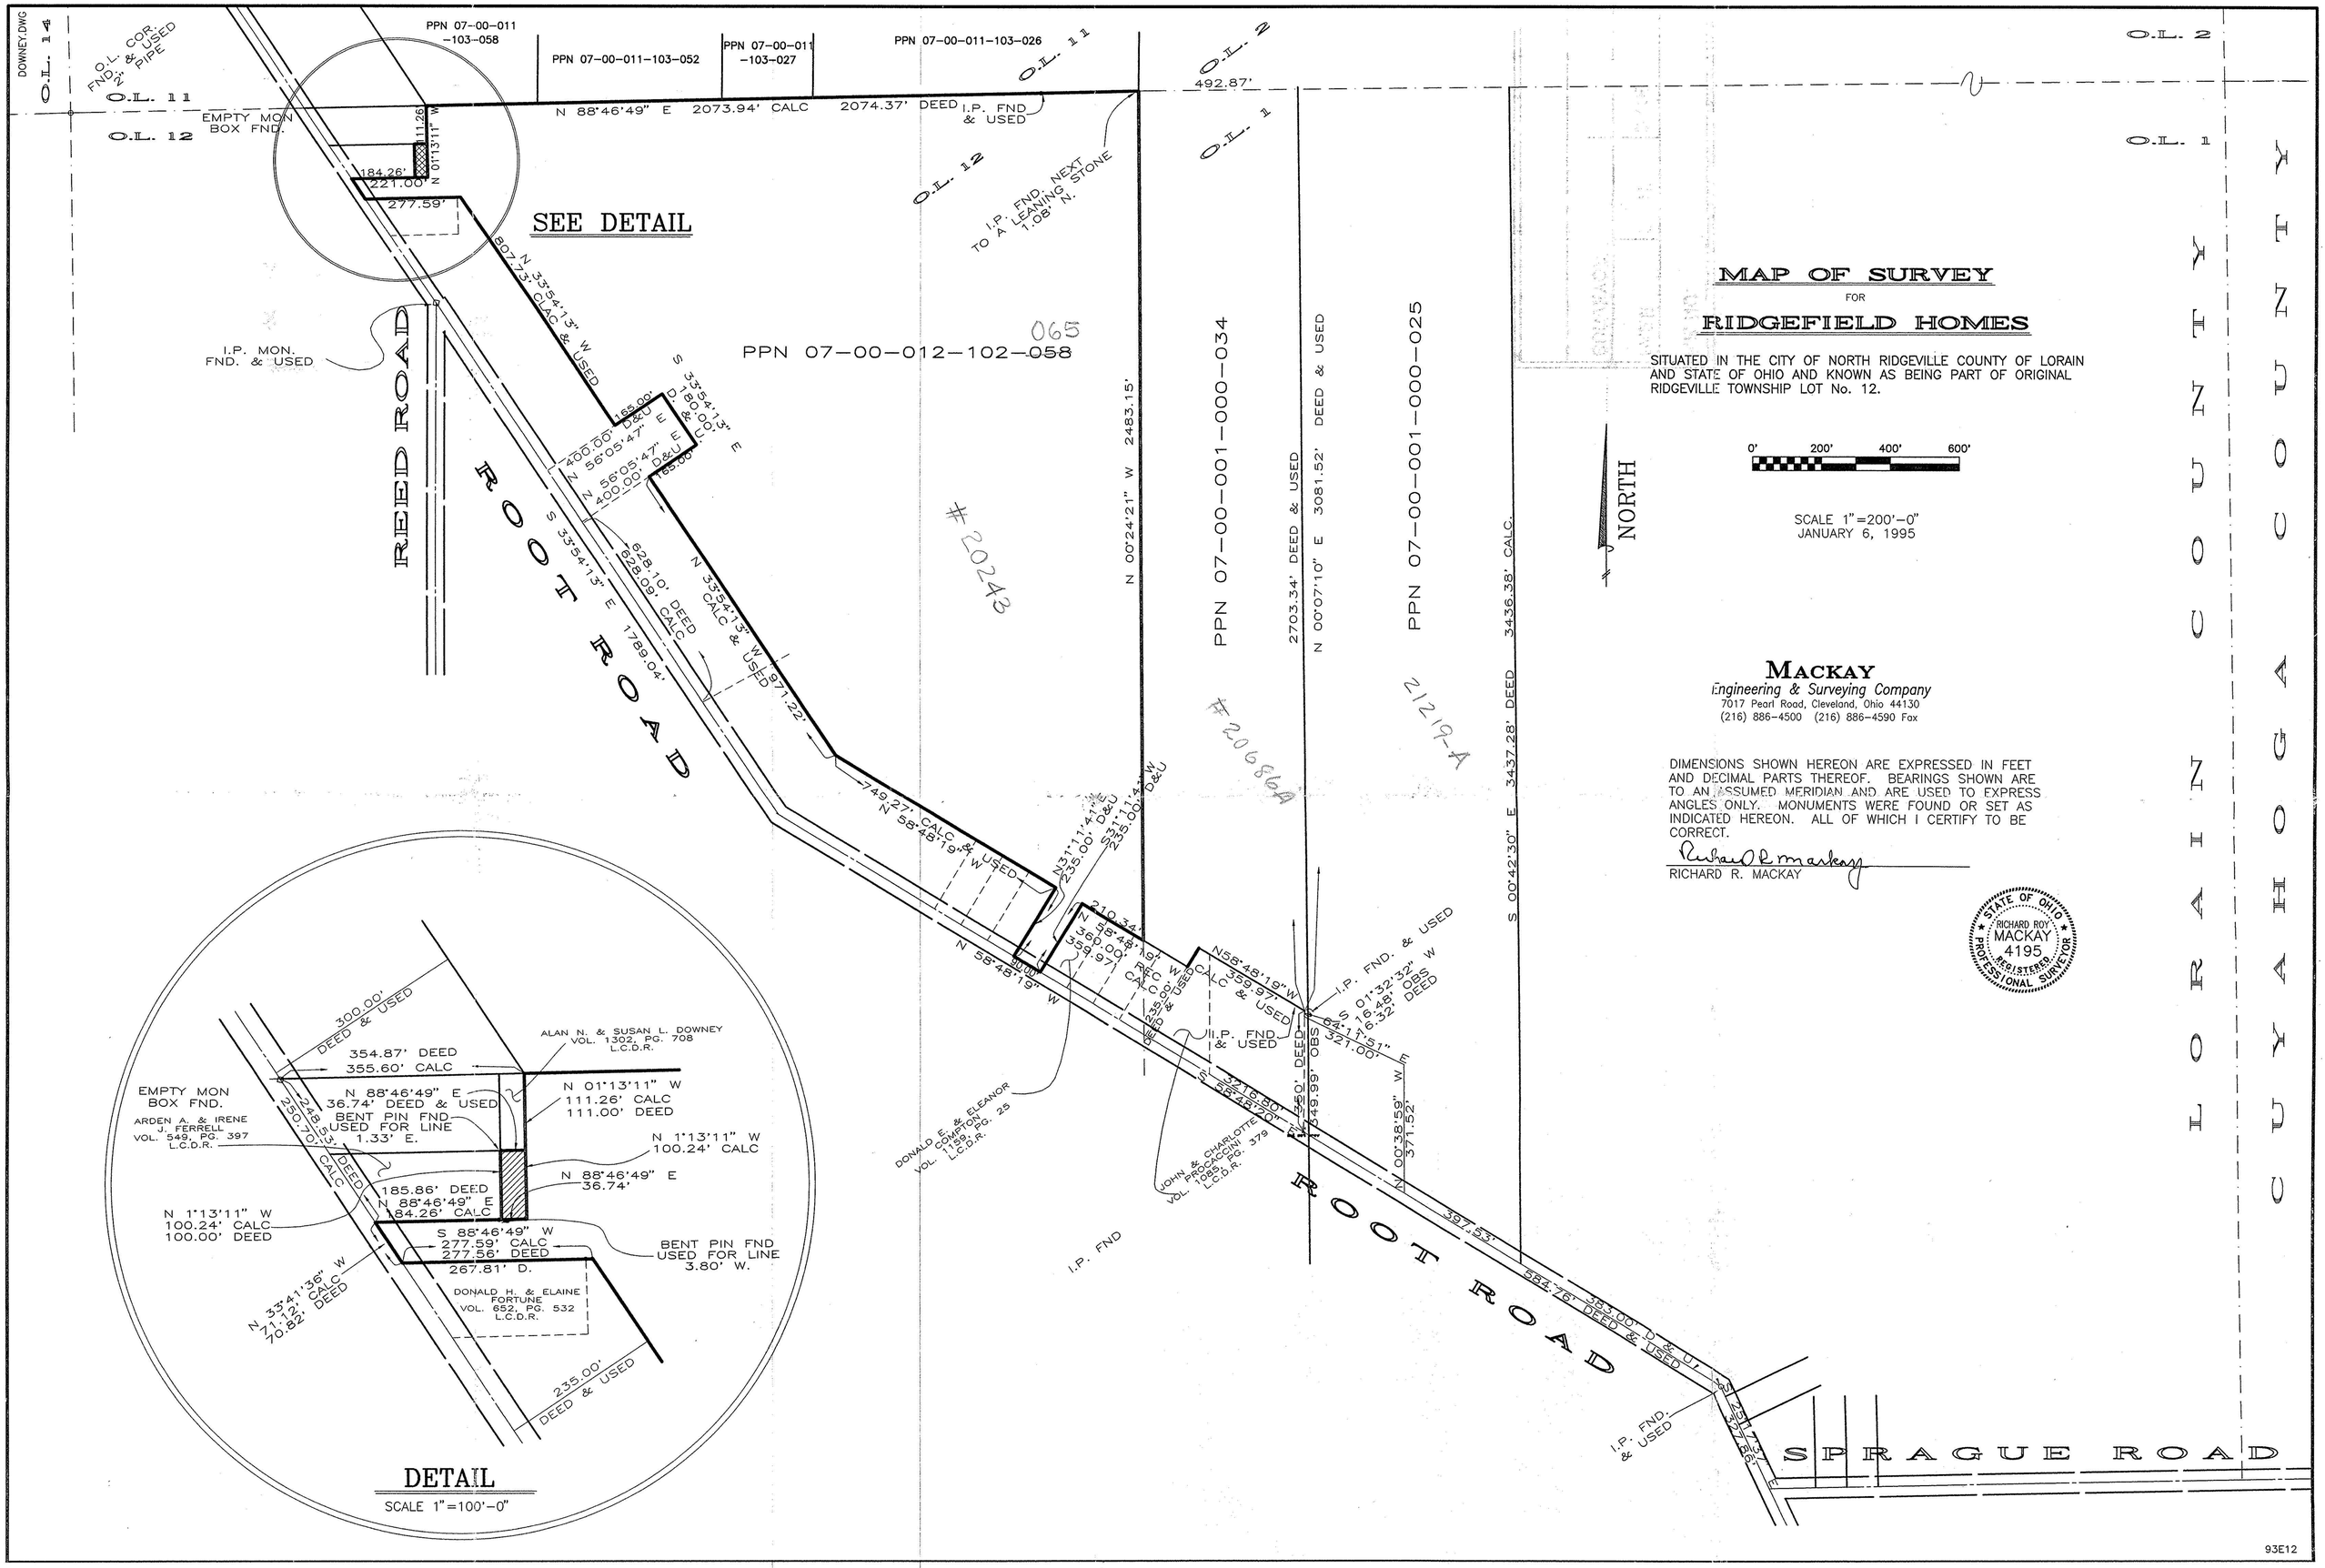

93E12