P.P.N 04-00-013-000-131

SURVEY
OF PART OF
ORIGINAL RIDGEVILLE TWP
LOT Nº 13

CITY OF N. RIDGEVILLE COUNTY OF LORAIN
STATE OF OHIO

SCALE 1" = 60'
DATE: JAN. 2002

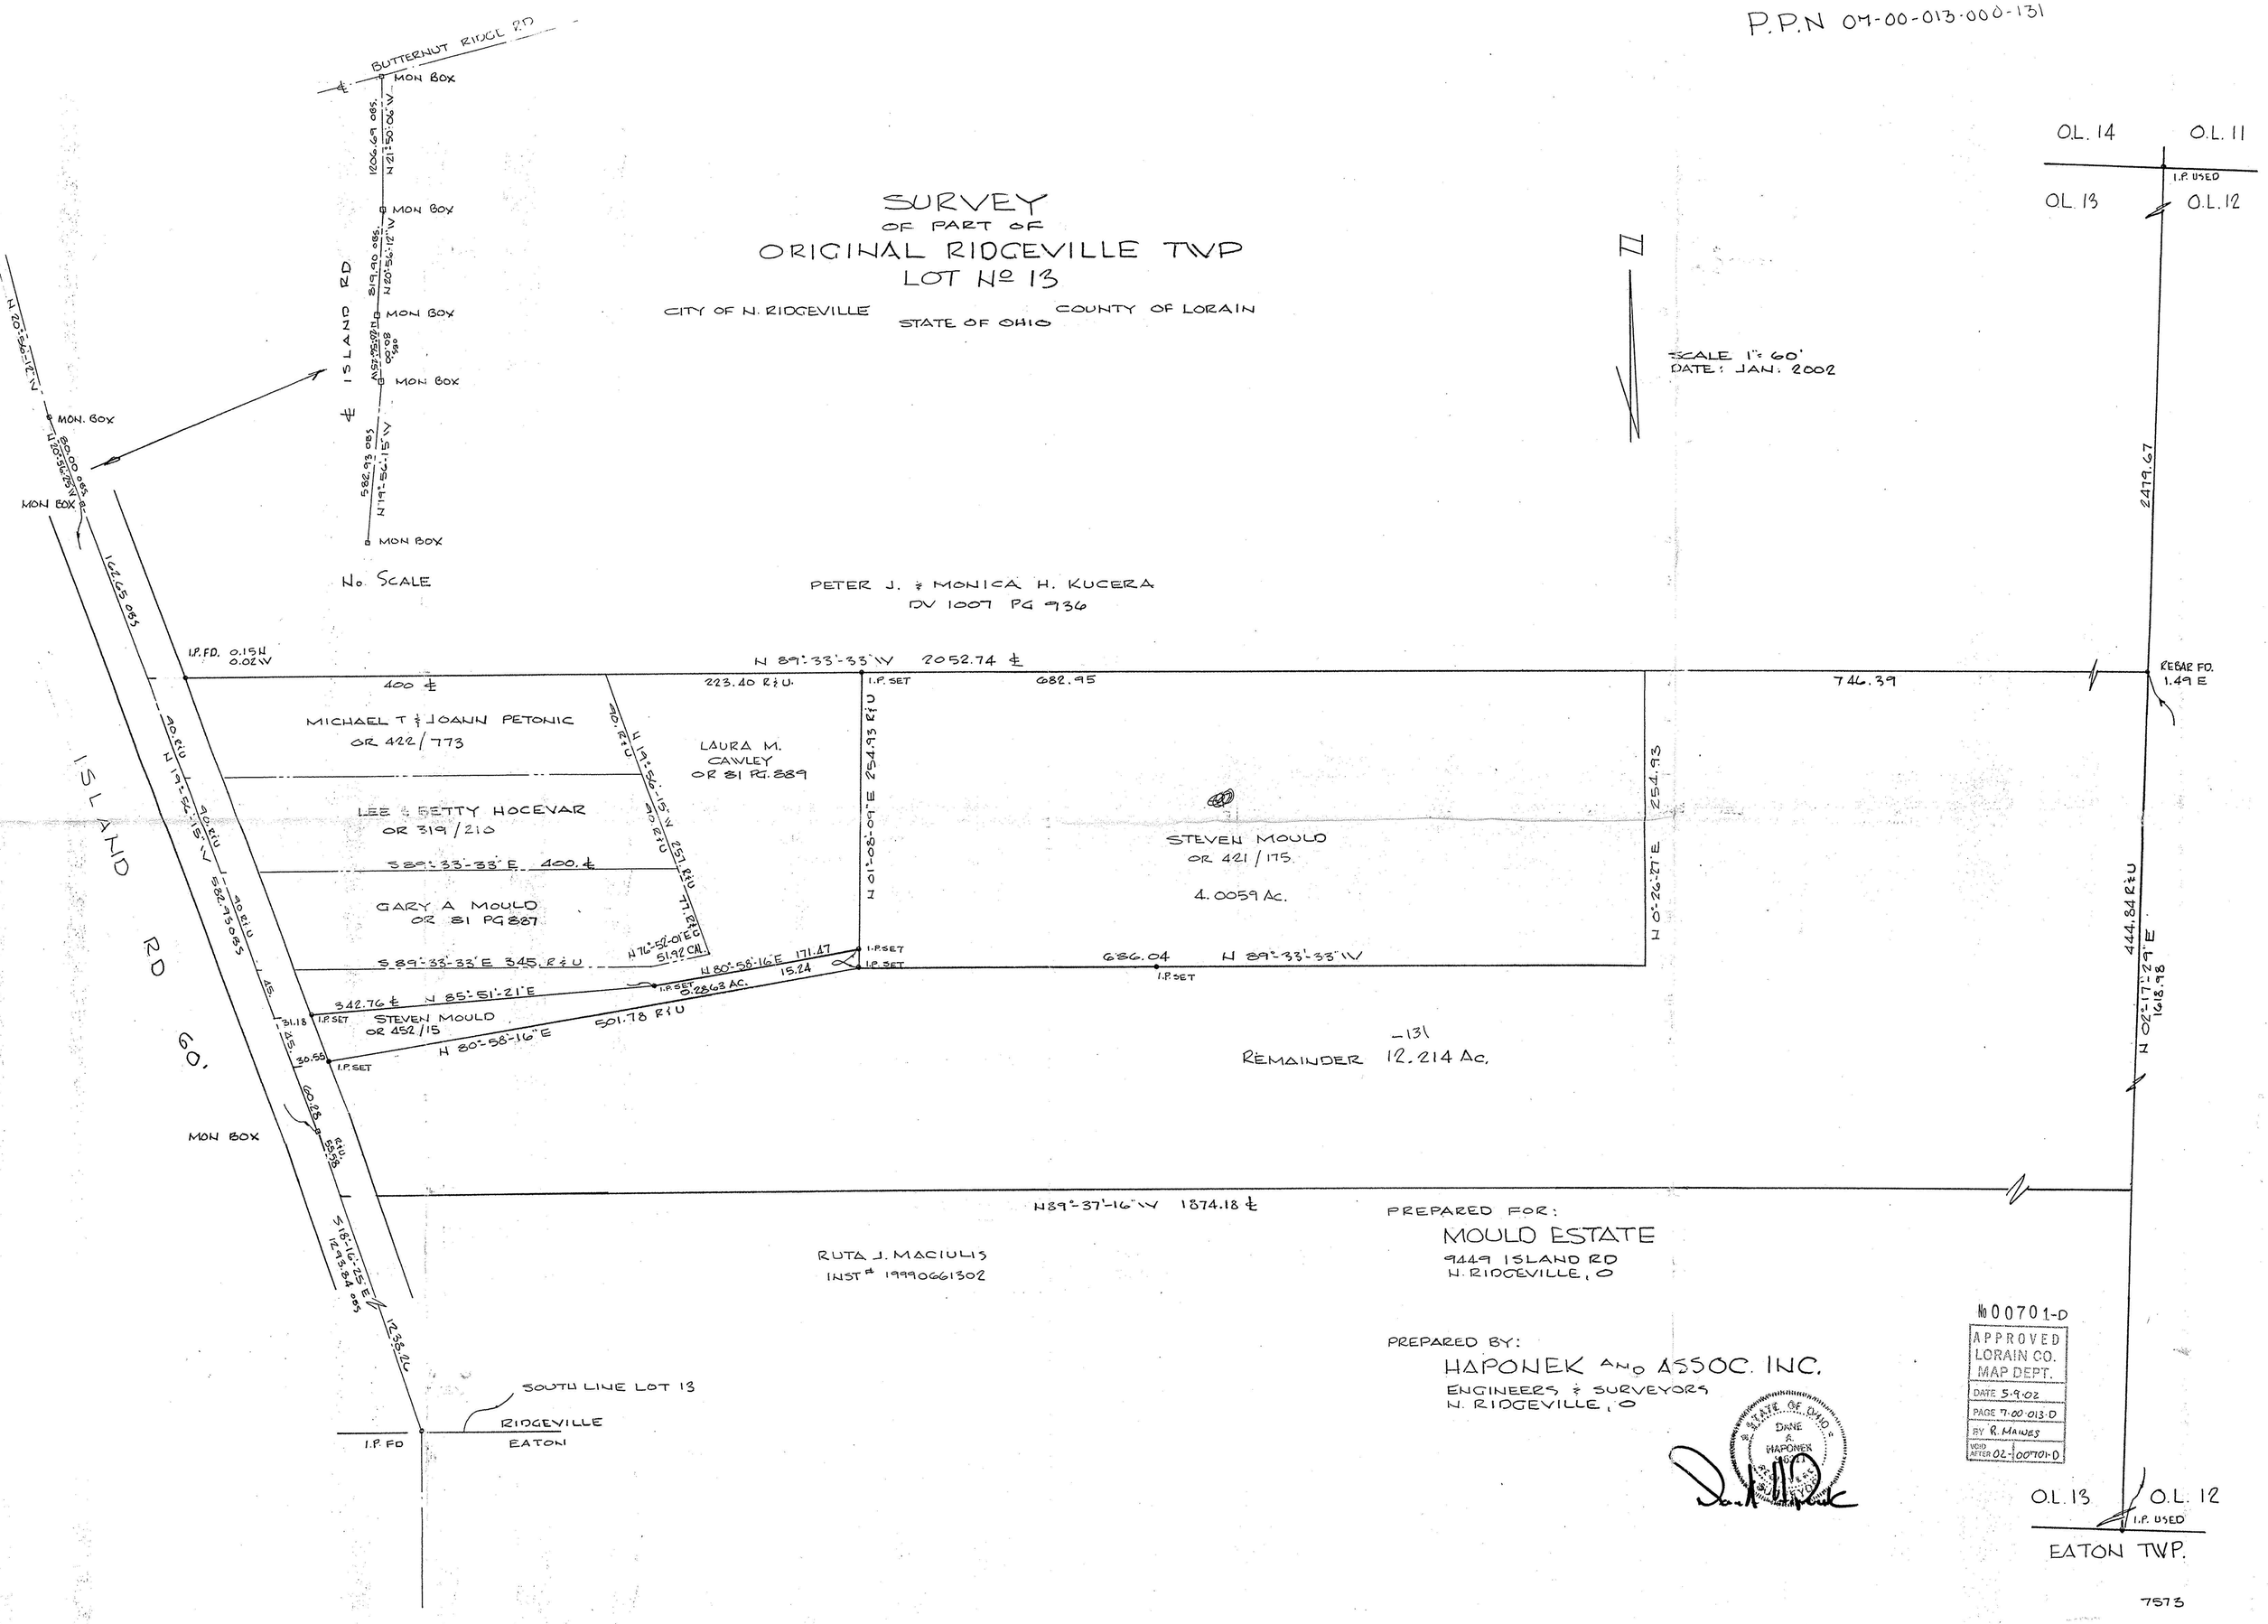

PREPARED FOR:
MOULD ESTATE
9449 ISLAND RD
N. RIDGEVILLE, O

PREPARED BY:
HAPONEK AND ASSOC. INC.
ENGINEERS & SURVEYORS
N. RIDGEVILLE, O

STATE OF OHIO
DANE A. HAPONEK
16677

Nº 00701-D
APPROVED
LORAIN CO.
MAP DEPT.
DATE 5-9-02
PAGE 77-00-013-D
BY R. MAWES
VOID AFTER 02-00701-D

7573