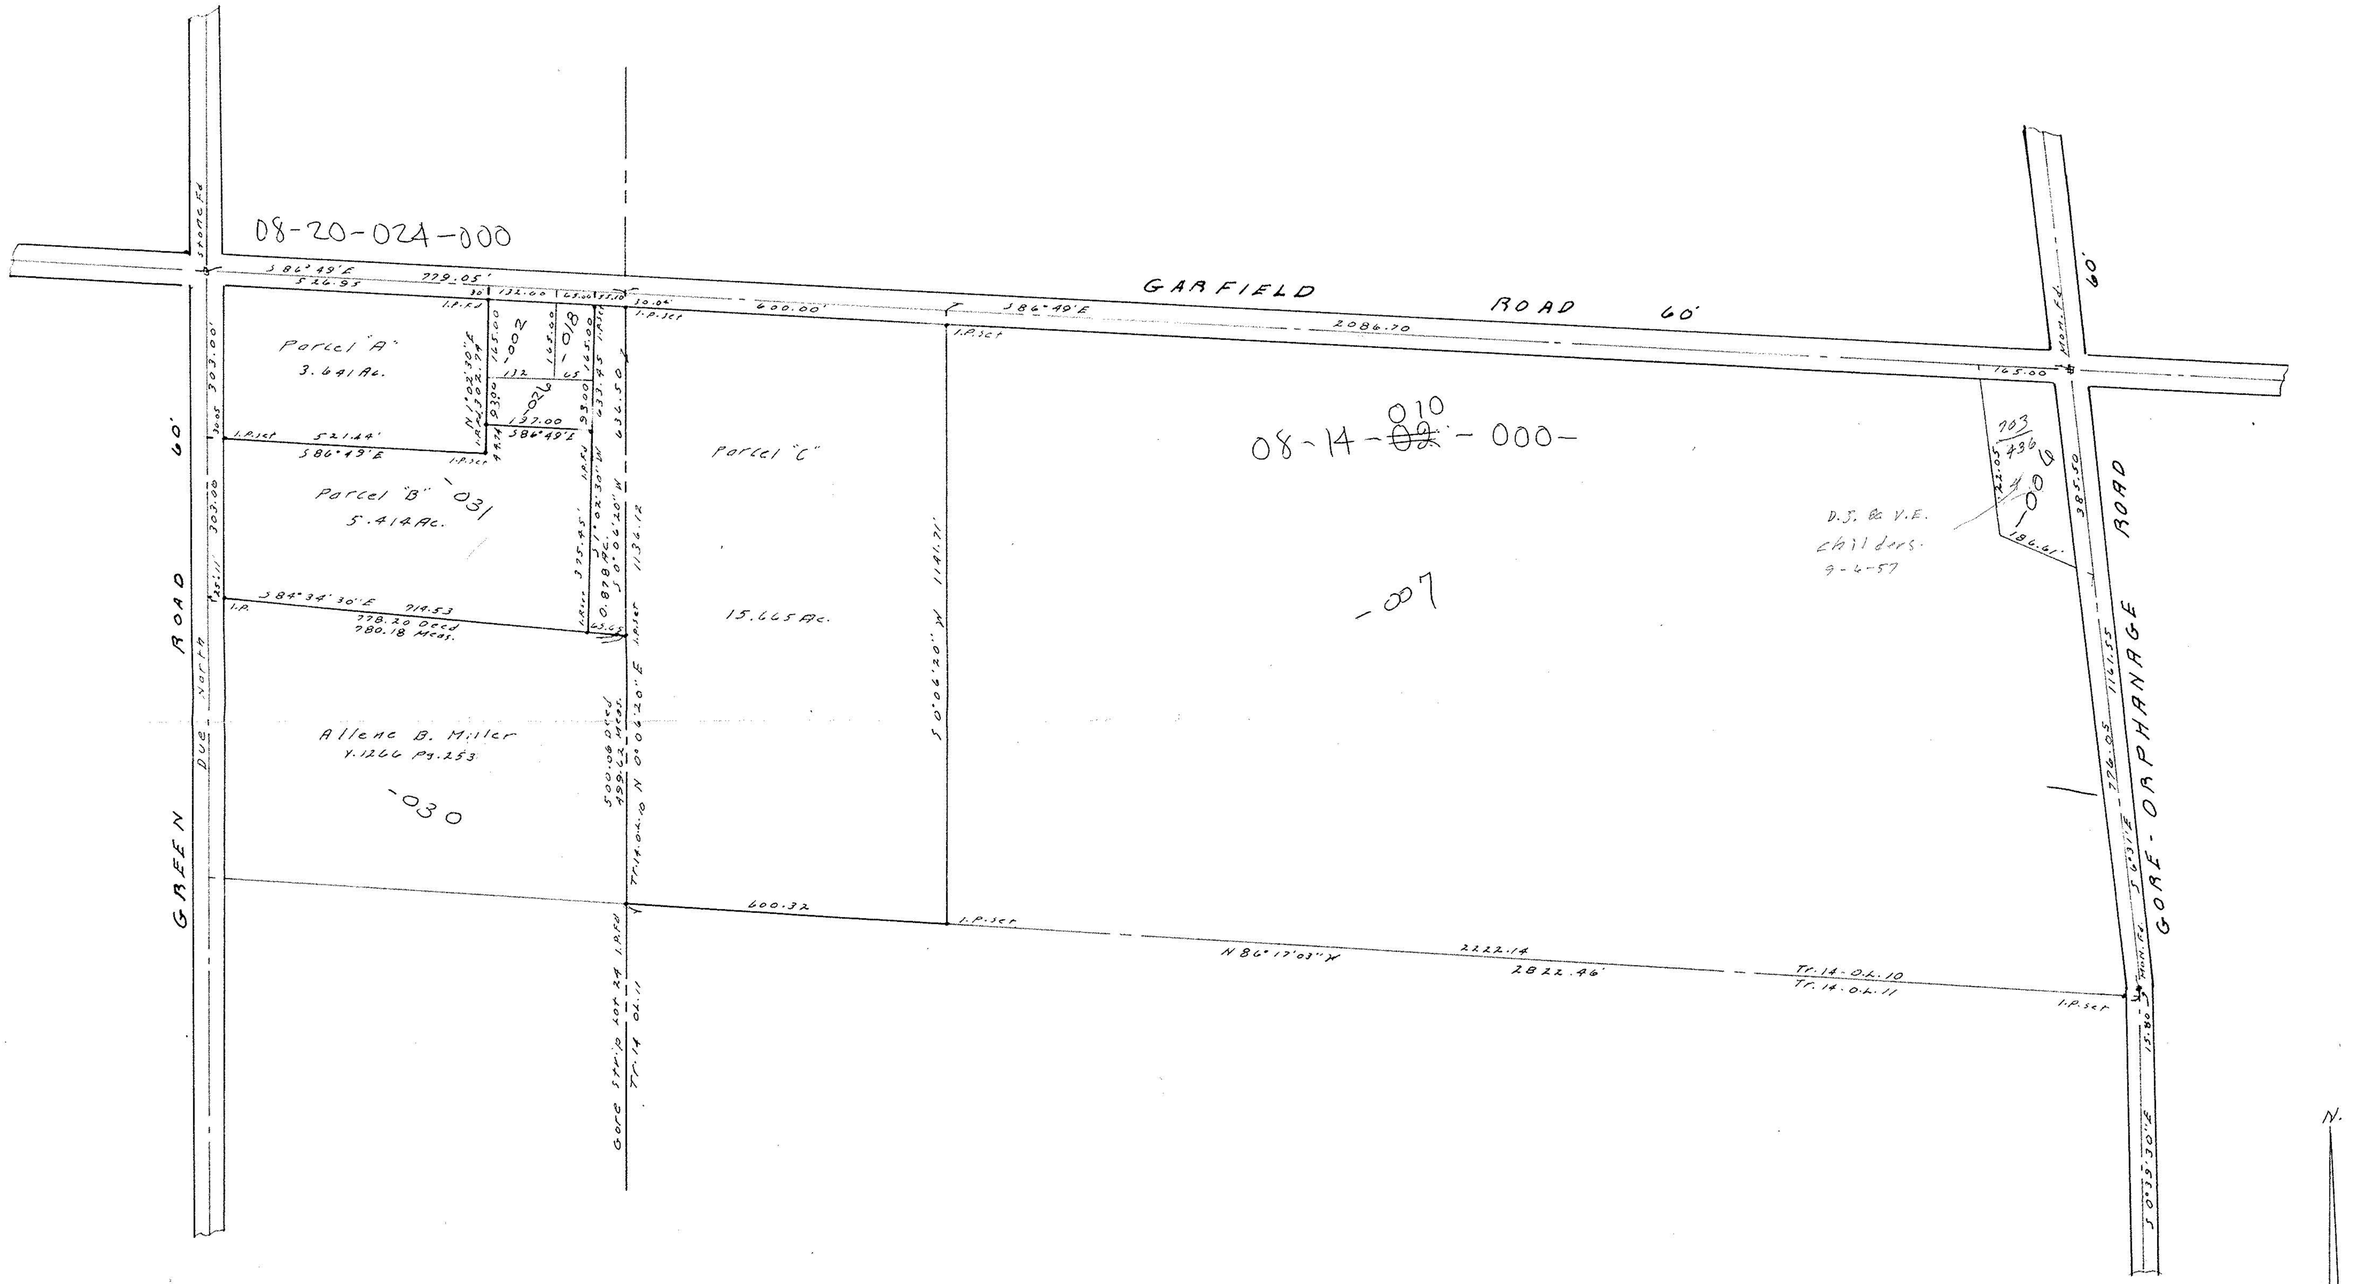

SURVEY OF

Part of O.L. No. 10 Tract No. 14 and
Part of Gore lot No. 24 of
Henrietta Township, Lorain
County Ohio. By William B. Barton
Reg. Surveyor No. 4438 April 24, 1984
Rev. 5-4-84 Scale 1" = 200'

STATE OF OHIO
WILLIAM B. BARTON
4438
REGISTERED SURVEYOR

D-2-036

08-14-024-000