


# PLAT OF SURVEY

FOR

JOHN MEDEKER

SITUATED IN THE TOWNSHIP OF HENRIETTA  
 COUNTY OF LORAIN AND STATE OF OHIO  
 AND KNOWN AS BEING PART OF ORIGINAL  
 HENRIETTA TOWNSHIP LOT 17, TRACT 15.  
 PPN 8-15-017-000-002  
 PRIOR DEED REF ORV 374 P 663

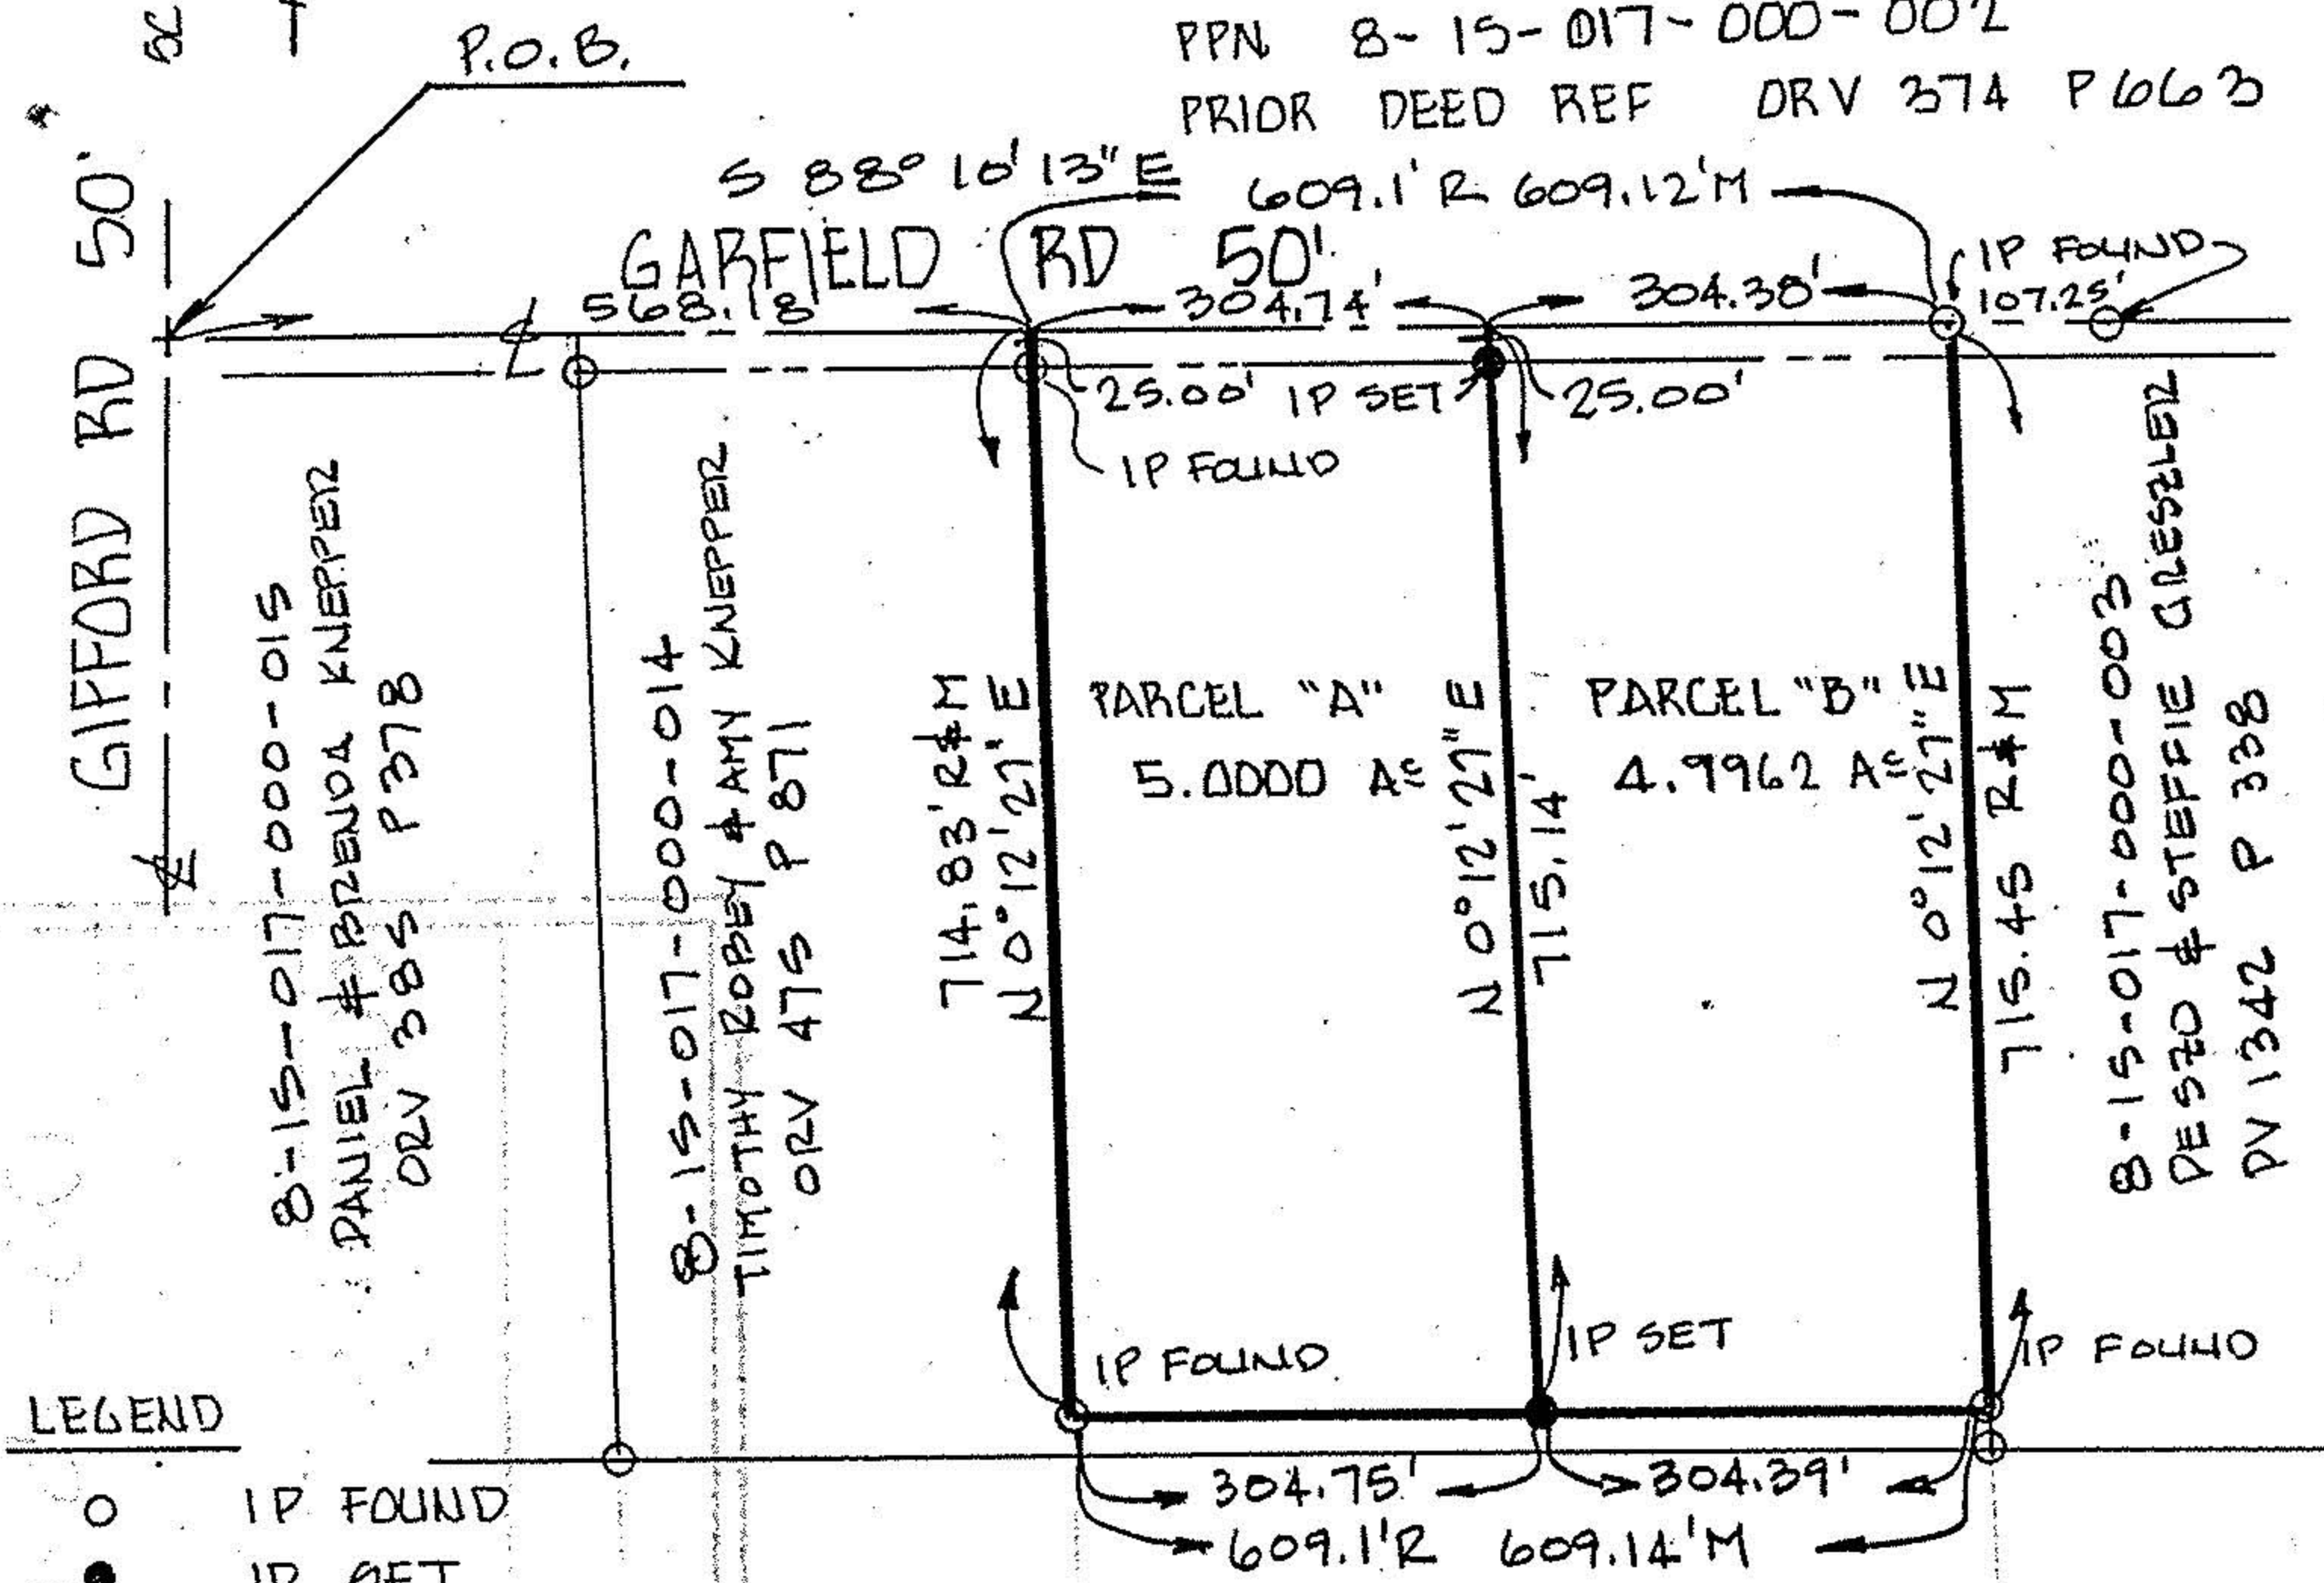

**LEGEND**

- IP FOUND
- IP SET
- R RECORD DIMENSION
- M MEASURED DIMENSION

8-15-017-000-012  
 H. A. BORN  
 ORV 143 P 239



DISTANCES ARE GIVEN IN FEET AND DECIMAL PARTS THEREOF.  
 BEARINGS ARE BASED ON AN ASSUMED MERIDIAN AND ARE USED  
 TO DESCRIBE ANGLES ONLY. IRON PIPES WERE FOUND OR  
 SET AT ALL POINTS INDICATED, ALL OF WHICH I CERTIFY TO  
 BE CORRECT TO THE BEST OF MY PROFESSIONAL KNOWLEDGE,  
 INFORMATION AND BELIEF. CERTIFIED COPIES ARE ONLY THOSE  
 SIGNED IN RED INK.

RICHARD ROSEBECK NO. 7400