

GIFFORD ROAD

GARFIELD ROAD

IRON PIV SET @ 5M COR. O.L. 17

N86°25'00"W, 1177.70

N1°33'25"E, 749.89'

N86°42'35"W, 484.55'

N3°27'45"E
25.00'

N4°05'00"E
225.00'

N86°25'00"W, 1663.00'

22.20 ACRES
- 003

N86°32'50"W, 1346.93'

N86°25'00"W, 1663.00'

N4°05'00"E 225.00'

718.87'

N3°27'45"E

O.L. 16

O.L. 14

O.L. 15

IRON PIV SET

IRON PIV SET

IRON PIV SET

IRON PIV SET

IRON PIV SET

IRON PIV SET

IRON PIV SET

IRON PIV SET

IRON PIV SET

IRON PIV SET

IRON PIV SET

FENCE REMNANTS

APPROVED
LORAIN CO.
MAP DEPT.

DATE 6-11-93

PAGE 8-H

BY *J. H. Hurler*

VOID AFTER 118092A

07-77

1617
6-11-93
Does Not Close


#18092A

ACREAGE 22.20

DATE MAR 22-82

SCALE 1" = 300 FT.

DRAWN MGH

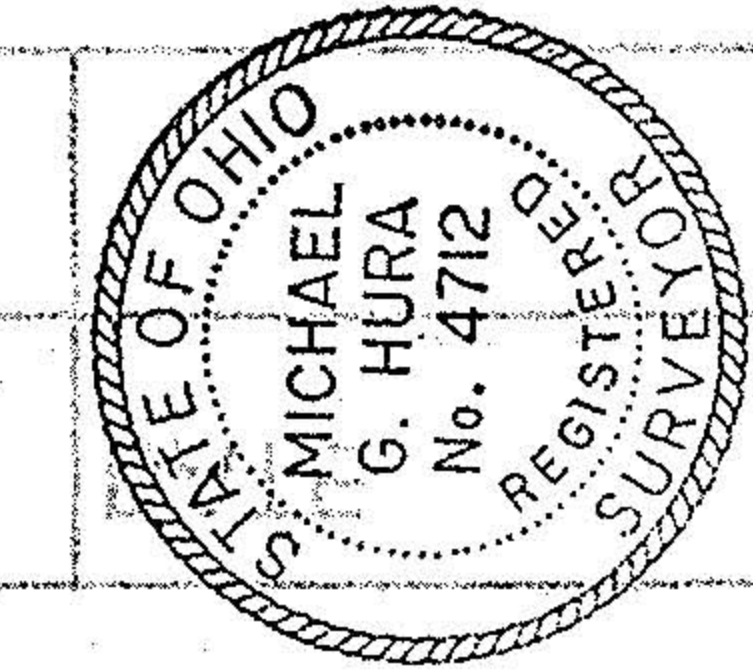

Michael G. Hura and Associates
3409 LIBERTY AVENUE
VERMILION, OHIO

PERIMETER SURVEY

PART OF O.L. 17 TR. 15 SECTION OF
HENRIETTA Township LORAIN County, Ohio
SUBLOT of VOL. PAGE OF PLATS

PERMANENT PARCEL NO.
08-15-017-000-003