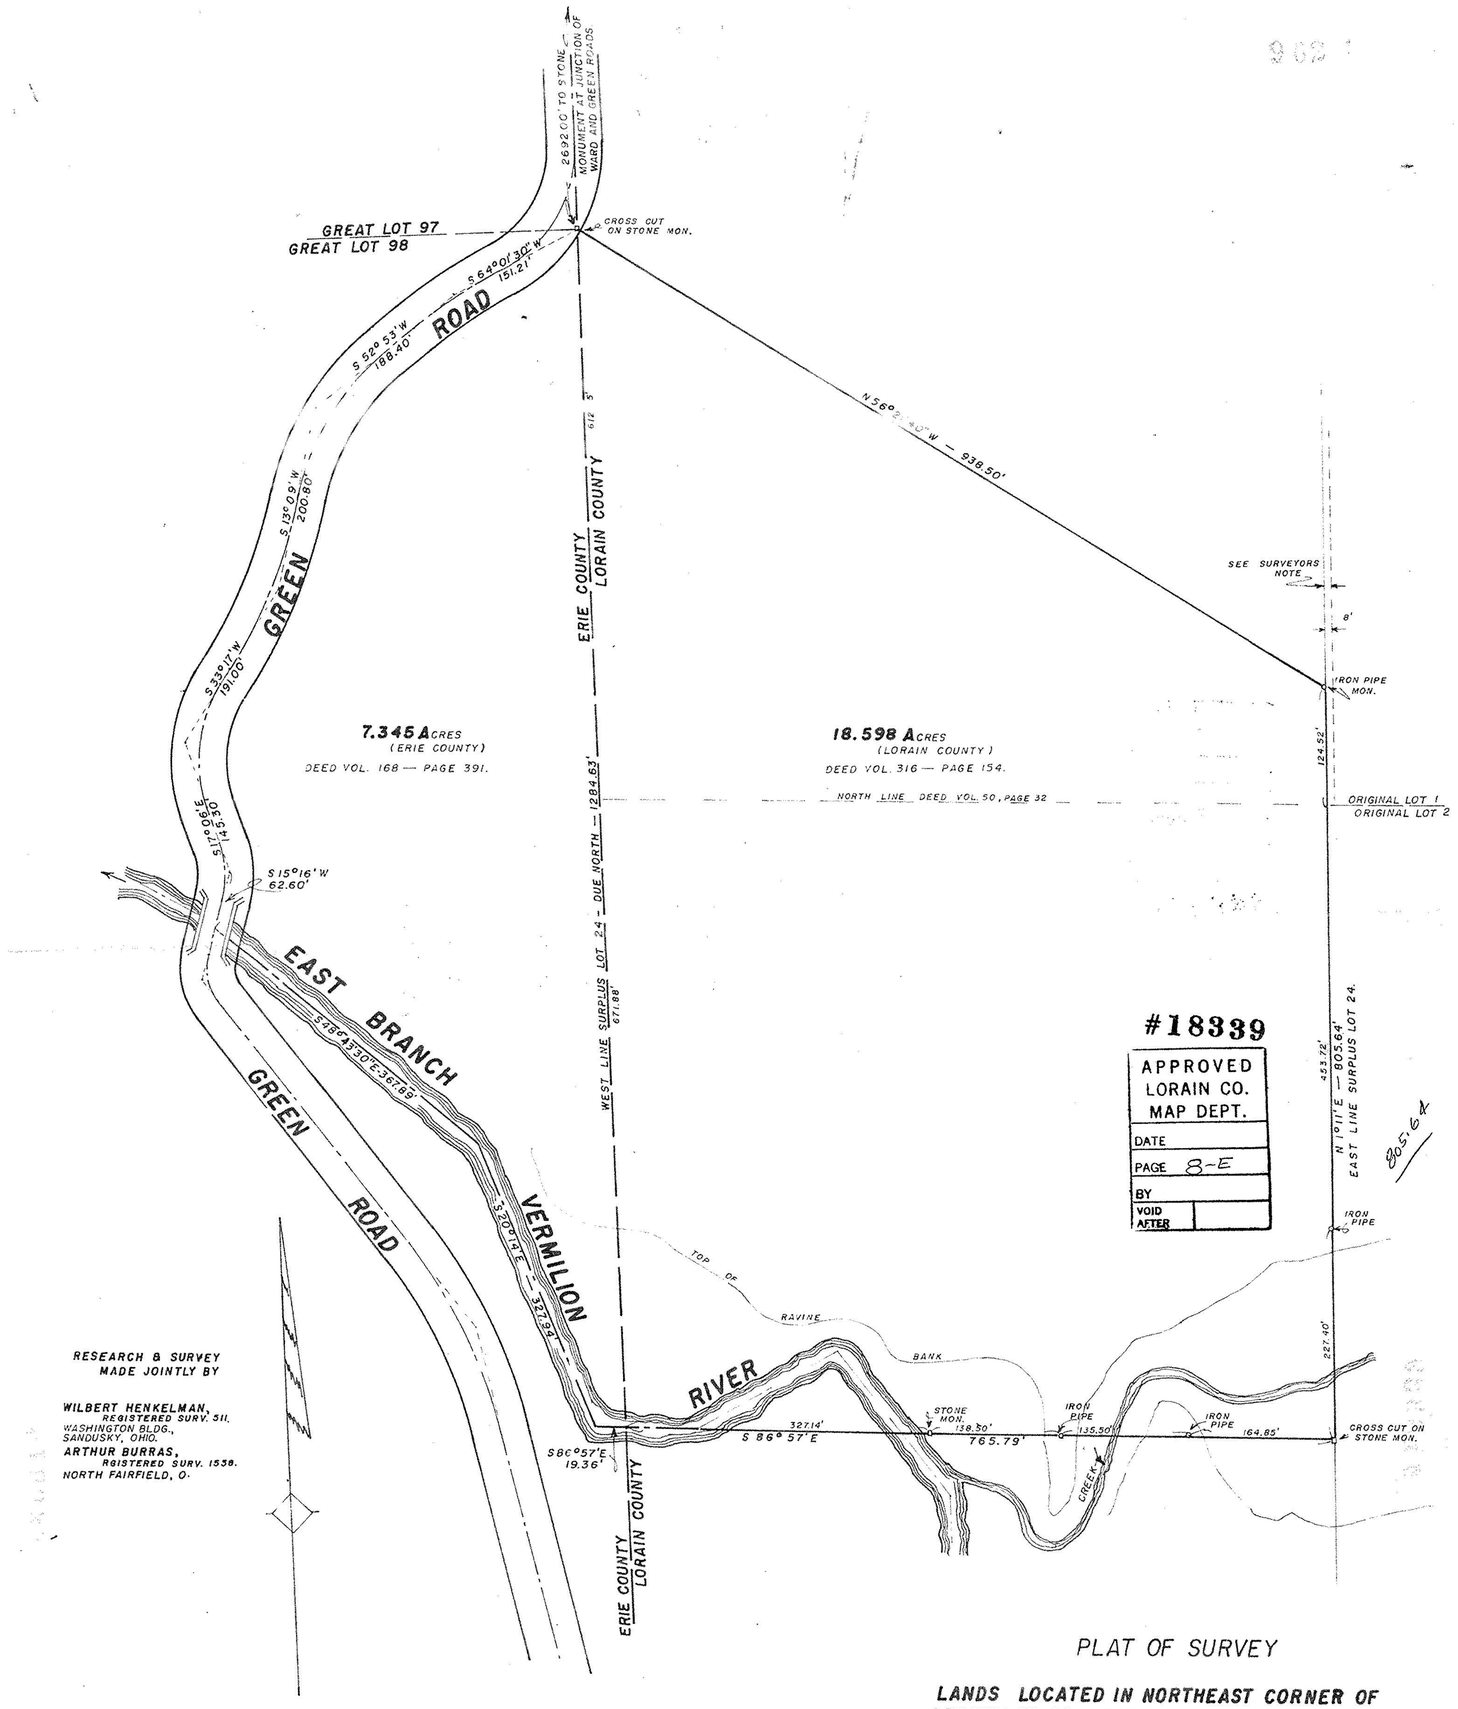

#18339

APPROVED LORAIN CO. MAP DEPT.
DATE
PAGE 8-E
BY
VOID AFTER

RESEARCH & SURVEY MADE JOINTLY BY

WILBERT HENKELMAN,
REGISTERED SURV. 511.
WASHINGTON BLDG.,
SANDUSKY, OHIO.

ARTHUR BURRAS,
REGISTERED SURV. 1538.
NORTH FAIRFIELD, O.

SCALE 1" = 100'

APRIL 22 1961

SURVEYORS NOTE:

I CERTIFY THAT AFTER SURVEYING THE EAST LINE OF SURPLUS LOT 24, LOCATING EXISTING OCCUPATION AND MONUMENTS HERE-TO-FORE SET, I FIND NO APPARENT EXISTANCE OF AN 8' OFFSET IN THE PROPERTY LINE AS MENTIONED DEEDS RECORDED IN VOL. 316, PAGE 154 AND VOL. 30 PAGE 601 — LORAIN CO. RECORD OF DEEDS.

SIGNED Arthur H. Burras.
REGISTERED SURVEYOR.

PLAT OF SURVEY

LANDS LOCATED IN NORTHEAST CORNER OF GREAT LOT 98, SECTION 1, FLORENCE TWP., ERIE COUNTY, OHIO

— AND —

CENTRAL PART SURPLUS LOT 24, TRACT 13, OF HENRIETTA TWP., LORAIN COUNTY, OHIO.

— FOR —

BOY SCOUTS OF AMERICA

FIRELANDS AREA COUNCIL, INC.

MAP OF SURVEY FOR"

FIRELANDS AREA COUNCIL, INC.
BOY SCOUTS OF AMERICA

PART SURPLUS LOT 24 GORE STRIP — TRACT 13
HENRIETTA TOWNSHIP — LORAIN COUNTY, OHIO
MARCH 1989 — SCALE 1"=100'

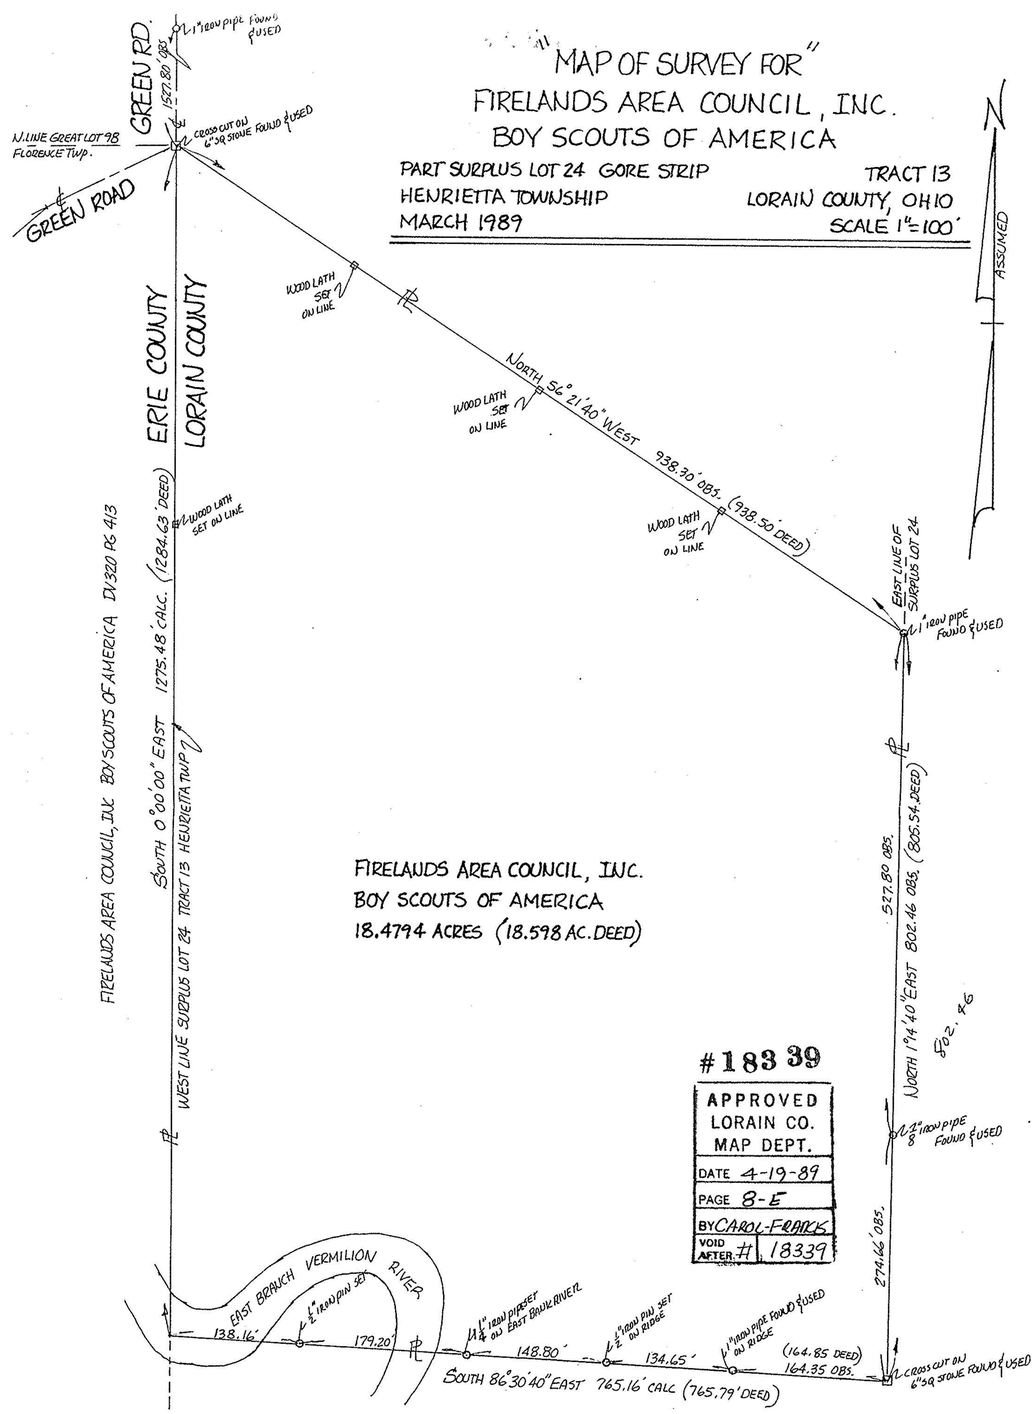

#18339

APPROVED LORAIN CO. MAP DEPT.
DATE 4-19-89
PAGE 8-E
BY CAROL FRANKS
VOID AFTER # 18339

FIRELANDS AREA COUNCIL, INC.
BOY SCOUTS OF AMERICA
18.4794 ACRES (18.598 AC. DEED)

0' 50' 100' 200' 300'

STATE OF OHIO
DANIEL EDWARD HARTUNG, Jr.
5667
REGISTERED
SURVEYOR

I HEREBY CERTIFY THE WITHIN TO BE A TRUE REPRESENTATION OF A SURVEY MADE BY ME.

Daniel E. Hartung Jr.

DANIEL E. HARTUNG JR, PE, PS
PROFESSIONAL ENGINEER & SURVEYOR
321 OHIO STREET
HURON, OHIO 44839