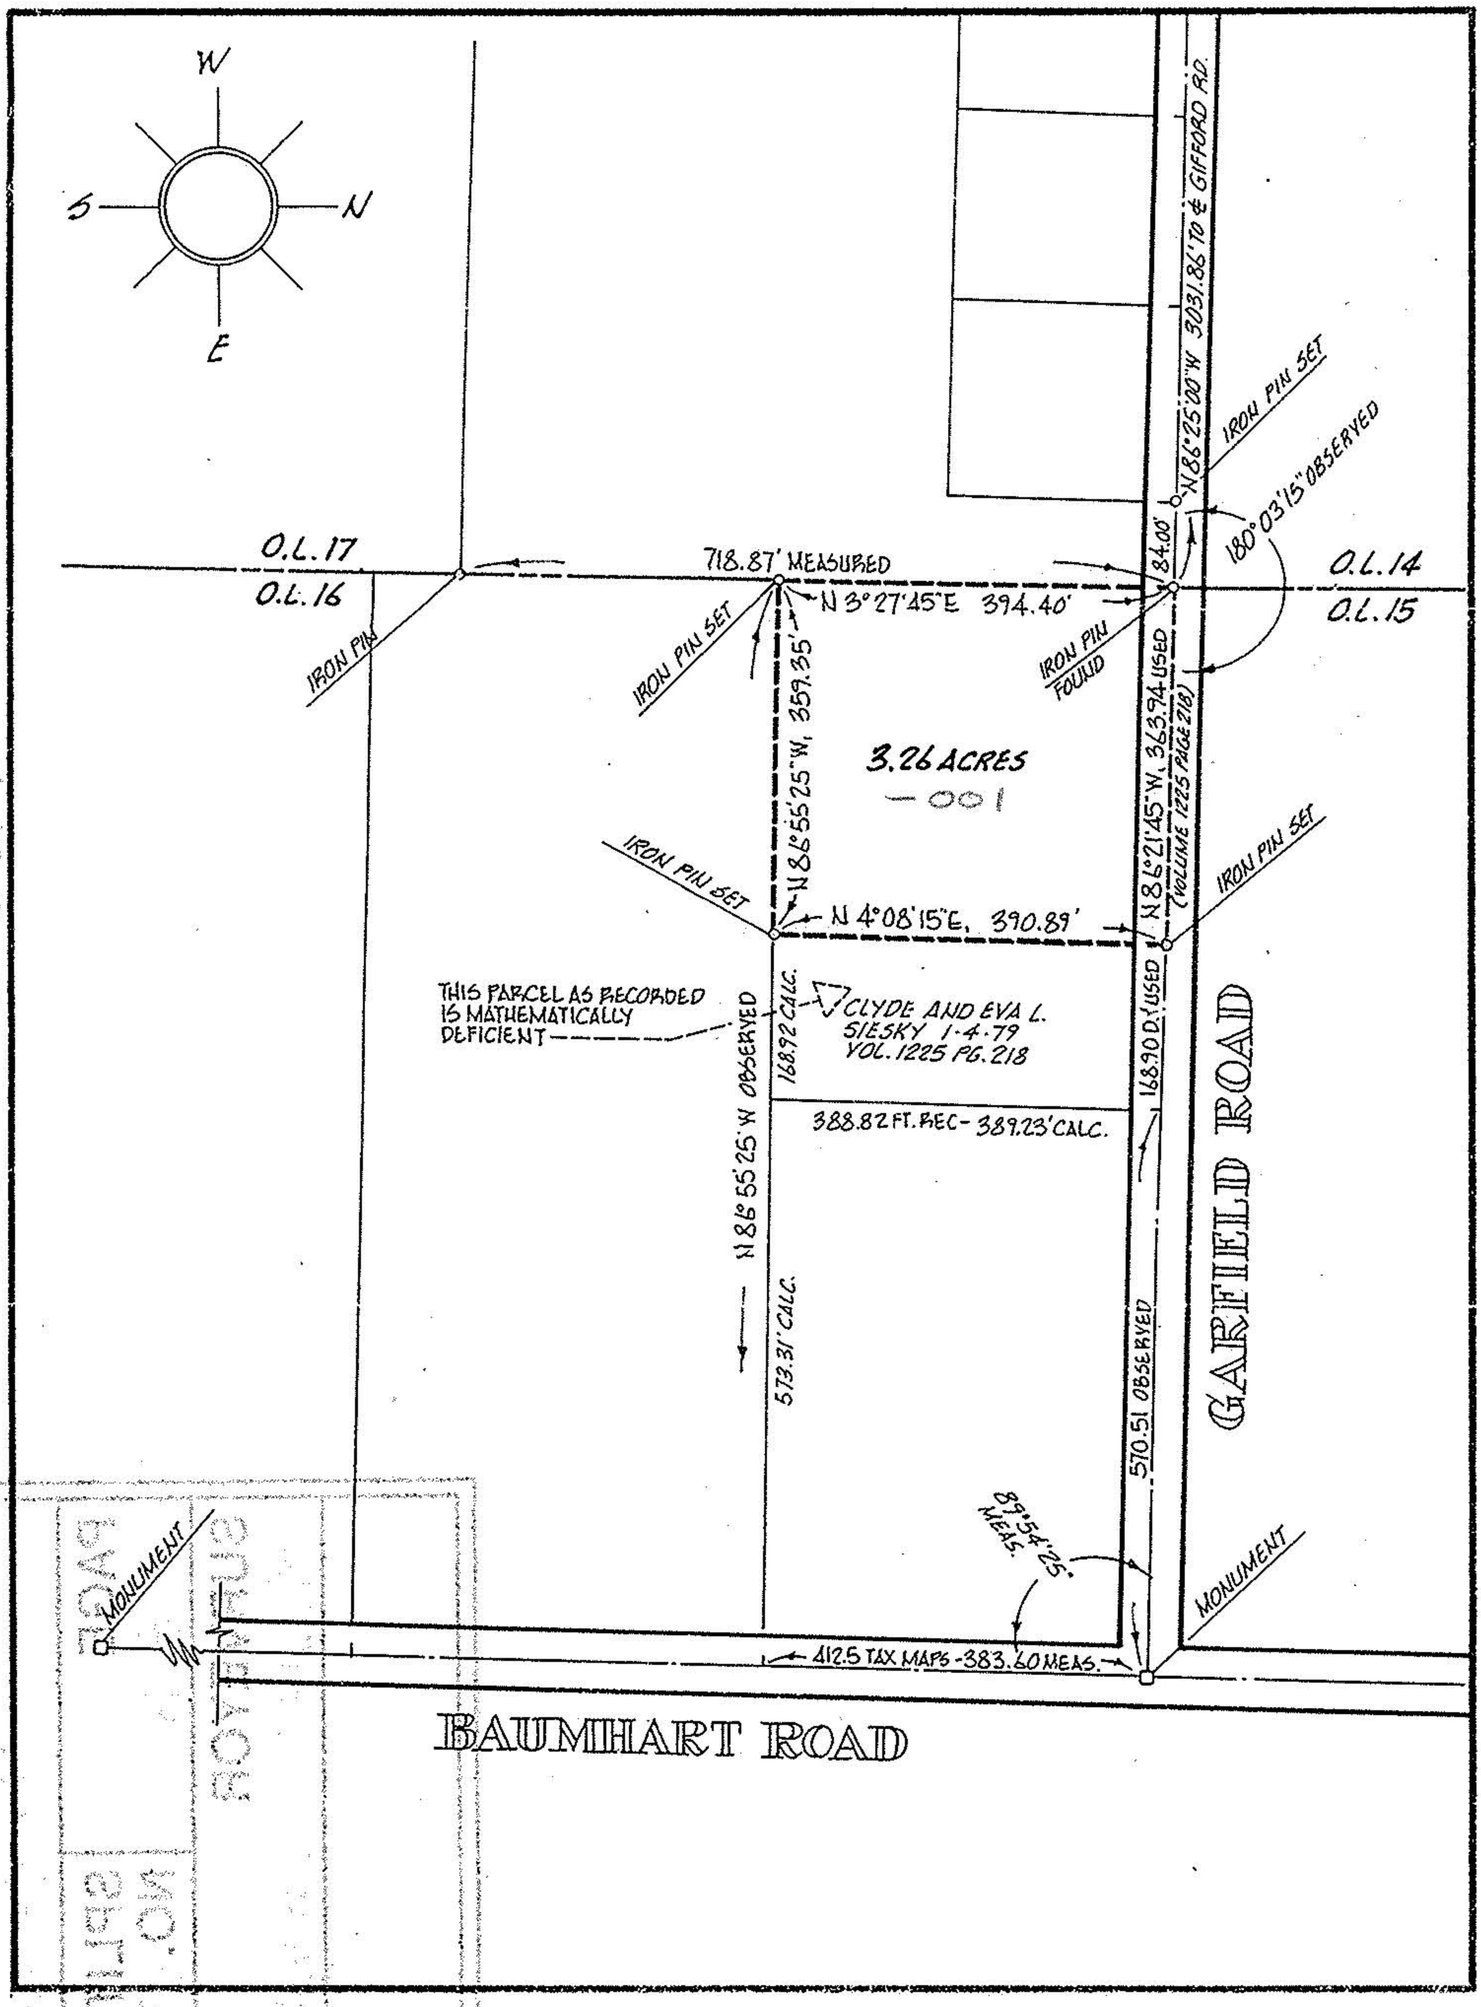

ACREAGE 3.26	DATE MAR 82	SCALE 1" = 200 FT.	DRAWN MGH

STATE OF OHIO
MICHAEL G. HURA
No. 4712
REGISTERED SURVEYOR

Michael G. Hura and Associates
3409 LIBERTY AVENUE VERMILION, OHIO

PERIMETER SURVEY

PART OF O.L. 16 TR. 15 SECTION ____ OF
HENRIETTA Township LORAIN County, Ohio
SUBLOT ____ of ____
____ VOL. ____ PAGE ____ OF PLATS

PERMANENT PARCEL NO. 08-15-016-000-001