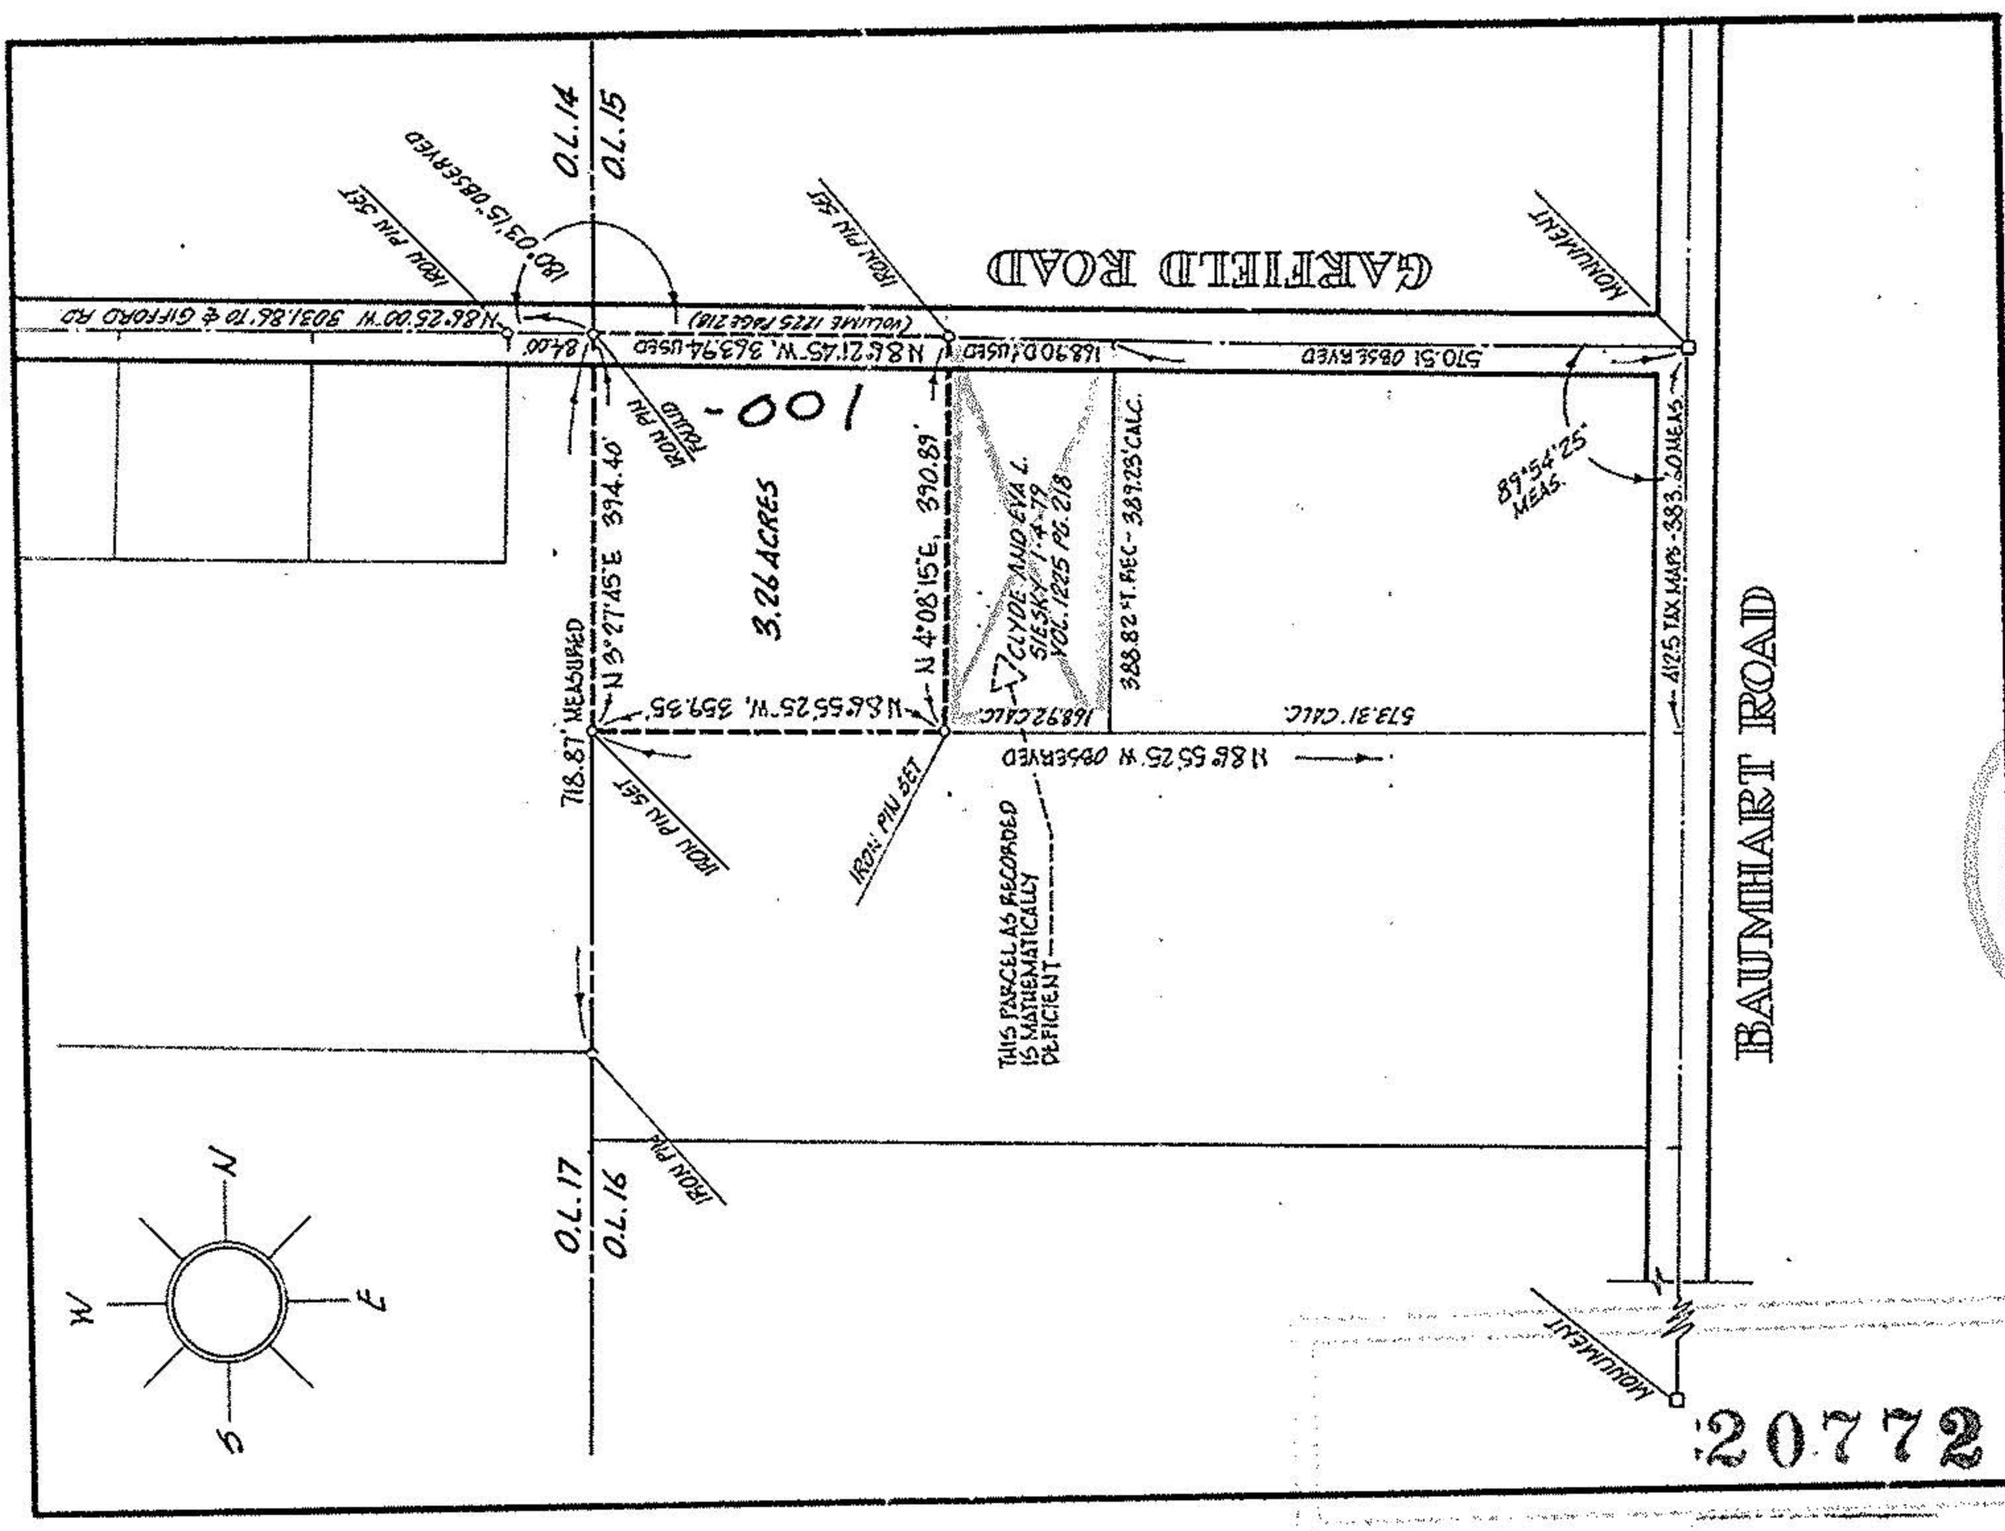

PERMANENT PARCEL NO.
08-15-016-000-001

DATE MAR 82 | SCALE 1" = 200 FT. | DRAWN MGH

Michael G. Hura and Associates
3409 LIBERTY AVENUE VERMILION, OHIO

PERIMETER SURVEY

PART OF O.L. 16 TR. 15 SECTION ___ OF HENRIETTA Township LORAIN County, Ohio
SUBLOT ___ of ___ VOL. ___ PAGE ___ OF PLATS

ACREAGE 3.26

STATE OF OHIO
MICHAEL G. HURA
No. 4712
REGISTERED SURVEYOR

08-15-016-000-

APPROVED
LORAIN CO.
MAP DEPT.
DATE 3-18-94
PAGE 8-H
BY CAROLYN FRANCIS
VOID AFTER # 20772