

MAP OF
LOT SPLITS
PREPARED FOR
HOWARD BORN

SPLIT FROM PPN 8-15-015-000-00
PRIOR DEED REF - ORV 553, P 948

JEAN COUET WESTON
ORV 320 P 804

SITUATED IN THE TOWNSHIP OF HENRIETTA,
COUNTY OF LORAIN & STATE OF OHIO &
KNOWN AS BEING PART OF ORIGINAL
HENRIETTA TOWNSHIP LOT 15, TRACT 15

9-00-041-000-001

BERLEY MINNEY
ORV 176 P 866
9-00-051-000-005


8-15-006-000-010
PEZSO & JANET
SARBACK
ORV 103 P 501

Russia Twp.
HENRIETTA Twp
O.L. 6

STONE FOUND

RAILROAD
SPIKE SET

I.P. FOUND & USED

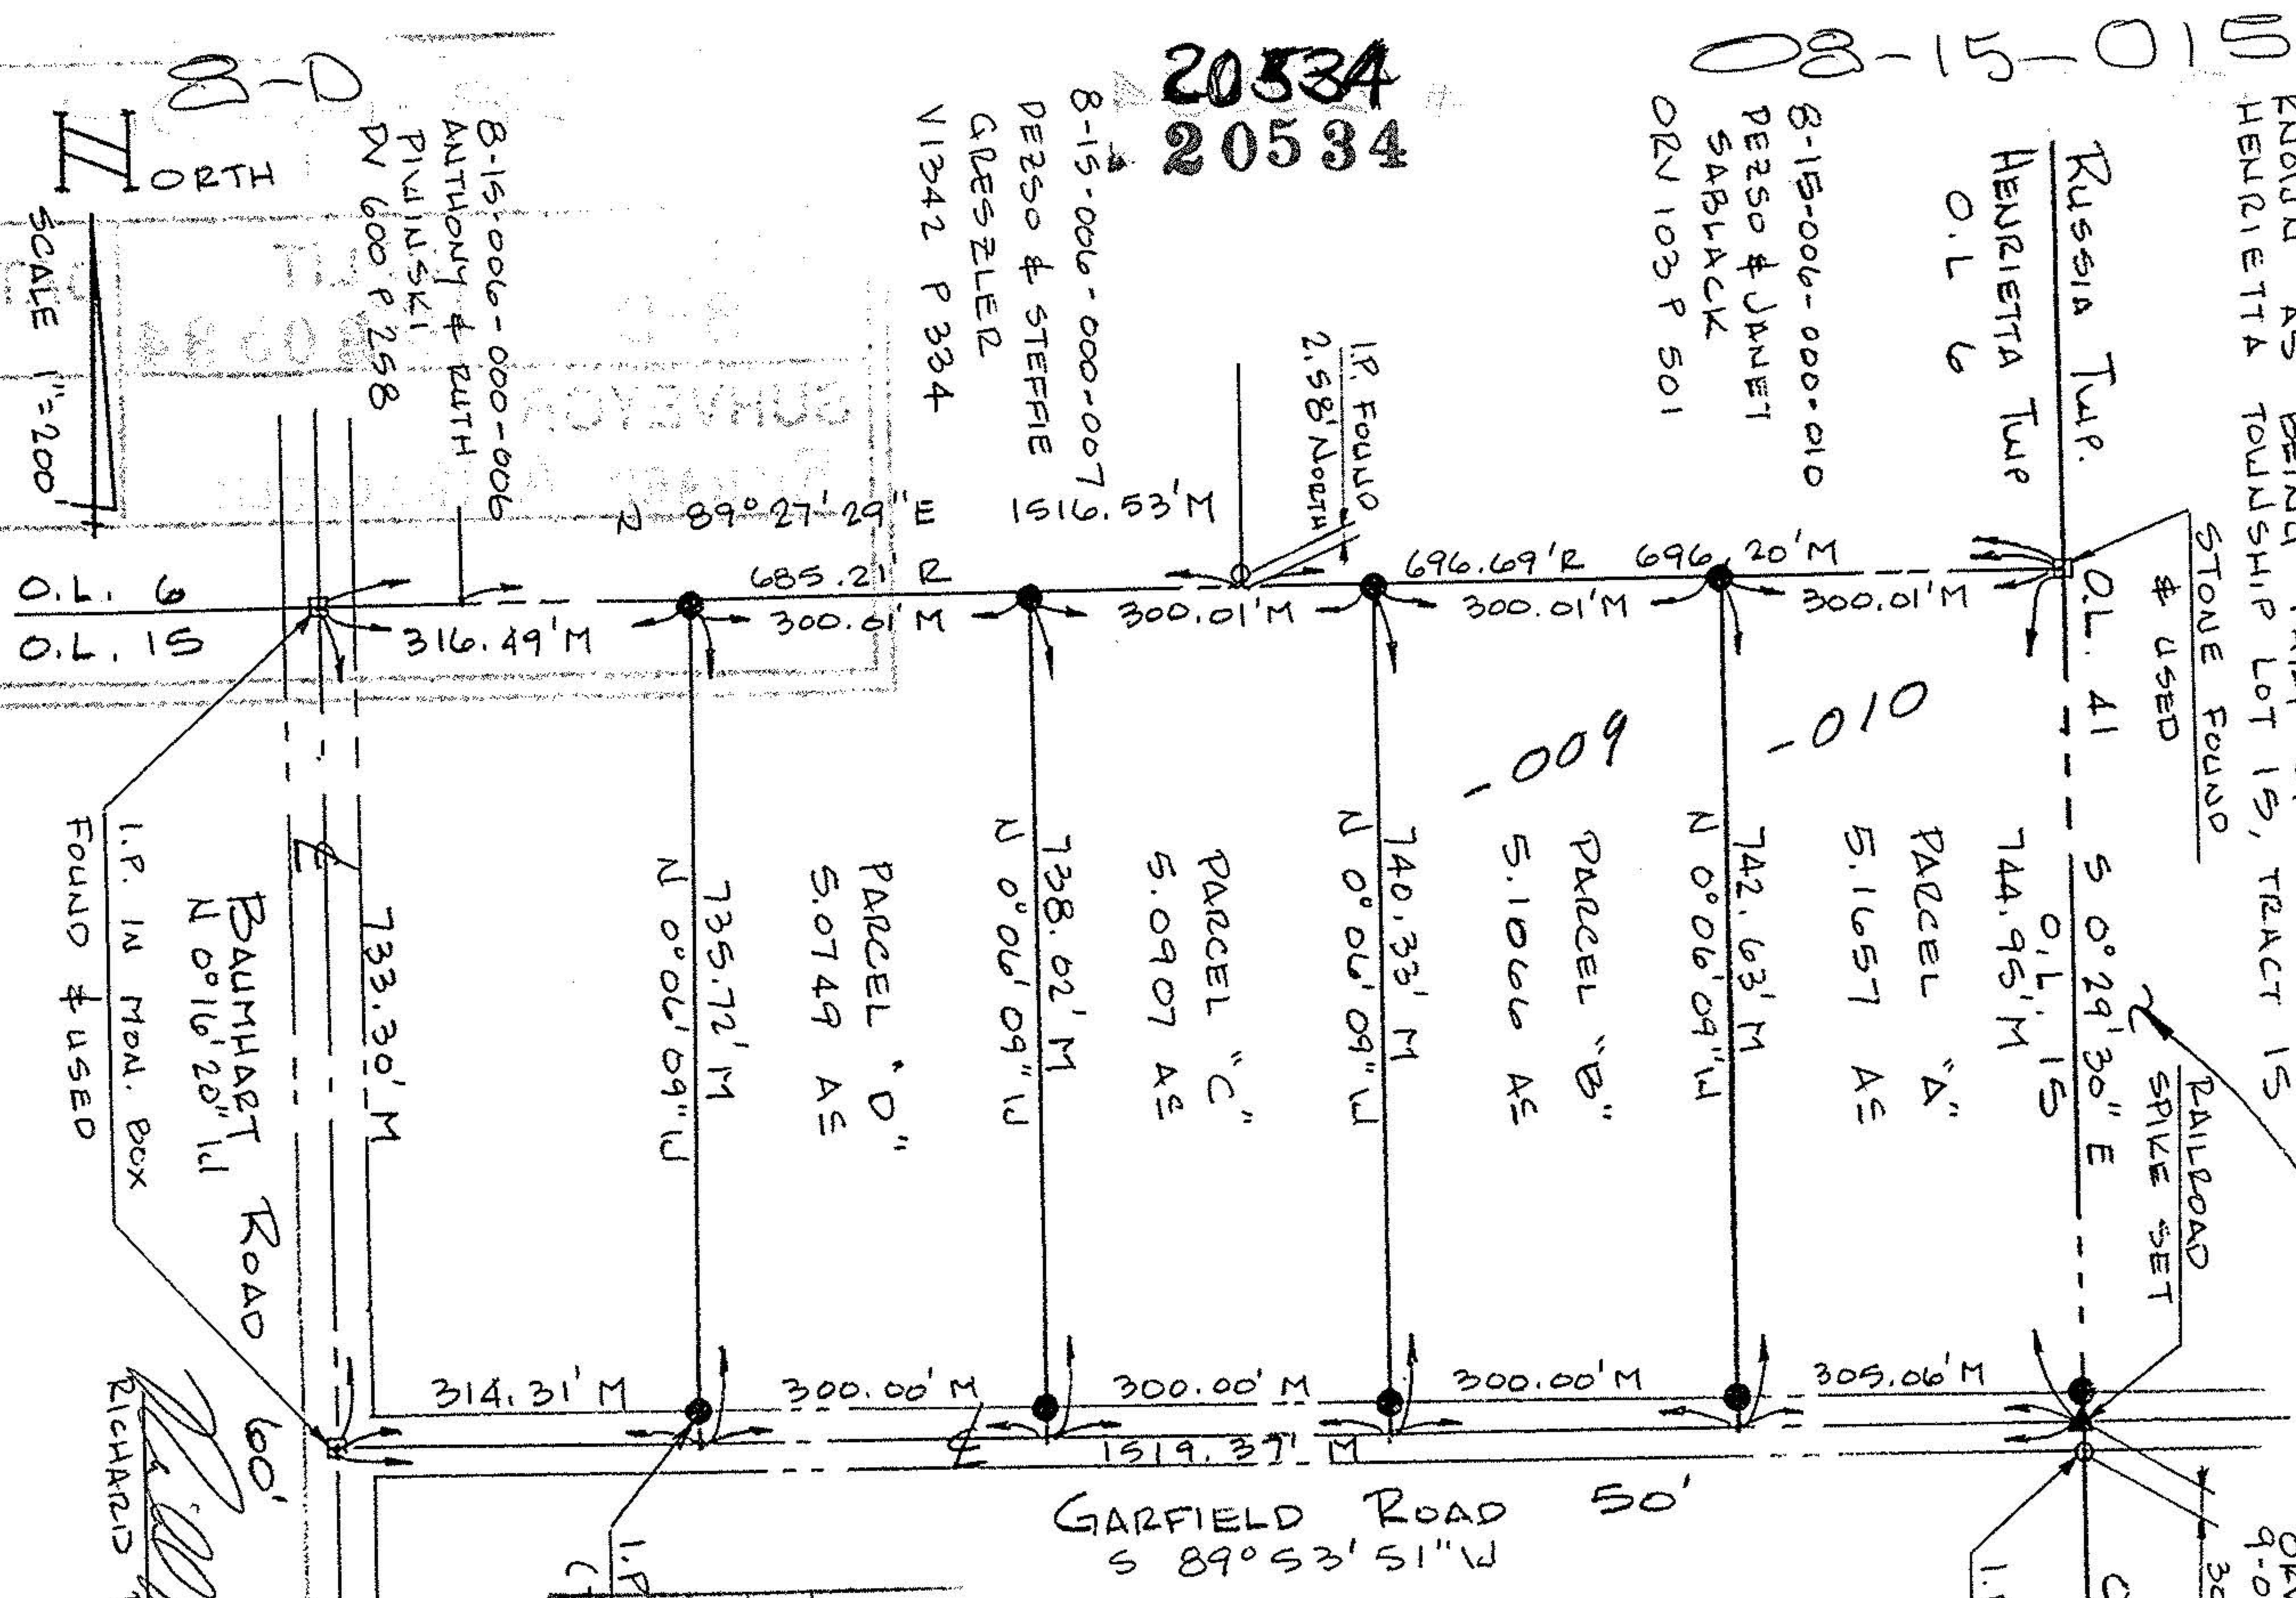

20534
20534

8-15-006-000-007
PEZSO & STEFFIE
GRESZLER
V1342 P 334

8-15-006-000-006
ANTHONY & RUTH
PIVINSKI
DV 600 P 258

SCALE 1"=200'

DISTANCES ARE GIVEN IN FEET & DECIMAL PARTS
THEREOF. BEARINGS ARE REFERENCED TO AN
ASSUMED MERIDIAN & ARE GIVEN FOR THE PURPOSE
OF DESCRIBING ANGLES ONLY. MONUMENTS WERE
FOUND OR SET AT ALL POINTS INDICATED, ALL OF
WHICH I CERTIFY TO BE CORRECT TO THE BEST
OF MY PROFESSIONAL KNOWLEDGE, INFORMATION &
BELIEF. CERTIFIED COPIES ARE ONLY THOSE
SIGNED IN RED INK.

GARFIELD ROAD 50'
 $S 89^{\circ} 53' 51'' W$

BAUMHART ROAD 60'
I.P. IN Mon. Box
FOUND & USED

APPROVED	20534
LORAIN CO.	
MAP DEPT.	
DATE 9-30-93	
PAGE 8-D	
BY CHADWIN	
BY BET FRANCIS	
YOUR FILE # (20534)	

RICHARD ROSEBECK #7400

