
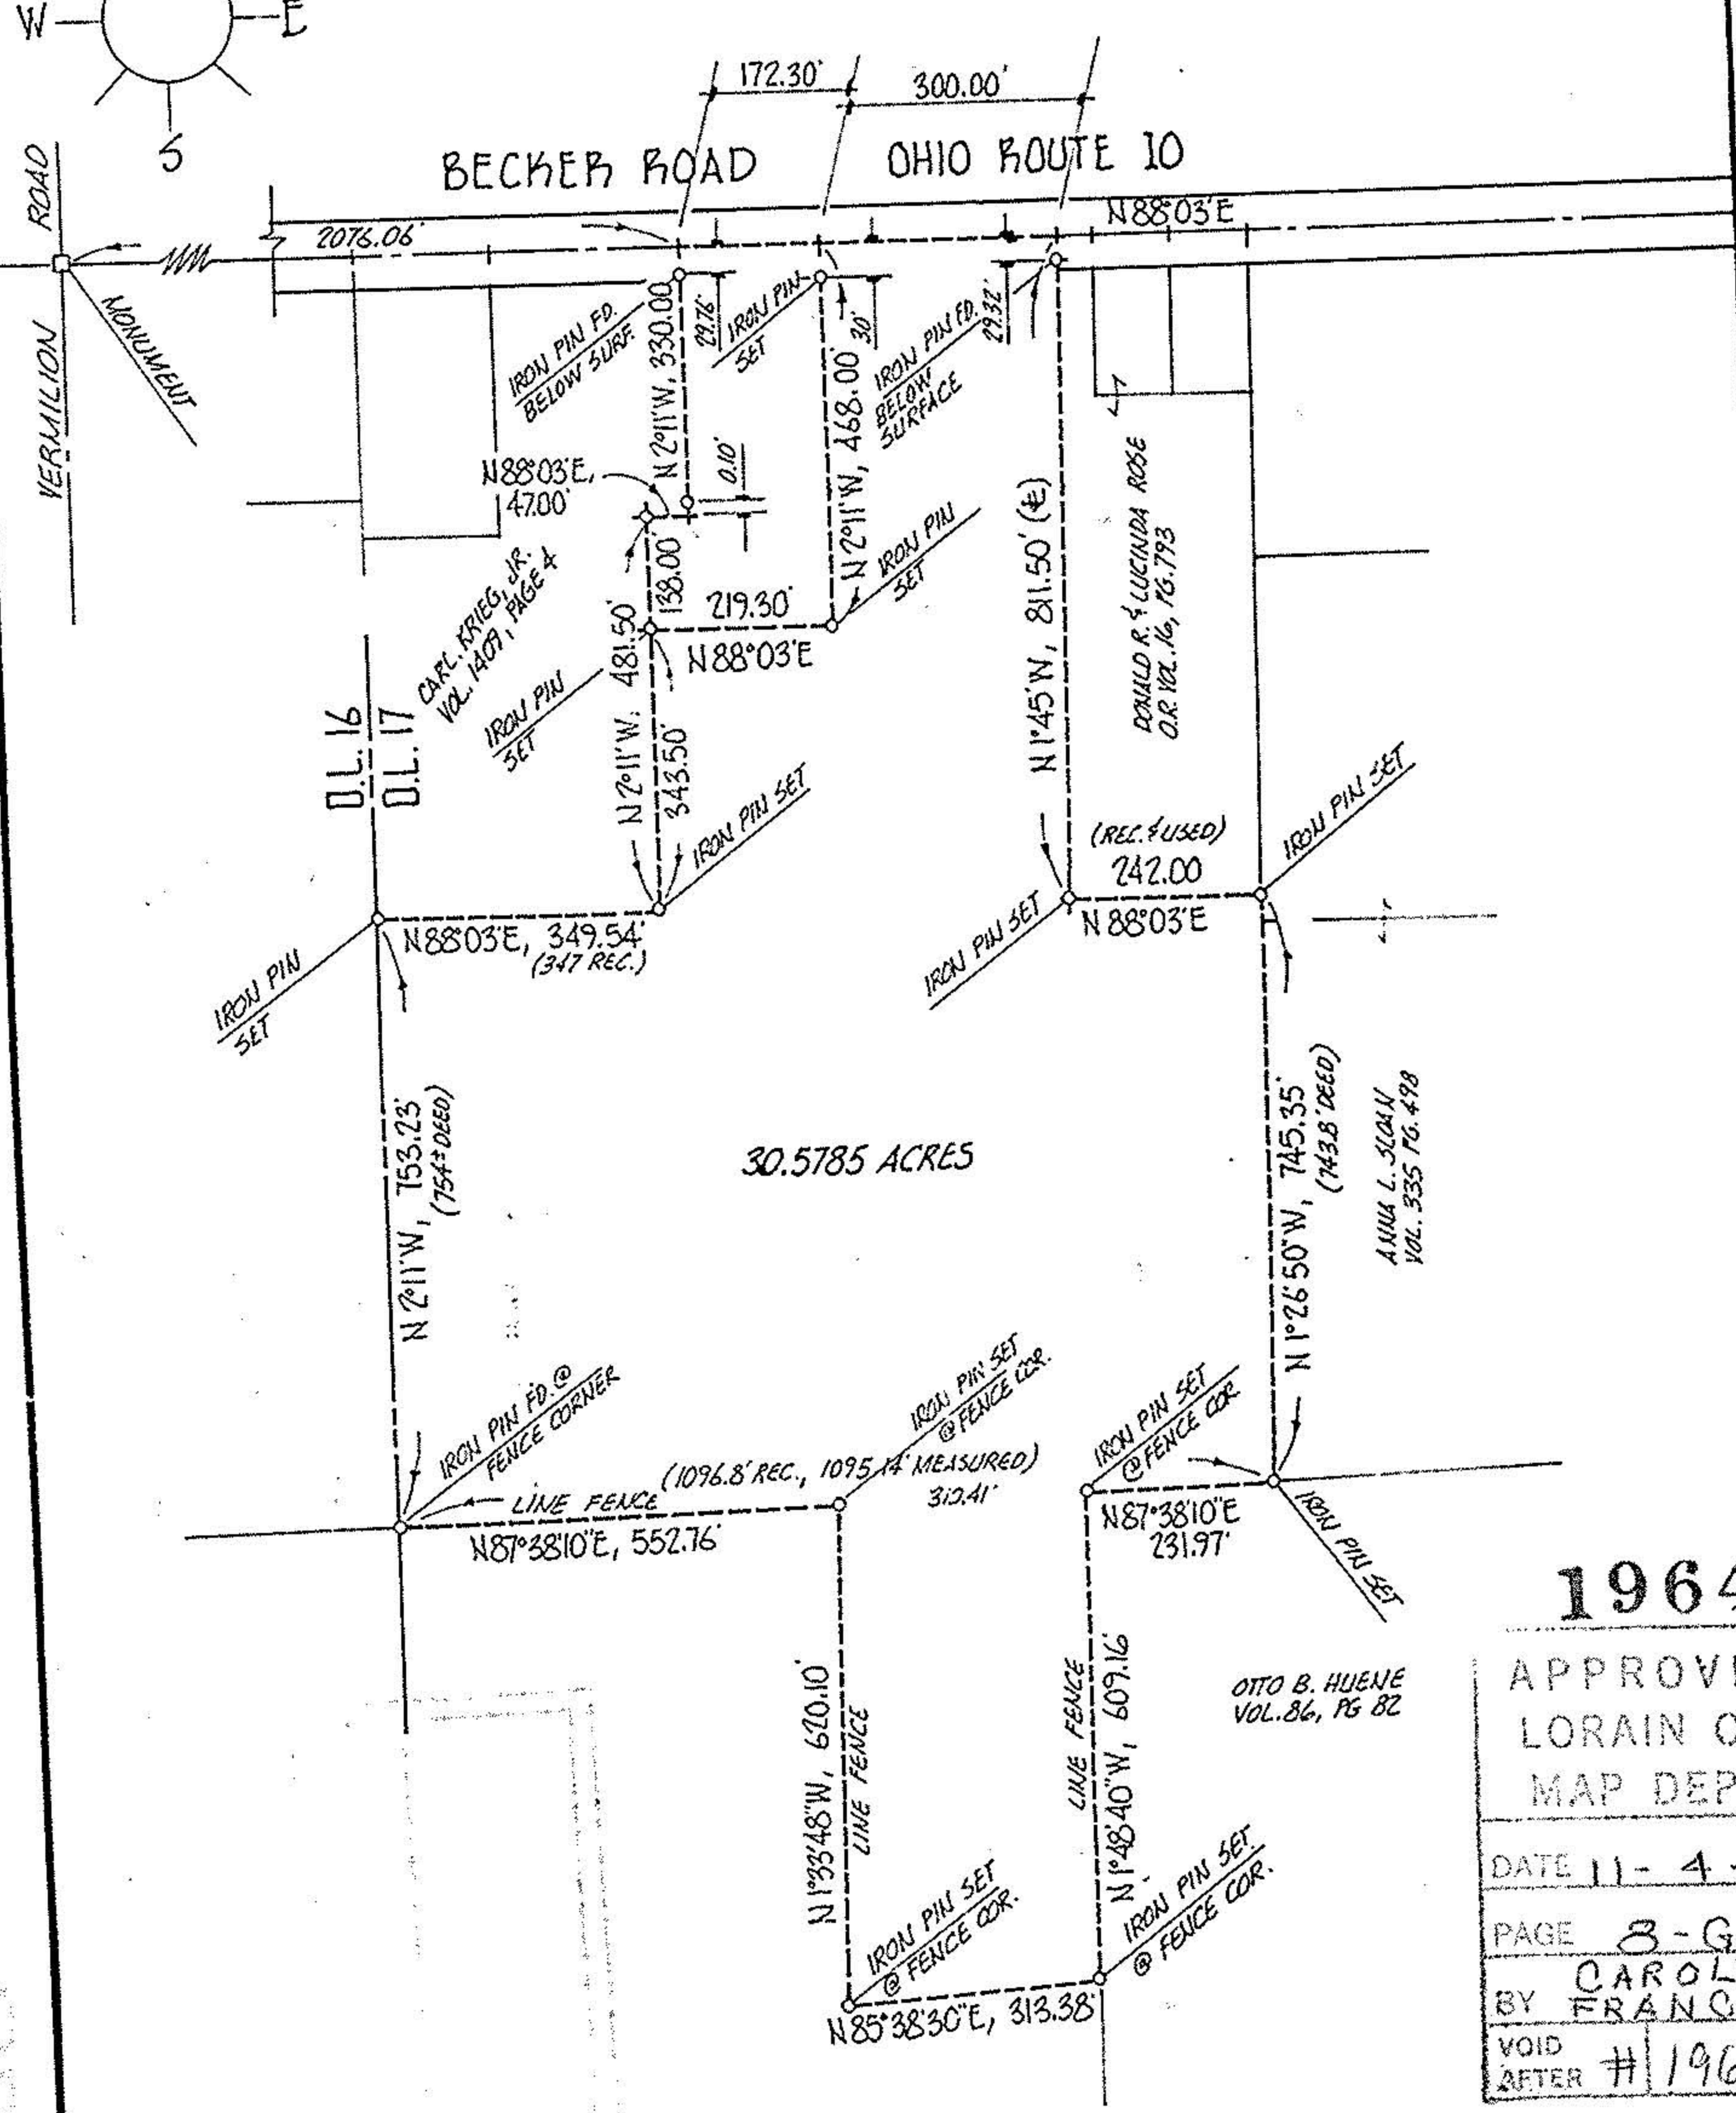
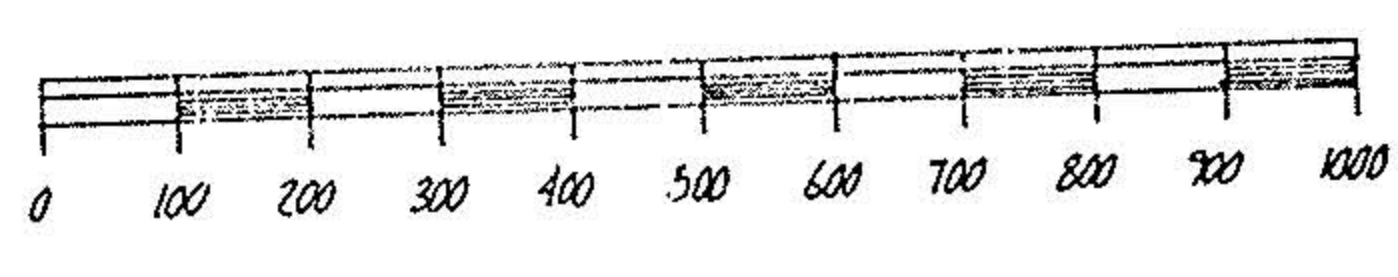


19644  
 08-12-017-000-032  
 1.00 AC.

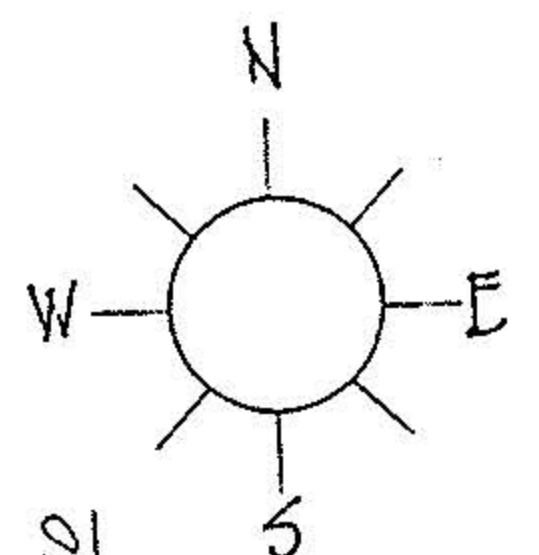

30.5785 ACRES

19644

APPROVED  
 LORAIN CO.  
 MAP DEPT.  
 DATE 11-4-91  
 PAGE 8-G  
 BY CAROLYN FRANCIS  
 VOID AFTER # 19644

ACREAGE 30.5785  
 DATE OCT-91  
 DRAWN MGH  
 SCALE 1" = 300 ft.

PREPARED FOR MARGARET COATES  
 RTE. 10, BECKER ROAD, AMHERST

MICHAEL G. HURA registered surveyor  
 12706 MASON ROAD, VERMILION, OHIO [216] 965-4040

CITY OF



PERIMETER SURVEY

SUBLOT \_\_\_\_\_ OF \_\_\_\_\_  
 \_\_\_\_\_ Volume \_\_\_\_\_ Page \_\_\_\_\_ of PLATS  
 PART OF O.L. 17 TRACT 12 SECTION \_\_\_\_\_ OF  
 HENRIETTA TOWNSHIP LORAIN CO., OHIO  
 Perm. Parcel No. \_\_\_\_\_ Ref. deed: Vol. 1114 Pg. 289