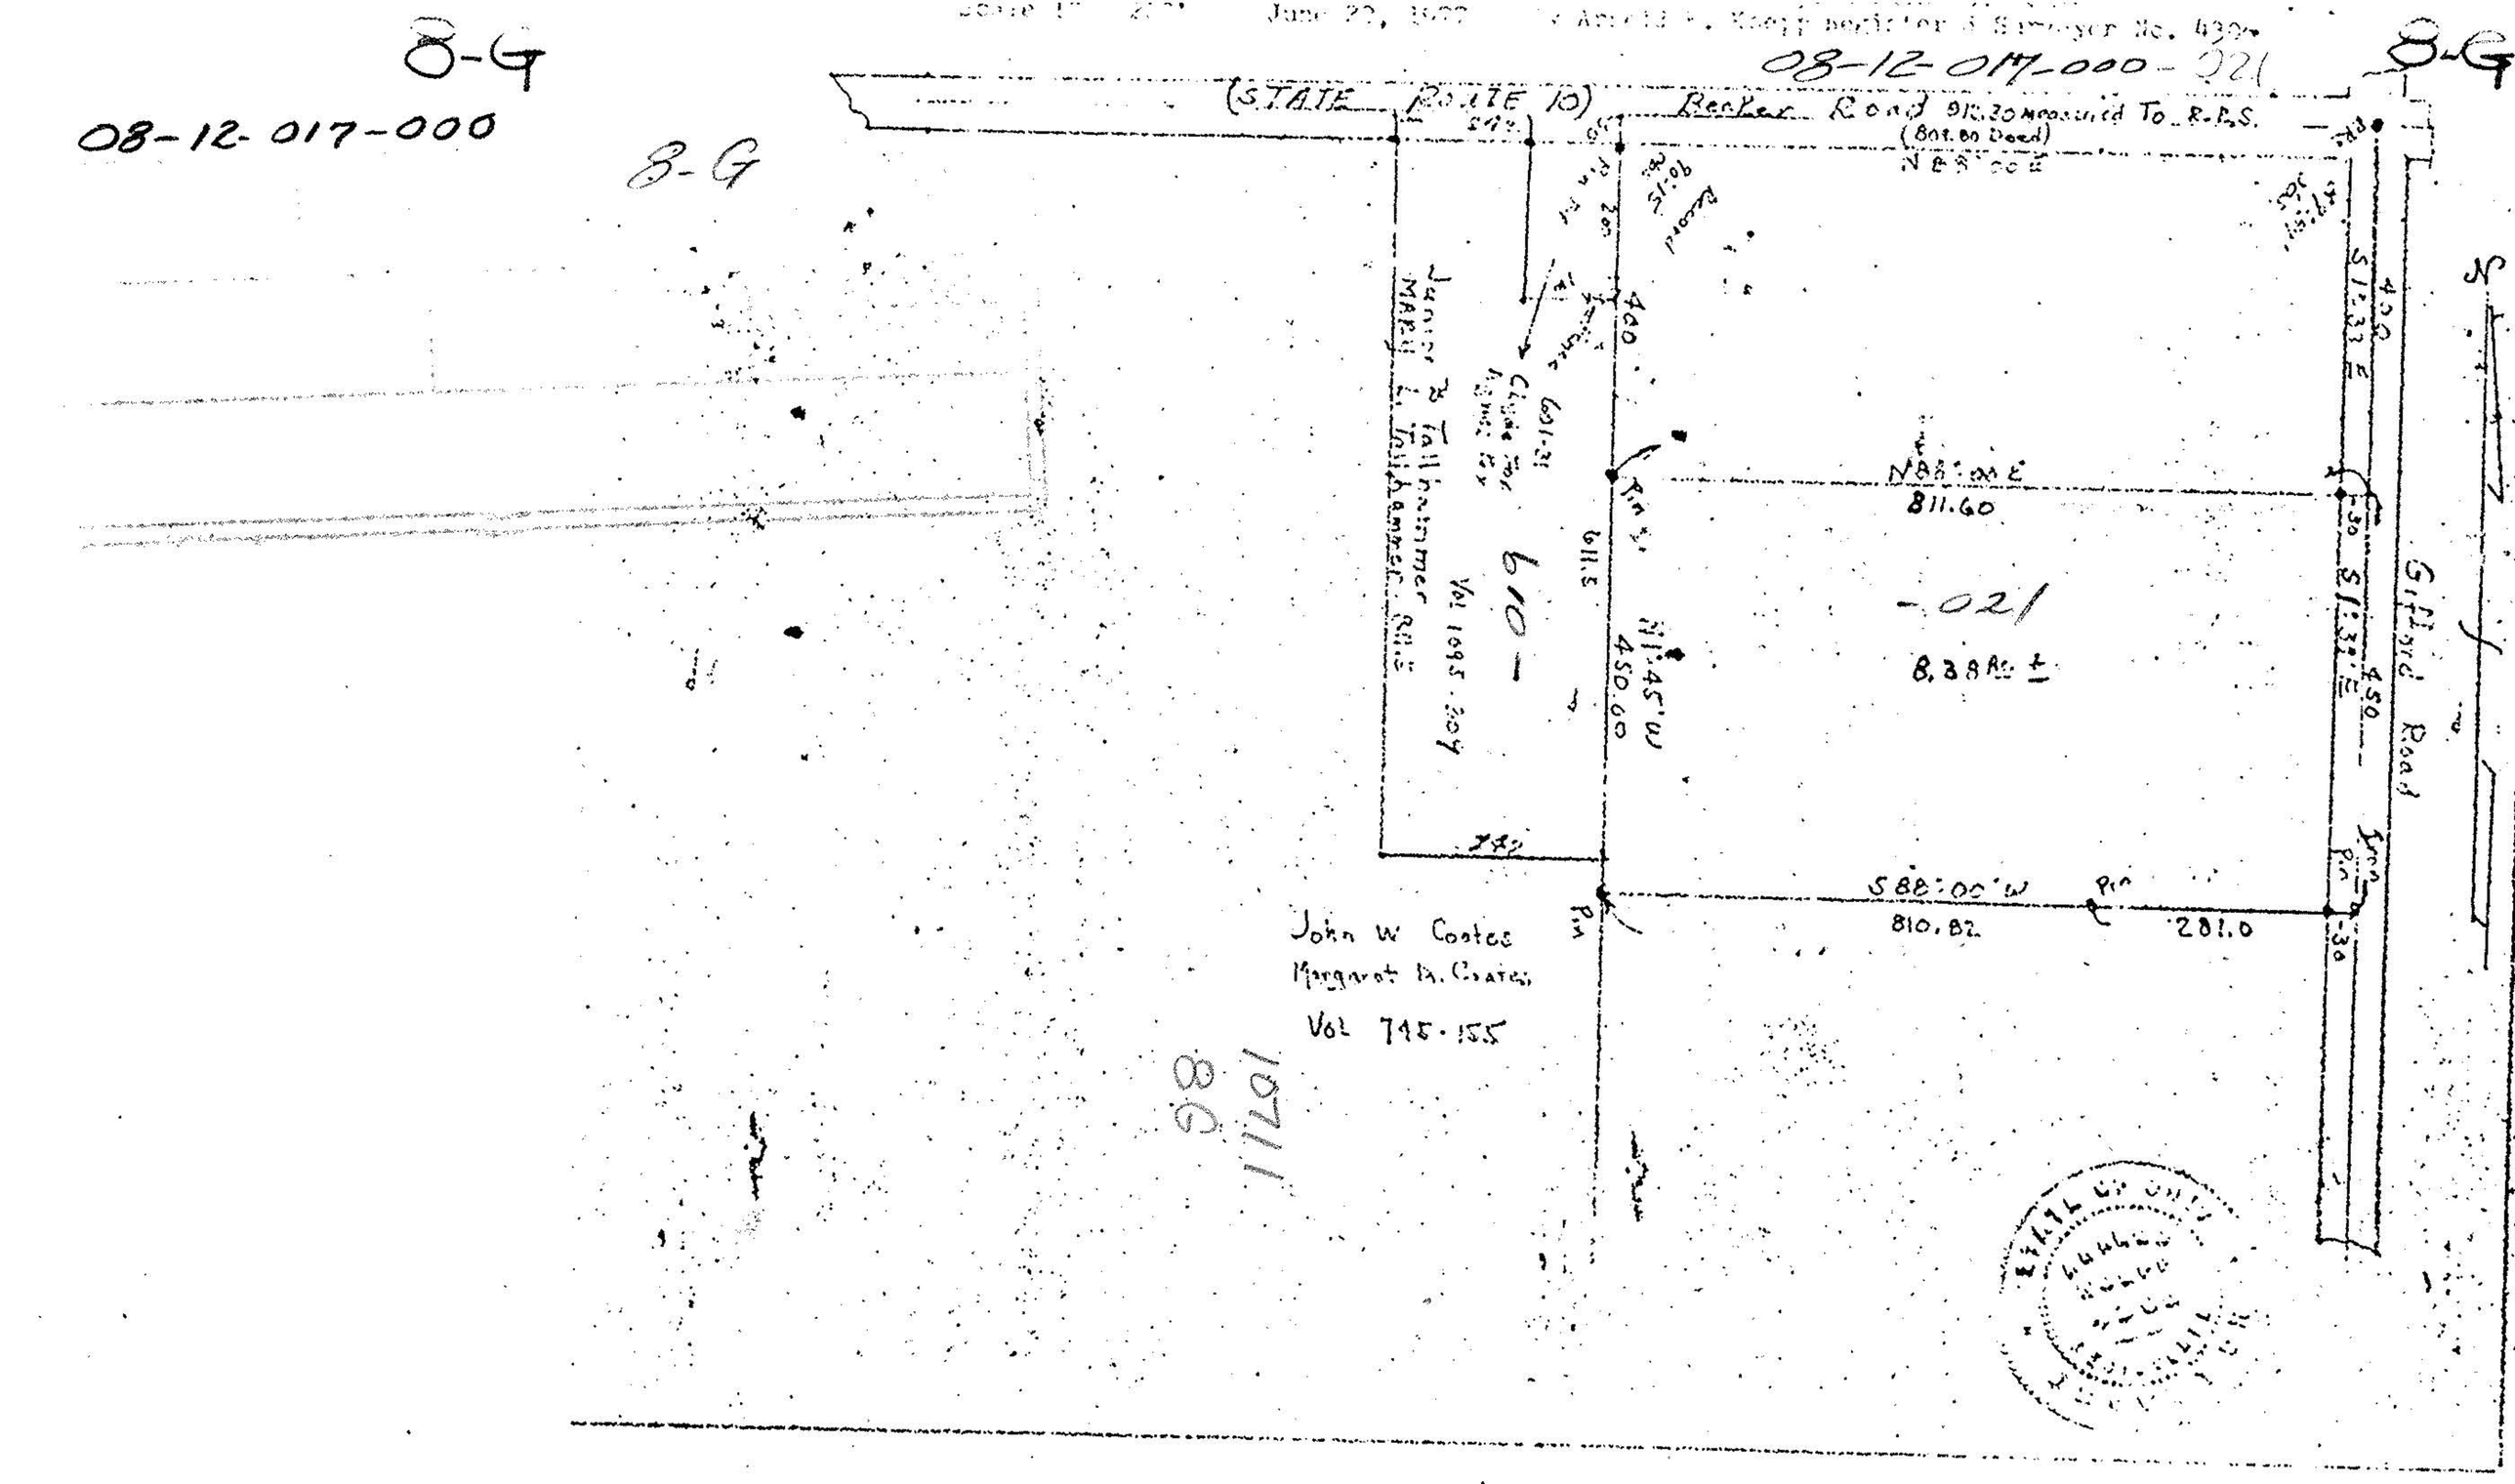

8-G
08-12-017-000
8-G
08-12-017-000-021
8-G
(STATE ROUTE 10)
Becker Road 912.30 measured To R.R.S.
(801.00 Deed)
N88°00'E
Junior B Tallhammer
MARY L. Tallhammer 811.5
Vol 1095-204
610-
611.5
N1°45'W
450.00
N88°00'E
811.60
-021
8.38 Ac ±
S88°00'W
810.82
281.0
S1°33'E
400
S1°33'E
450
Gifford Road
John W Coates
Margaret M. Coates
Vol 745-155
10711
8G