HUFNAGLE'S SUBDIVISION

SITUATED IN THE TOWNSHIP OF HENRIETTA
COUNTY OF LORAIN AND STATE OF OHIO AND
KNOWN AS BEING PART OF TRACT 12. ORIGINAL
LOTS 17 & 18.
FORMERLY PPN 8-12-017-000-022 &
PPN 8-12-018-000-001
PRIOR DEED REFERENCE V 358 P 24

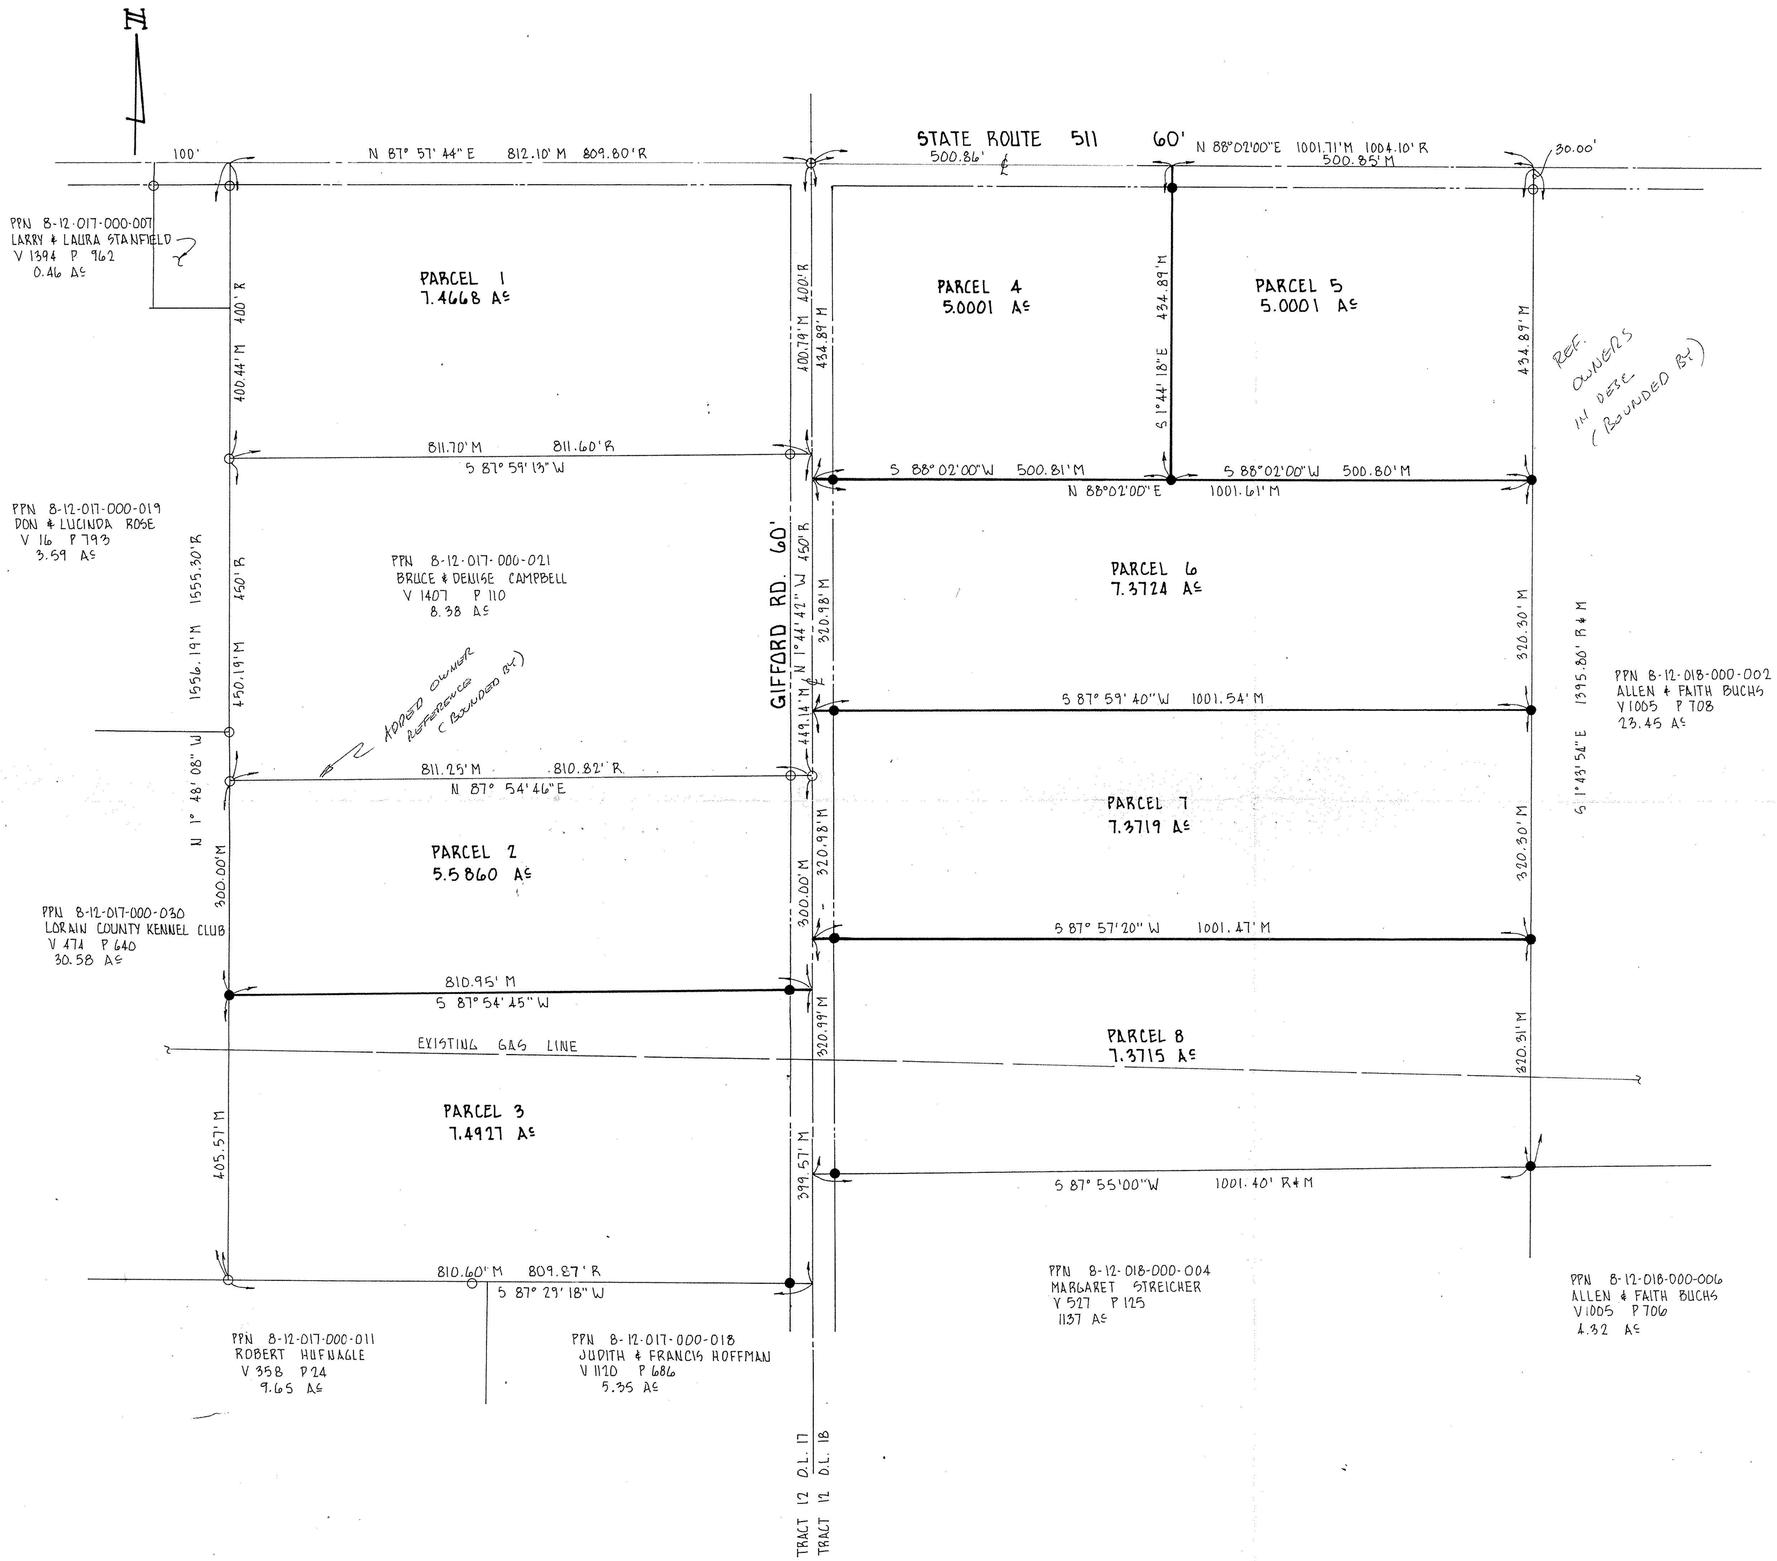

LEGEND

○	IRON PIPE FOUND
●	IRON PIPE SET
M	MEASURED DISTANCE
R	RECORD DISTANCE

SCALE 1" = 100'

BEARINGS ARE GIVEN TO AN ASSUMED MERIDIAN FOR THE PURPOSE OF DESCRIBING ANGLES ONLY. DISTANCES ARE GIVEN IN FEET AND DECIMAL PARTS THEREOF. IRON PIPES WERE FOUND OR SET AT ALL POINTS INDICATED ALL OF WHICH I CERTIFY TO BE CORRECT TO THE BEST OF MY PROFESSIONAL KNOWLEDGE INFORMATION AND BELIEF.

RICHARD ROSEBECK PE PS — DATE
SURVEYOR Nº 7400

STATE OF OHIO
RICHARD A ROSEBECK
7400
REGISTERED
PROFESSIONAL SURVEYOR

20122
20121

APPROVED
LORAIN CO.
MAP DEPT.
DATE 10-21-92
PAGE 8-G
BY CAROLYN FRANCIS
VOID AFTER 20121

08-12-017-000