


PLAT OF SURVEYING FOR KENNETH R. KOYAN

DIVISION OF 36.137 ACRES OF LAND IN ORIGINAL
LOT NO. 12 OF TRACT NO. 13 IN HENRIETTA TWP.
LORAIN COUNTY OHIO

SCALE: 1"=100' JUNE-1980 REVISED JULY 18-1980
BOUNDARY SURVEYED IN OCTOBER-1976
Gary E. Penfound Reg. Surveyor No. 4457

O.L. 9
O.L. 12 2005.50'

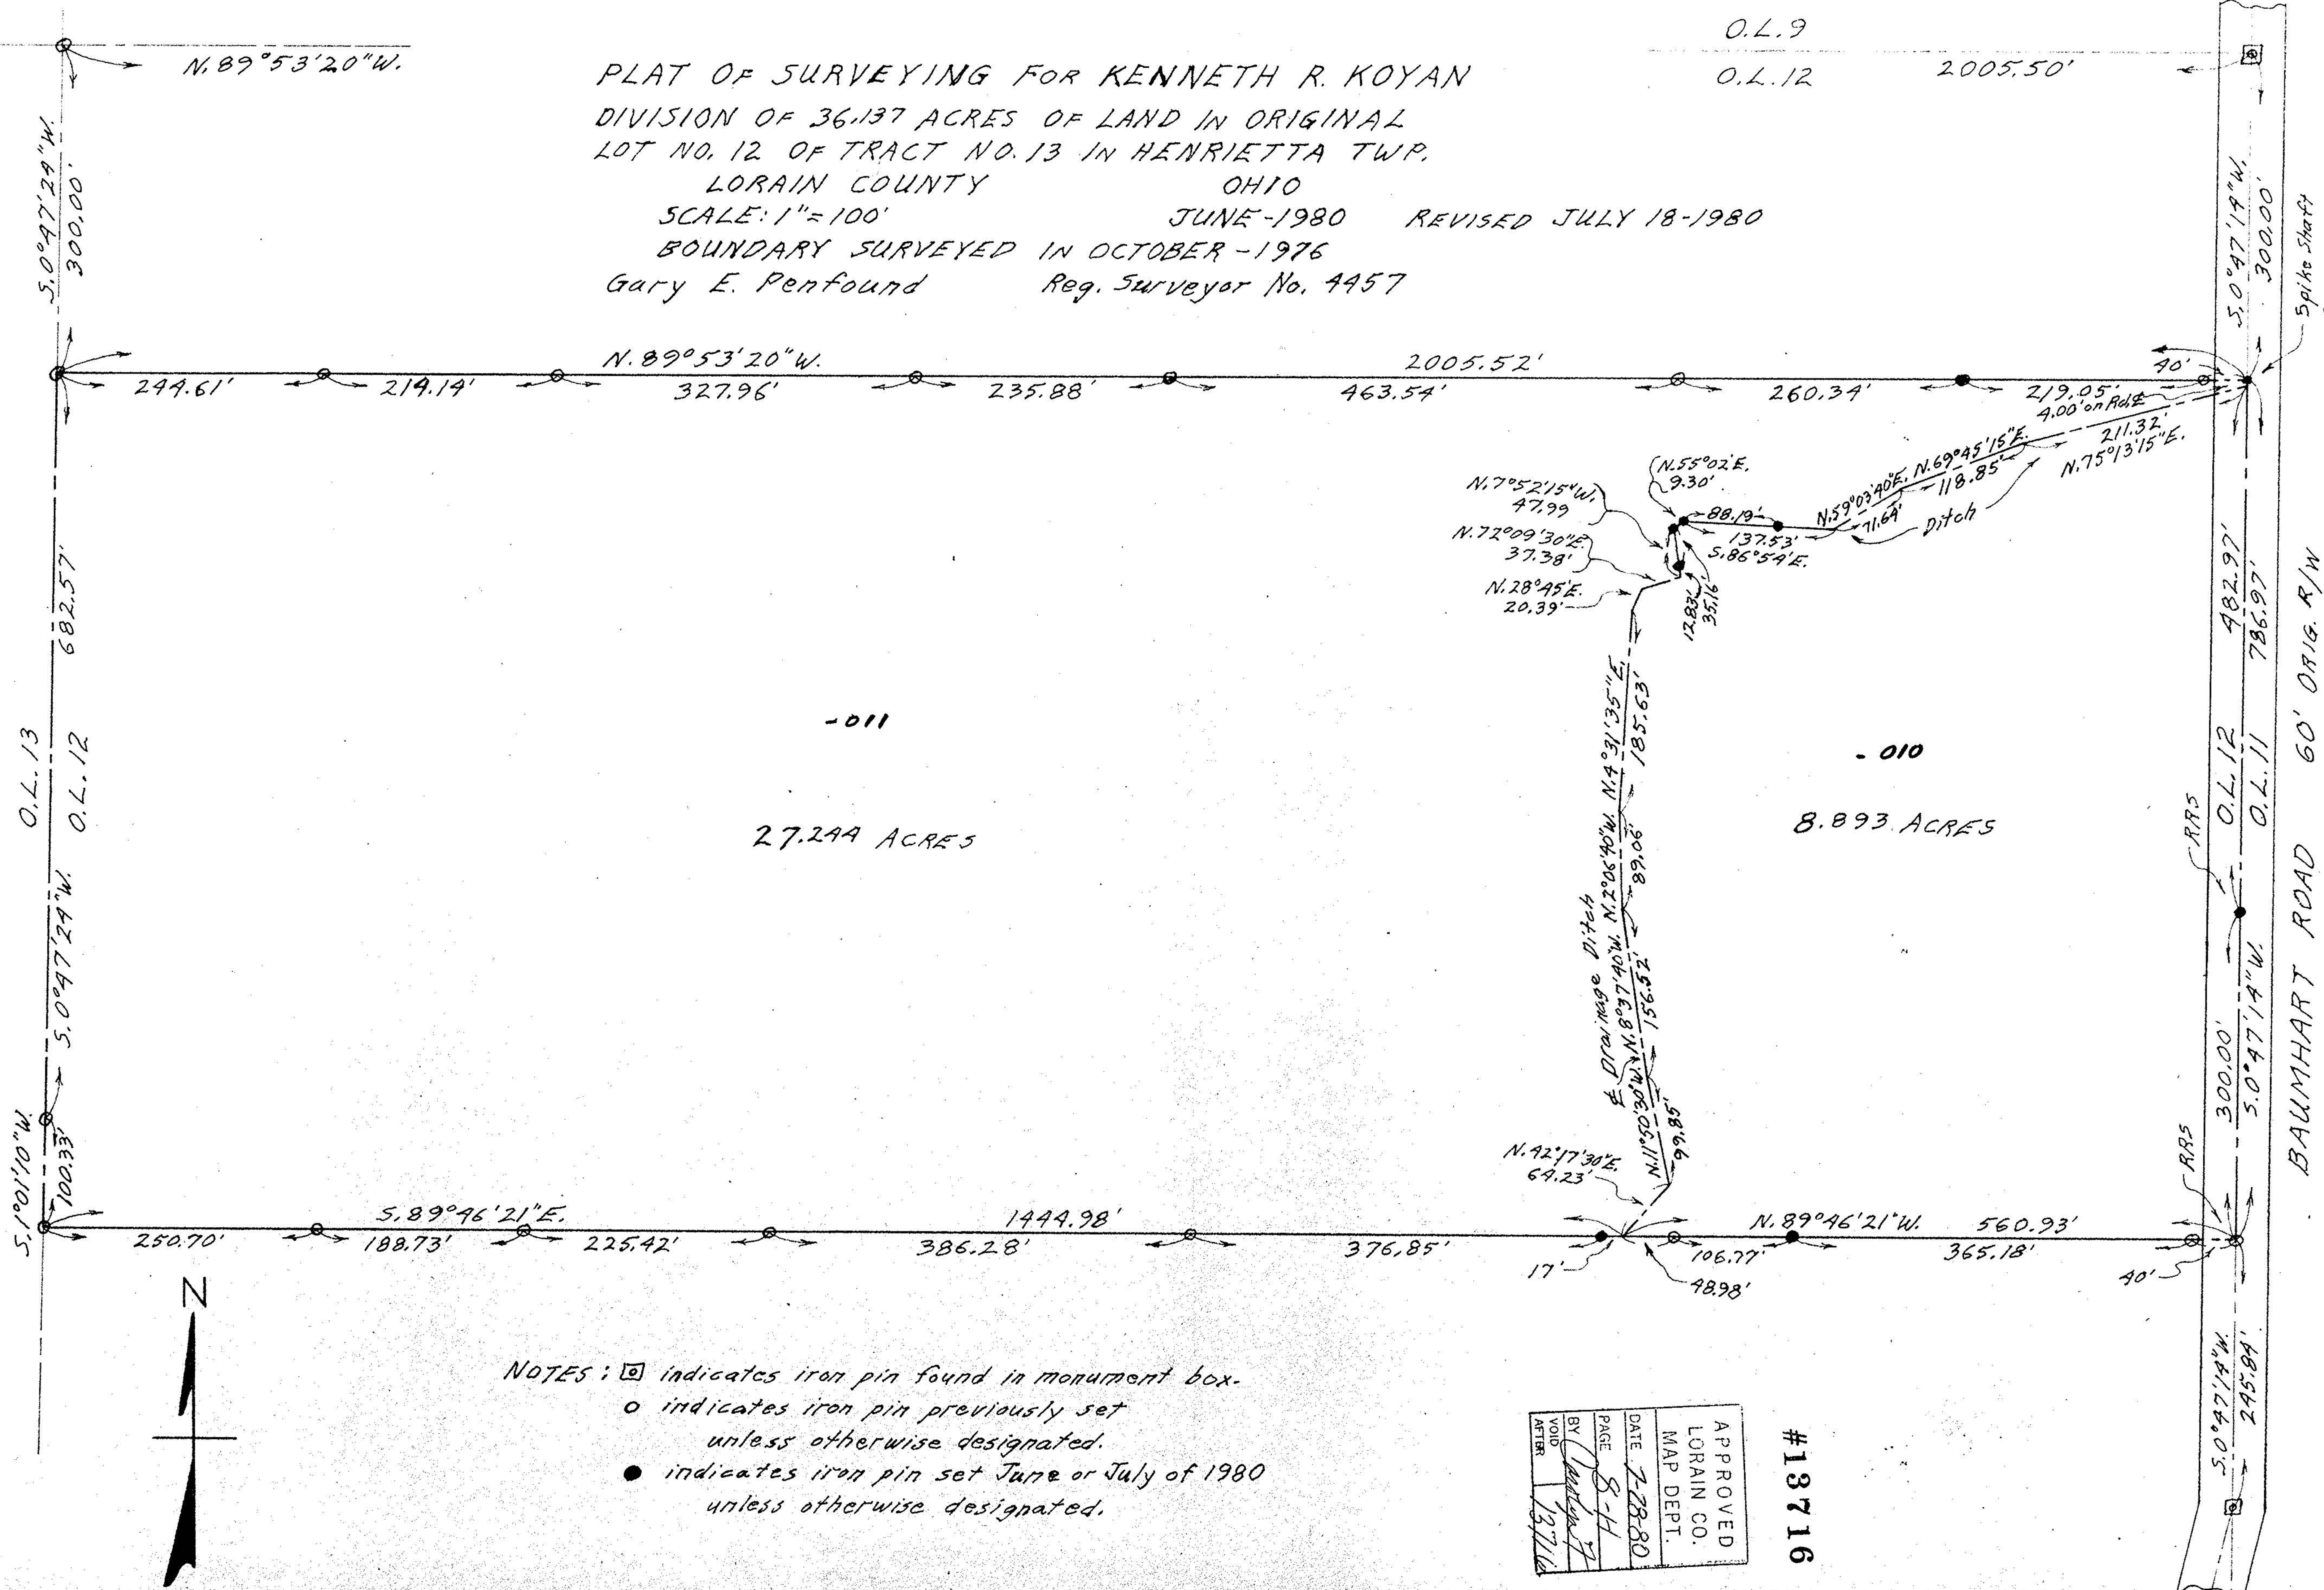

27.244 ACRES

8.893 ACRES

- NOTES: \square indicates iron pin found in monument box.
 \circ indicates iron pin previously set unless otherwise designated.
 \bullet indicates iron pin set June or July of 1980 unless otherwise designated.

APPROVED	DATE	PAGE	BY
LORAIN CO.	7-28-80	8-11	Penfound
MAP DEPT.			
VOID			
AFTER	12/7/16		

#13716

Spike Sharpy
Set Oct. 1976

BAUMHART ROAD 60' ORIG. R/W