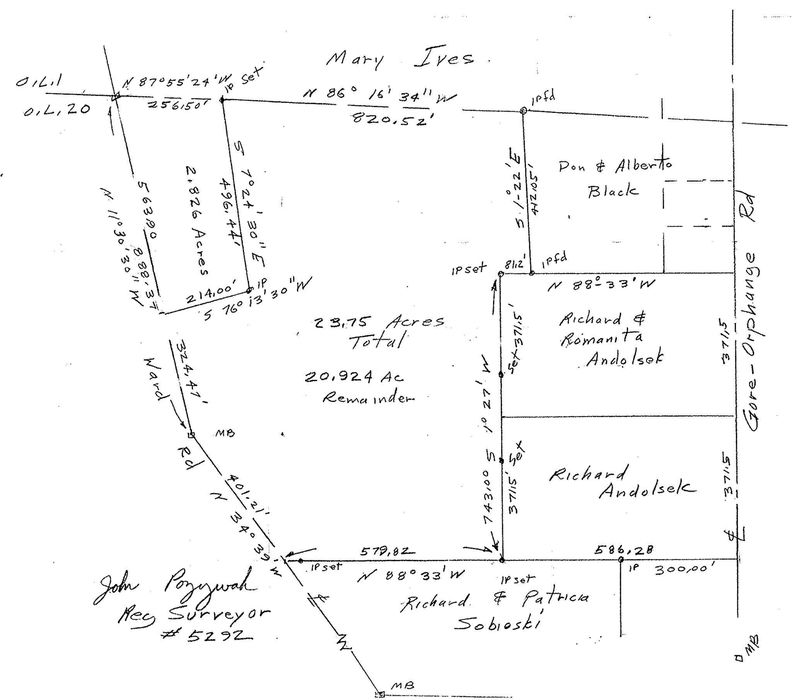

08-13-024-000

#17999

APPROVED LORAIN CO. MAP DEPT.	
DATE	6-22-88
PAGE	2-E
BY	C. Fragoso
VOID AFTER #	17999
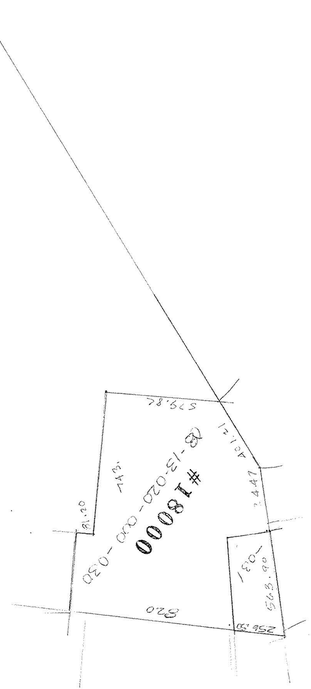
Survey for John Black
Part of Original Lot 20
Tract 13
Henrietta Township
Lorain County Ohio
Scale 1" = 200' Oct 3, 198