MAP OF SURVEY AND LOT SPLIT

PREPARED FOR

CAROL E. AND MARIANN L. RODGERS

SITUATED IN THE TOWNSHIP OF HENRIETTA, COUNTY OF LORAIN, STATE OF OHIO

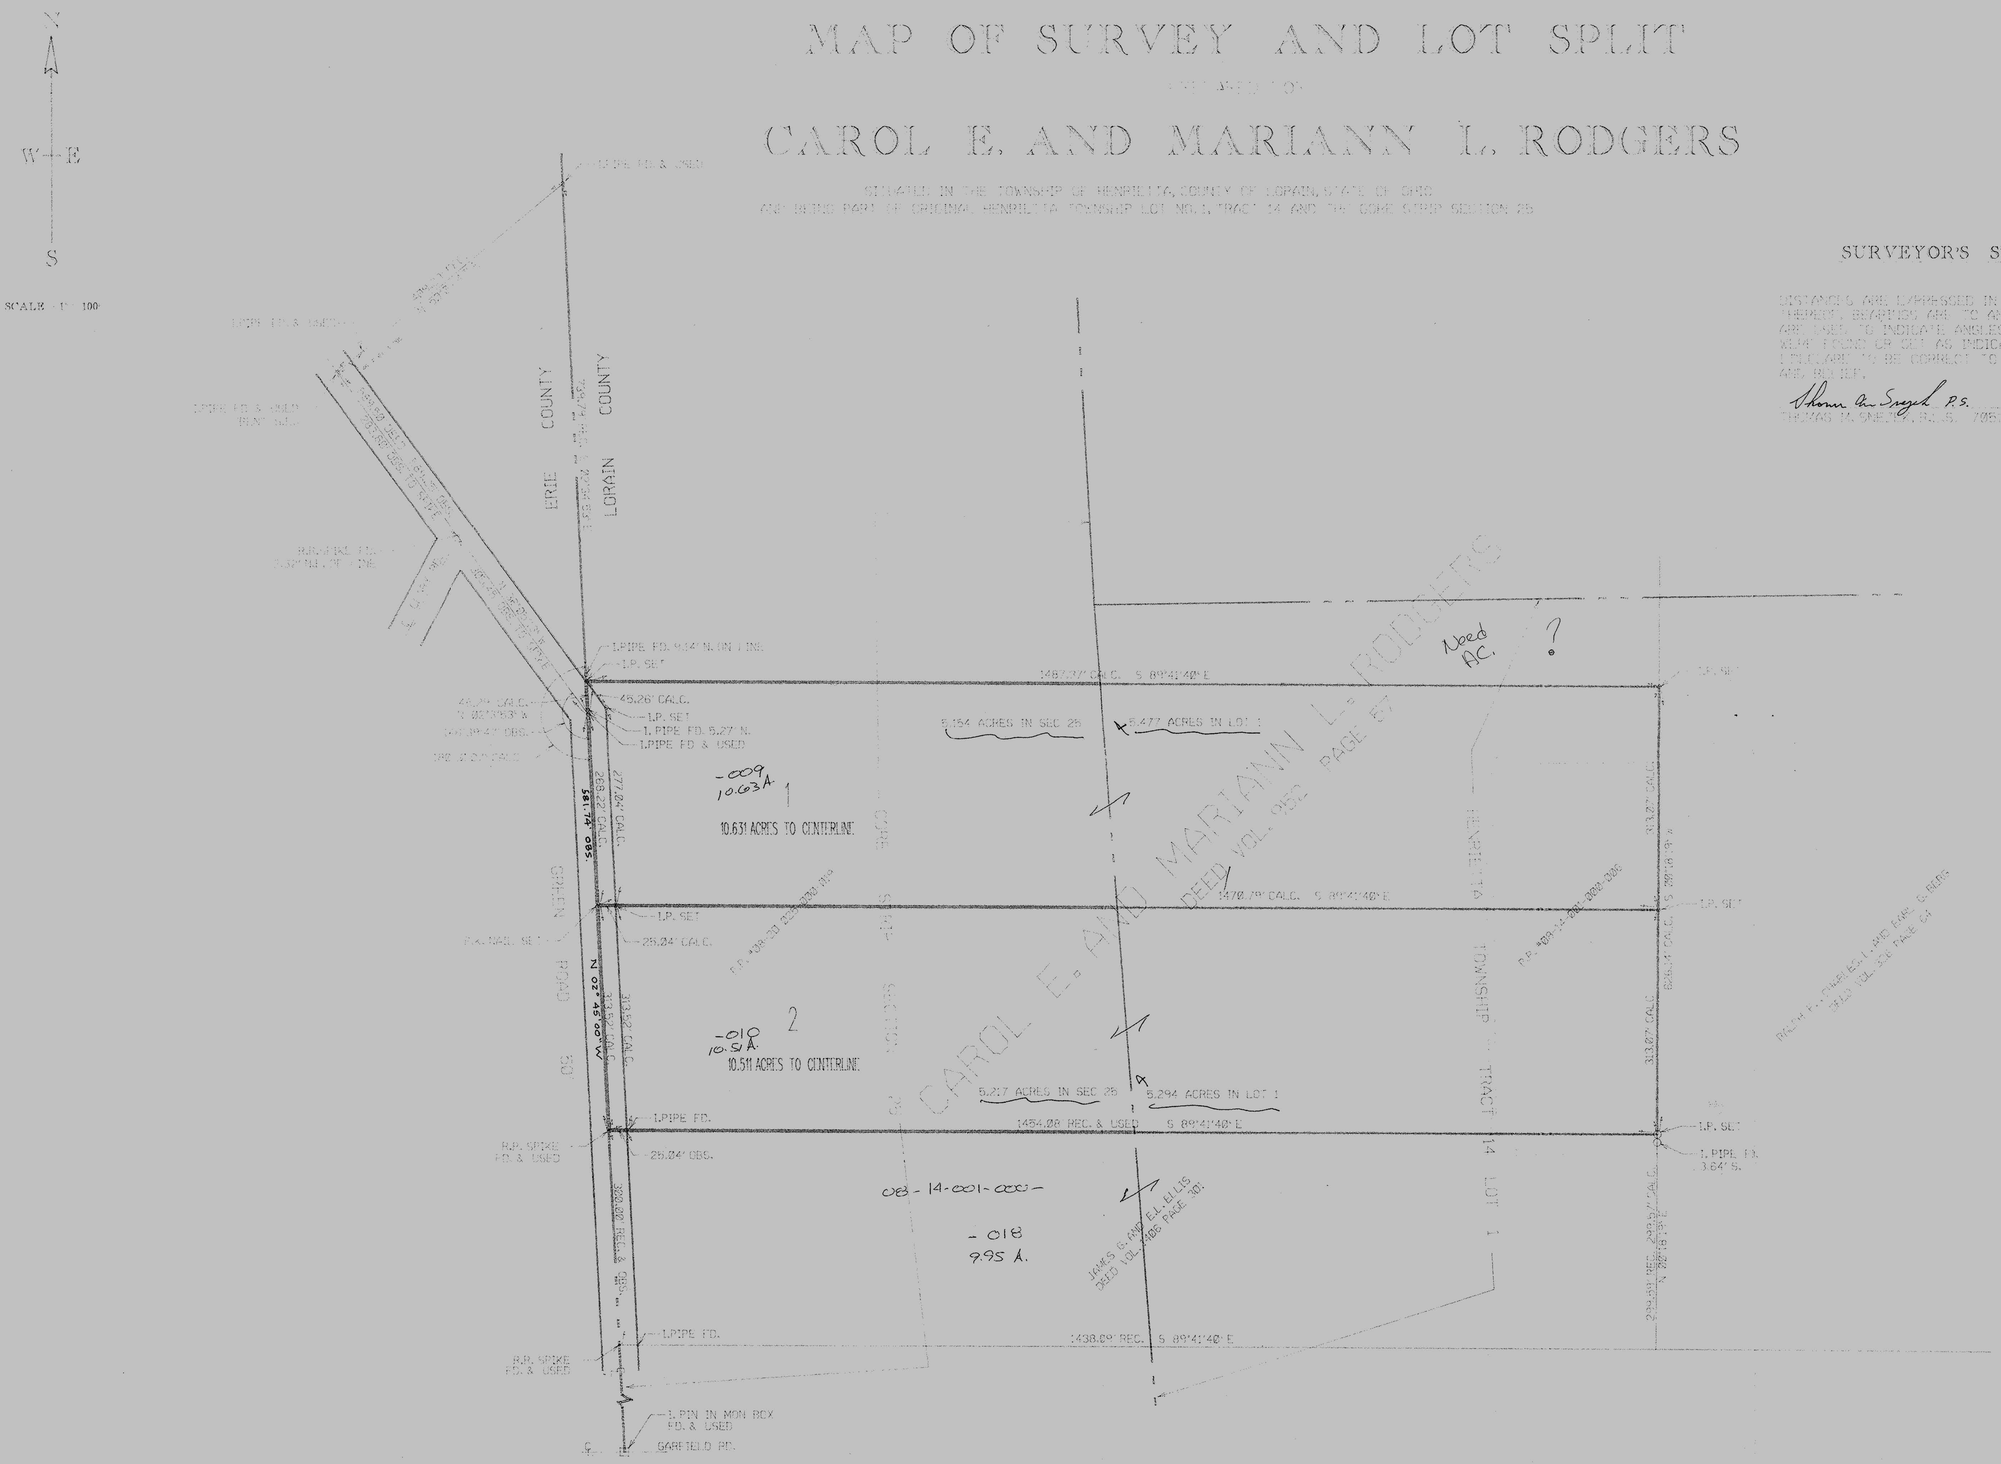

SURVEYOR'S STATEMENT

DISTANCES ARE EXPRESSED IN FEET AND DECIMAL PARTS THEREOF. BEARINGS ARE TO AN ASSUMED MERIDIAN AND ARE USED TO INDICATE ANGLES ONLY. PERMANENT MONUMENTS WERE FOUND OR SET AS INDICATED HEREON, ALL OF WHICH I BELIEVE TO BE CORRECT TO THE BEST OF MY ABILITIES AND BELIEF.

Thomas M. Sheder P.S. 5-5-93
THOMAS M. SHEDER, P.S. 7051 DATE

STATE OF OHIO
THOMAS M. SHEDER
S 7051
SURVEYOR

20414
APPROVED
LORAIN CO.
MAP DEPT.
DATE 7-9-93
PAGE 8-A
BY CAROLYN FRANCIS
VOID AFTER # 20414

08-20-025-000
08-14-001-000

9307