


08-14-011-000-  
08-20-024-000-

#19104

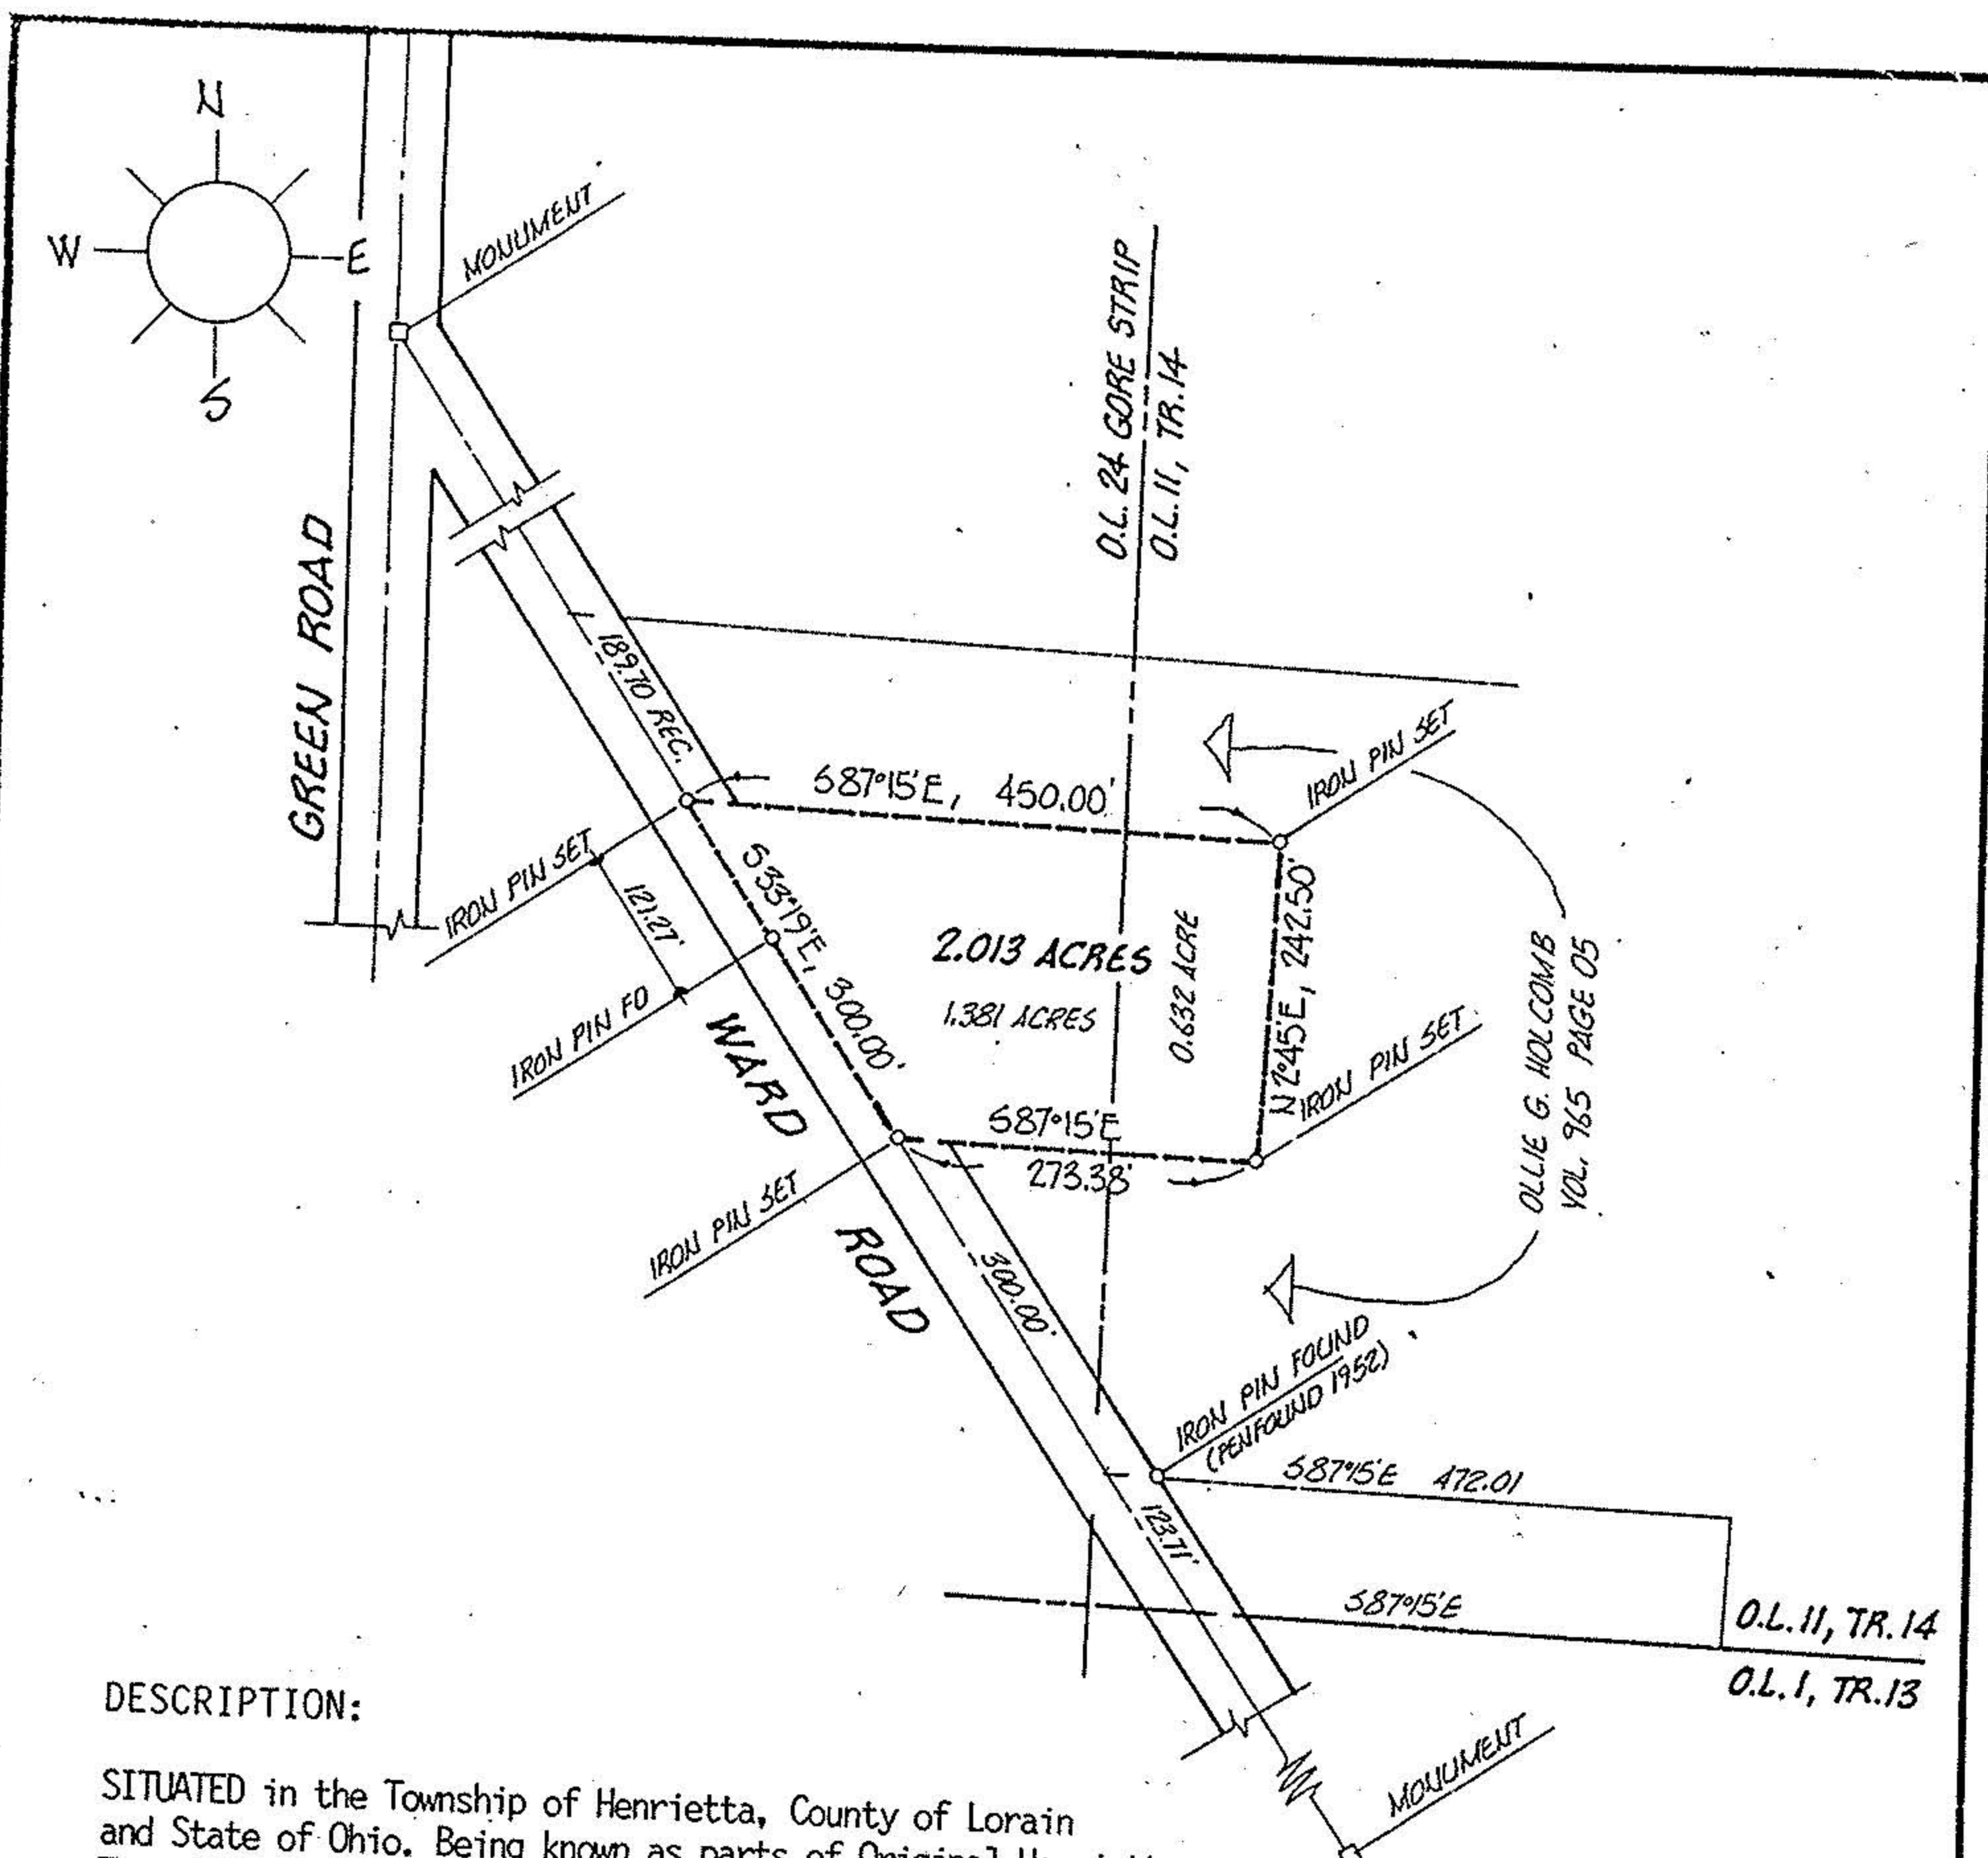

DESCRIPTION:

SITUATED in the Township of Henrietta, County of Lorain and State of Ohio. Being known as parts of Original Henrietta Township Lot 24 in the Gore Strip and Original Lot 11 in Tract 14 of said Township, bounded and described as follows;

BEGINNING at an iron pin set in the centerline of Ward Road being North 33°19' West a distance of 423.71 feet from its intersection with the south line of Original Lot 11. THENCE North 33°19' West along said centerline, a distance of 300.00 feet to an iron pin set. THENCE South 87°15' East in a line parallel to the south line of Original Lot 11, a distance of 450.00 feet to an iron pin set. THENCE South 2°45' West, a distance of 242.50 feet to an iron pin set. THENCE North 87°15' West in a line parallel to the south line of Original Lot 11, a distance of 273.38 feet to the place of beginning, embracing 2.013 acres of land, but being subject to all legal highways, as surveyed by Michael G. Hura. Said parcel embraces 0.632 acres in Original Lot 11 and 1.381 acres in Original Lot 24.

#19104

APPROVED  
LORAIN CO.  
MAP DEPT.  
DATE 10-4-90  
PAGE 8-E  
BY CAROLYN FRANCIS  
VOID AFTER #19104

ACREAGE 2.013  
DATE JULY 90  
DRAWN MGH  
SCALE 1" = 200 ft.

PREPARED FOR MRS. BERNARD BUCHS

MICHAEL G. HURA registered surveyor  
12706 MASON ROAD, VERMILION, OHIO [216] 965-4040

PERIMETER SURVEY

SUBLOT \_\_\_\_\_ OF \_\_\_\_\_  
Volume \_\_\_\_\_ Page \_\_\_\_\_ of PLATS  
PART OF O.L. 11-24 TRACT, 14 SECTION \_\_\_\_\_ OF  
HENRIETTA TOWNSHIP LORAIN CO., OHIO  
Perm. Parcel No \_\_\_\_\_ Ref. deed: VOL 965 PG 05

CITY OF



8-E