


BAIRD ROAD

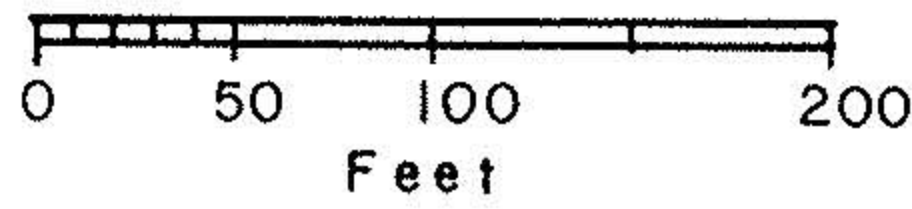

NORTH

SCALE
1" = 100'

O.L. 7
O.L. 6

O.L. 14
O.L. 15

O.L. 6
O.L. 15

332.85
S 89° 00' E

90° 04' 53" Obs.

S 76° 24' 15" E
9.75'

I.P. Set
30.74'

17° 25' 40" Obs.

400.00'
S 76° 24' 15" E

897.80'

R.R. Set
I.P. Set
30.74'

-001 6.00 Ac
5.9835 Ac. Calc.

William D. & Donna J.
Born

V. 1113, P. 230

760.32' D.
760.48' Obs.

501.19'
N 1° 01' 25" E

4.1017 AC.

S 1° 01' 25" W
414.12'

N 88° 58' 35" W
390.40'

I.P. Set

I.P. Set

20730

TRACT

08 - 14 - 015 - 000 -

-002 61.50 Ac.

Bev B. & Irene G. Stoffers

V. 1106, P. 78

257.37' Obs.
N 1° 01' 25" E

343.03' Obs.
about 331.32' D.

I.P. & Bent

I.P. & Bent

APPROVED
LORAIN CO.
MAP DEPT.

DATE 2-7-94

PAGE 8-F

CAROLYN
BY FRANCIS

BOOK # 20730

MAP OF SURVEY MADE 4.1017
ACRES, PART OF HENRIETTA TWP. LOT
NO. 15, TRACT NO. 14, LORAIN COUNTY, OHIO

Made at request of Jeff Trottier

By Charles P. Waryu, Registered Surveyor

November 1993

No. 5029

Charles P. Waryu

Registered Surveyor No. 5029