


Mon. Rd. & Garfield Rd. 60'

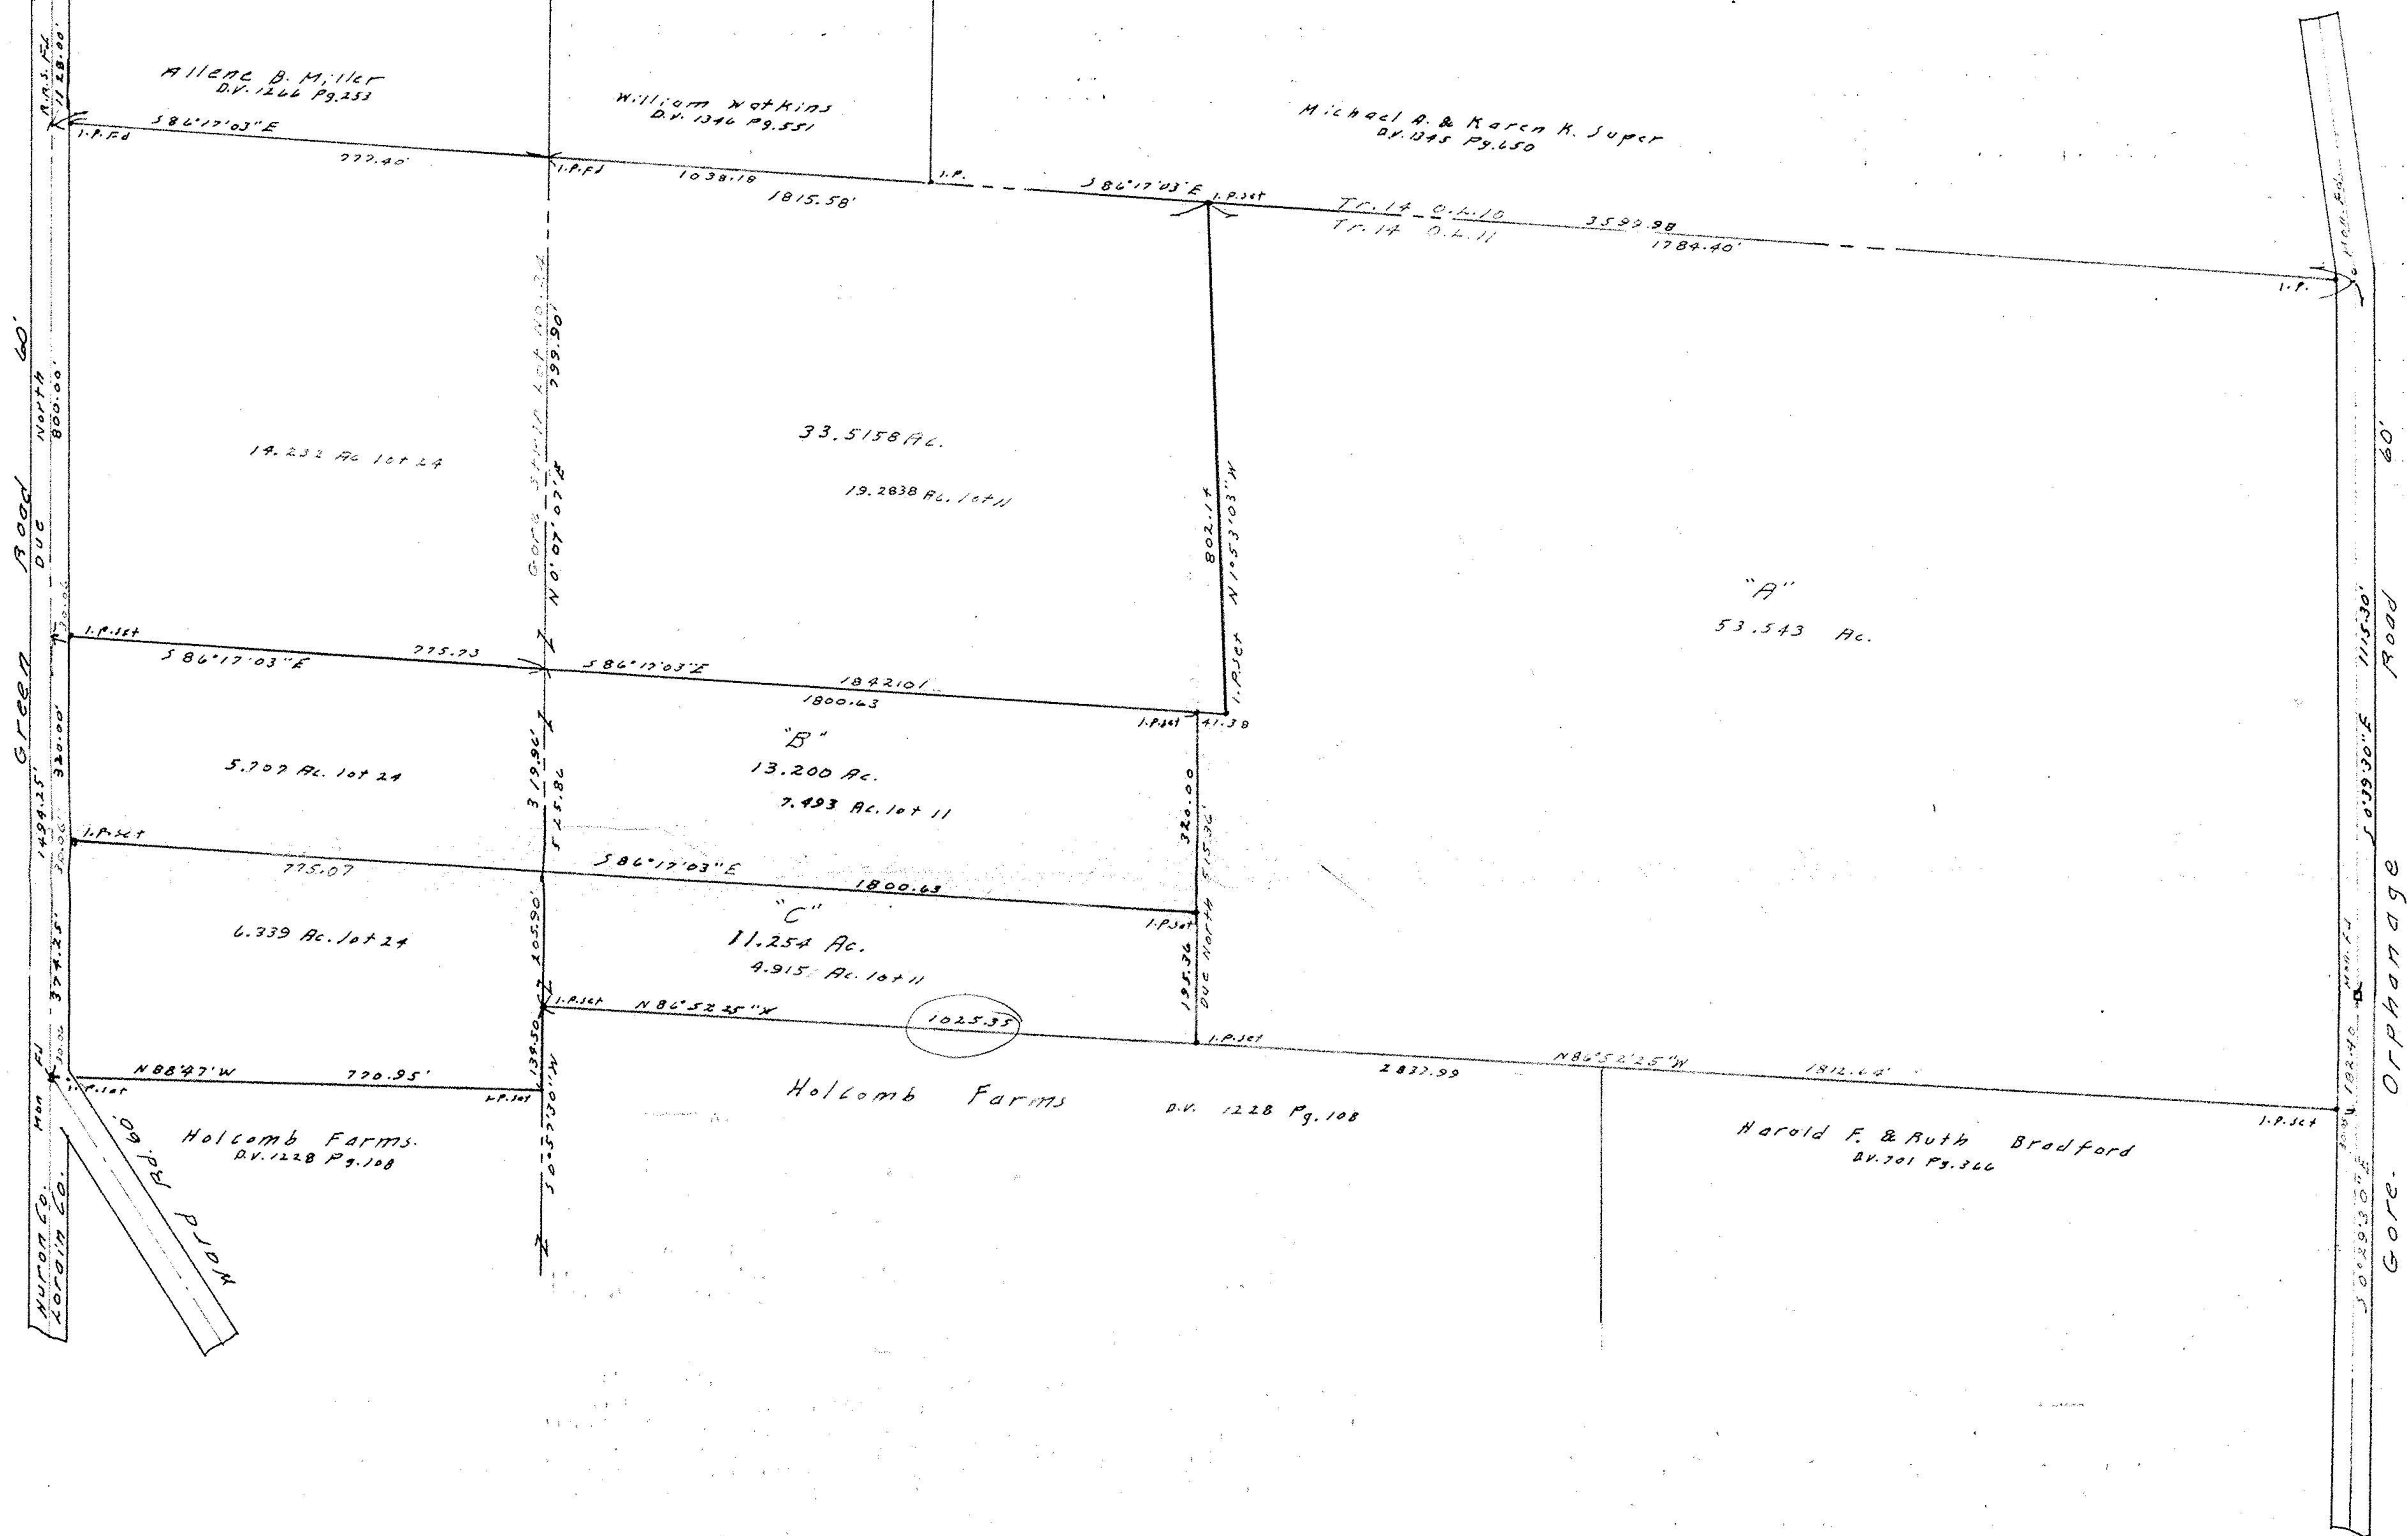

SURVEY  
 of  
 Part of Lot No. 24 of the Gore Strip  
 and part of Original Lot No. 11 Tr. No. 14  
 Henrietta Township Lorain County Ohio.  
 Scale 1" = 200'

July 20, 1985  
 Rev. July 25, 1985  
 Rev. SEPT. 28, 1985



#16441

APPROVED	
LORAIN CO.	
MAP DEPT.	
DATE	10-31-85
PAGE	2-4 of 8
BY	C. Francis
VOID	
AFTER	