


MAP OF SURVEY FOR
LESLIE A. & RUTH E. SLATINSKY
ORIGINAL LOT 12, TRACT 12, HENRIETTA TWP.
LORAIN COUNTY, OHIO

McGLINCHY & ASSOCIATES
Professional Engineer & Surveyor
625 N. Woodhill Drive
Amherst, Ohio 44001
Job No. 908793 April 22, 1990
Rev April 25, 1990

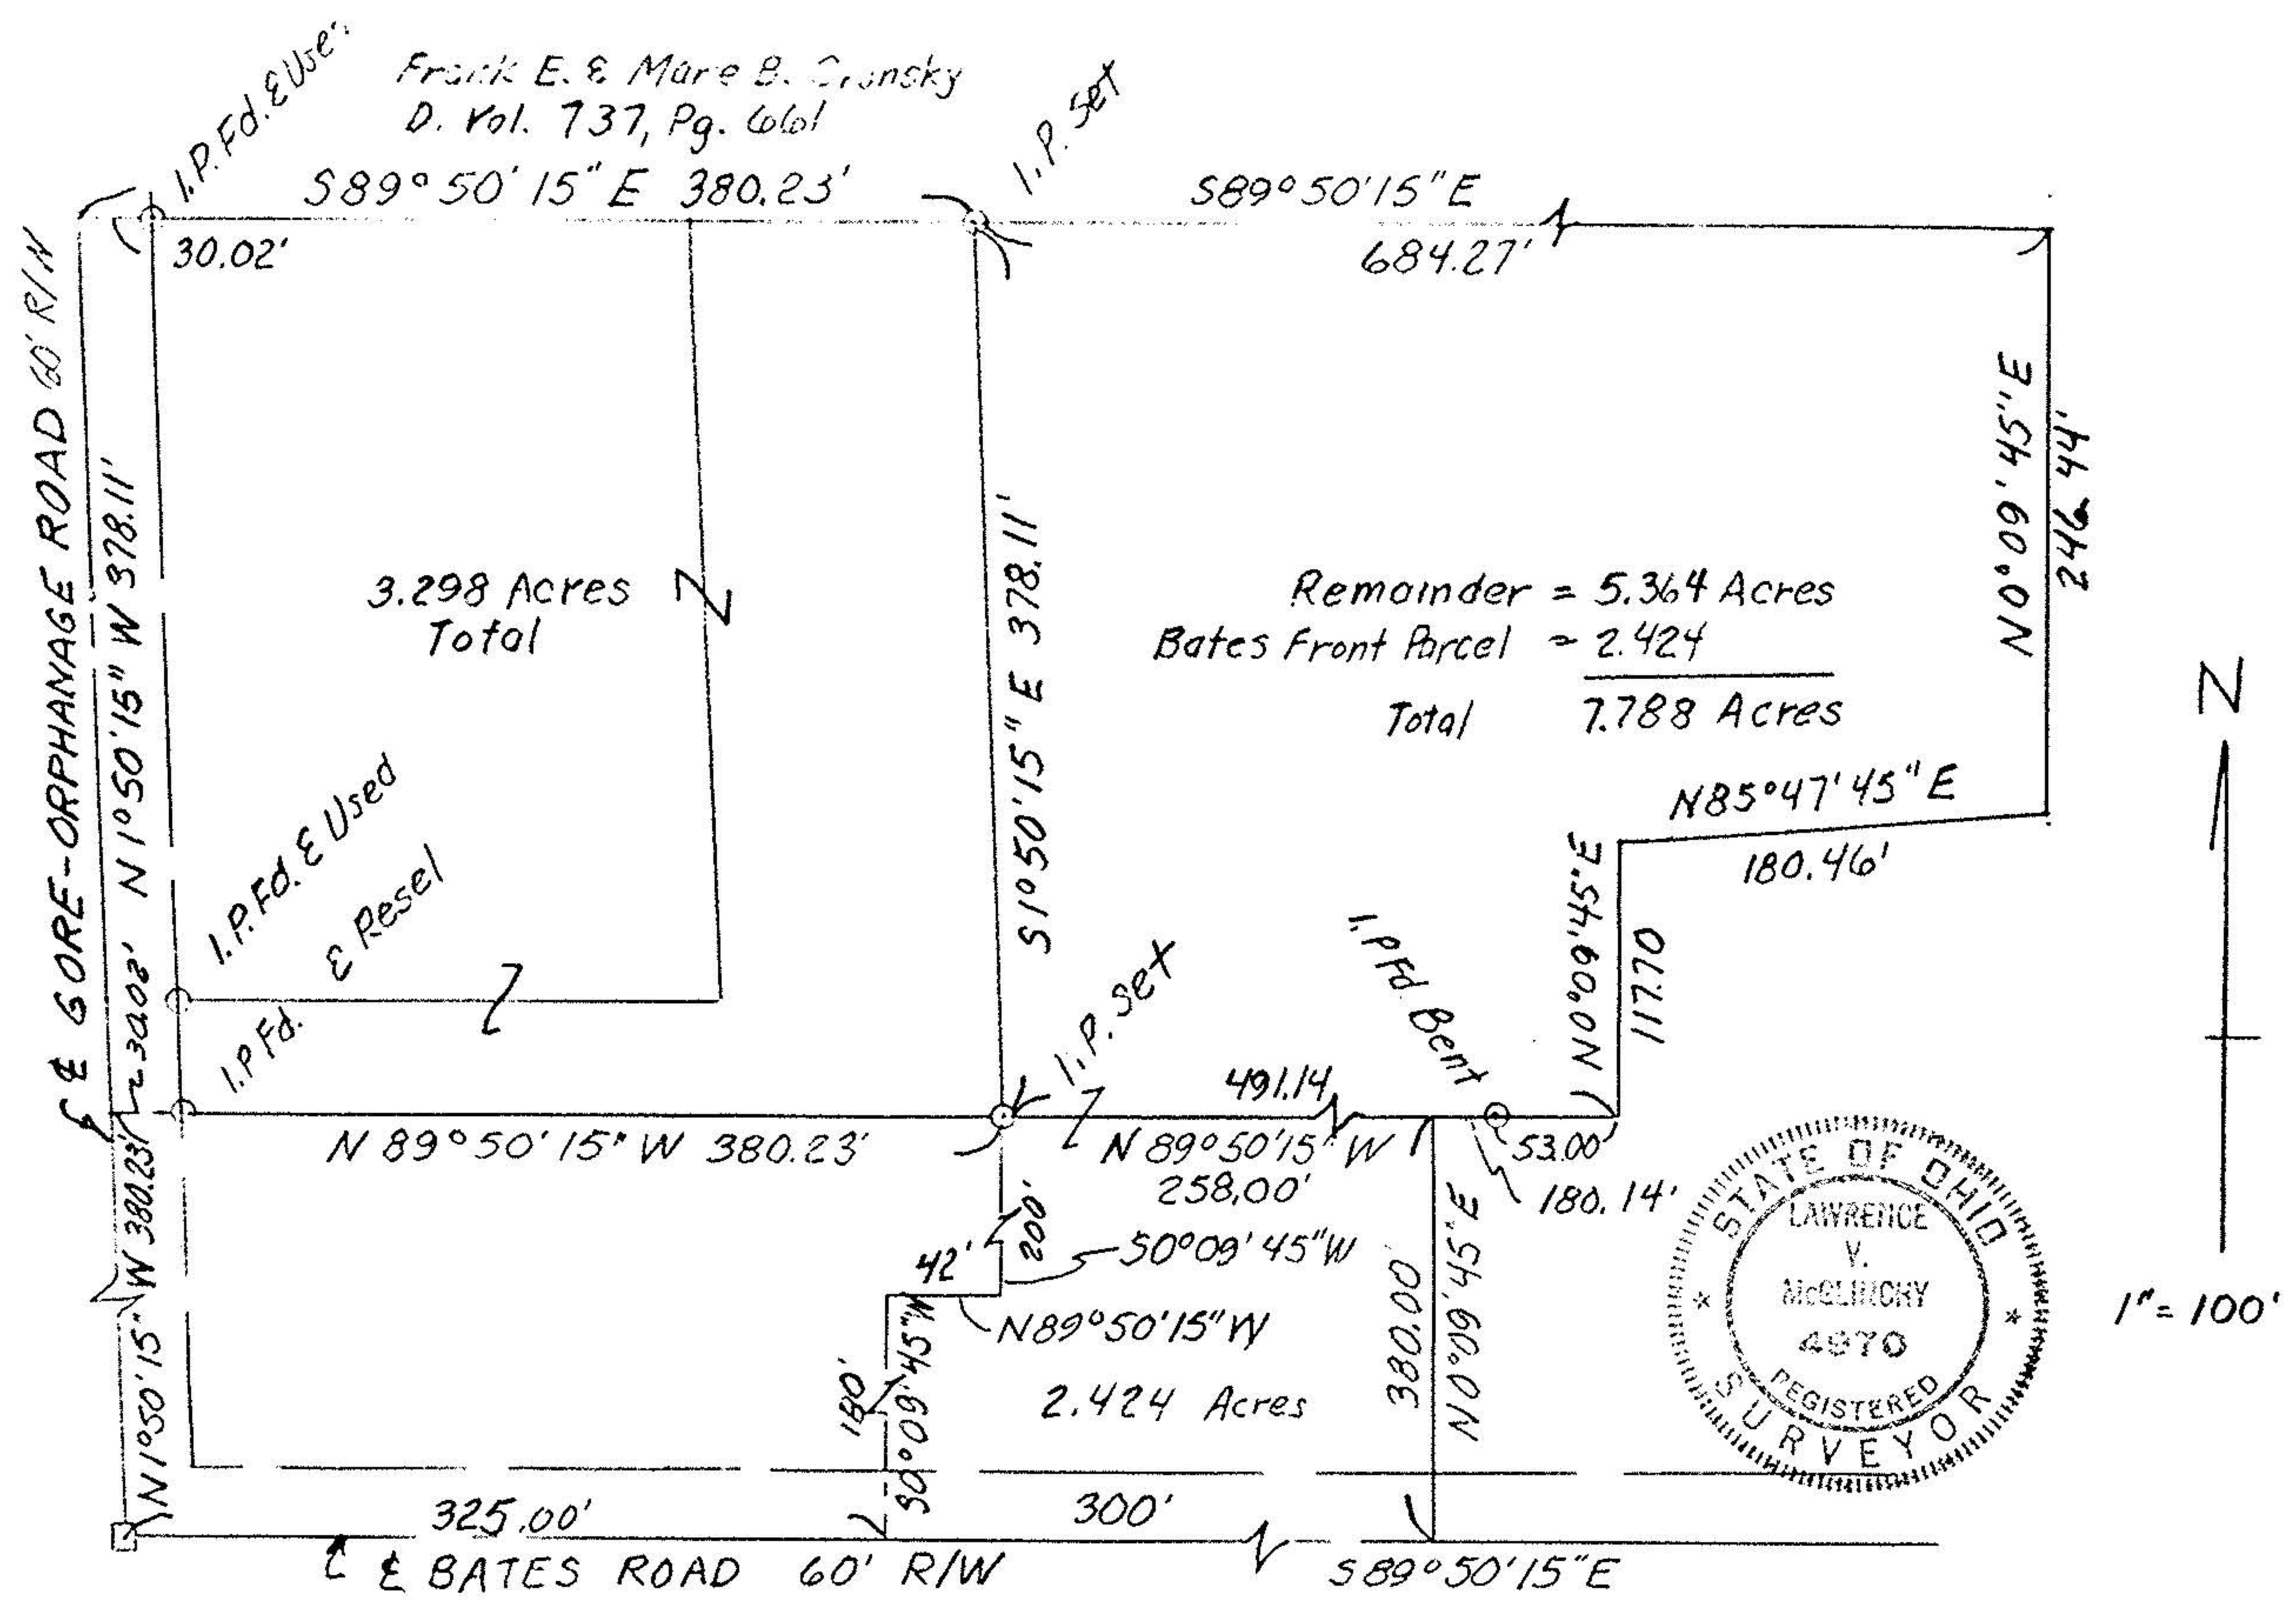

MAP OF SURVEY FOR
LESLIE A. & RUTH E. SLATINSKY
ORIGINAL LOT 12, TRACT 12, HENRIETTA TWP.
LORAIN COUNTY, OHIO

McGLINCHY & ASSOCIATES
Professional Engineer & Surveyor
625 N. Woodhill Drive
Amherst, Ohio 44001
Job No. 908793 April 22, 1990
Rev April 25, 1990