- ● P.K. Nail Set
- • IRON PIN
- ■ I.P. In Monument Box
- ▲ TRAVERSE POINT

| POINT | NORTHING | EASTING | DESCRIPTION |
|---|---|---|---|
| 1 | 19895.05679 | 16504.10479 | I.P. Fd. in Monument Box |
| 2 | 20000.00000 | 20000.00000 | I.P. Fd. in Monument Box |
| 3 | 20492.05482 | 19988.04605 | point |
| 4 | 20868.95528 | 19979.38329 | point |
| 5 | 21042.14356 | 19936.57698 | point |
| 6 | 21480.98060 | 19968.54649 | P.K. Nail |
| 7 | 21480.08189 | 19938.55995 | Iron Pin Set |
| 8 | 21466.00210 | 19468.77089 | Iron Pin Set |
| 9 | 21780.92160 | 19962.59676 | P.K. Nail |
| 10 | 21780.02289 | 19932.61022 | Iron Pin Set |
| 11 | 21765.94309 | 19462.82117 | Iron Pin Set |
| 12 | 22437.60006 | 19949.57369 | |
| 100 | 20465.40273 | 19989.55141 | |
| 101 | 20872.66180 | 19990.42017 | |
| 102 | 21041.95329 | 19934.14449 | |
| 103 | 21870.23639 | 19974.58989 | |
| 104 | 24134.46625 | 19915.91409 | |
| 200 | 10000.00000 | 10000.00000 | |
| 201 | 9998.75744 | 9572.84181 | |
| 202 | 10463.78437 | 9578.38818 | |
| 203 | 10504.50459 | 9614.95642 | |
| 204 | 10492.19227 | 10001.37032 | |
| 300 | 1000.00000 | 1000.00000 | |
| 301 | 561.16296 | 968.03049 | |
| 302 | 387.97468 | 1010.83680 | |
| 303 | 11.07422 | 1019.49956 | |
| 304 | 12.99588 | 630.90431 | |
| 305 | 168.99397 | 631.67574 | |
| 306 | 216.27443 | -33.34565 | |
| 307 | 968.79483 | -44.29138 | |
| 500 | 10000.00000 | 10000.00000 | |
| 501 | 10829.27000 | 10000.00000 | |
| 502 | 13087.94350 | 9830.96235 | |

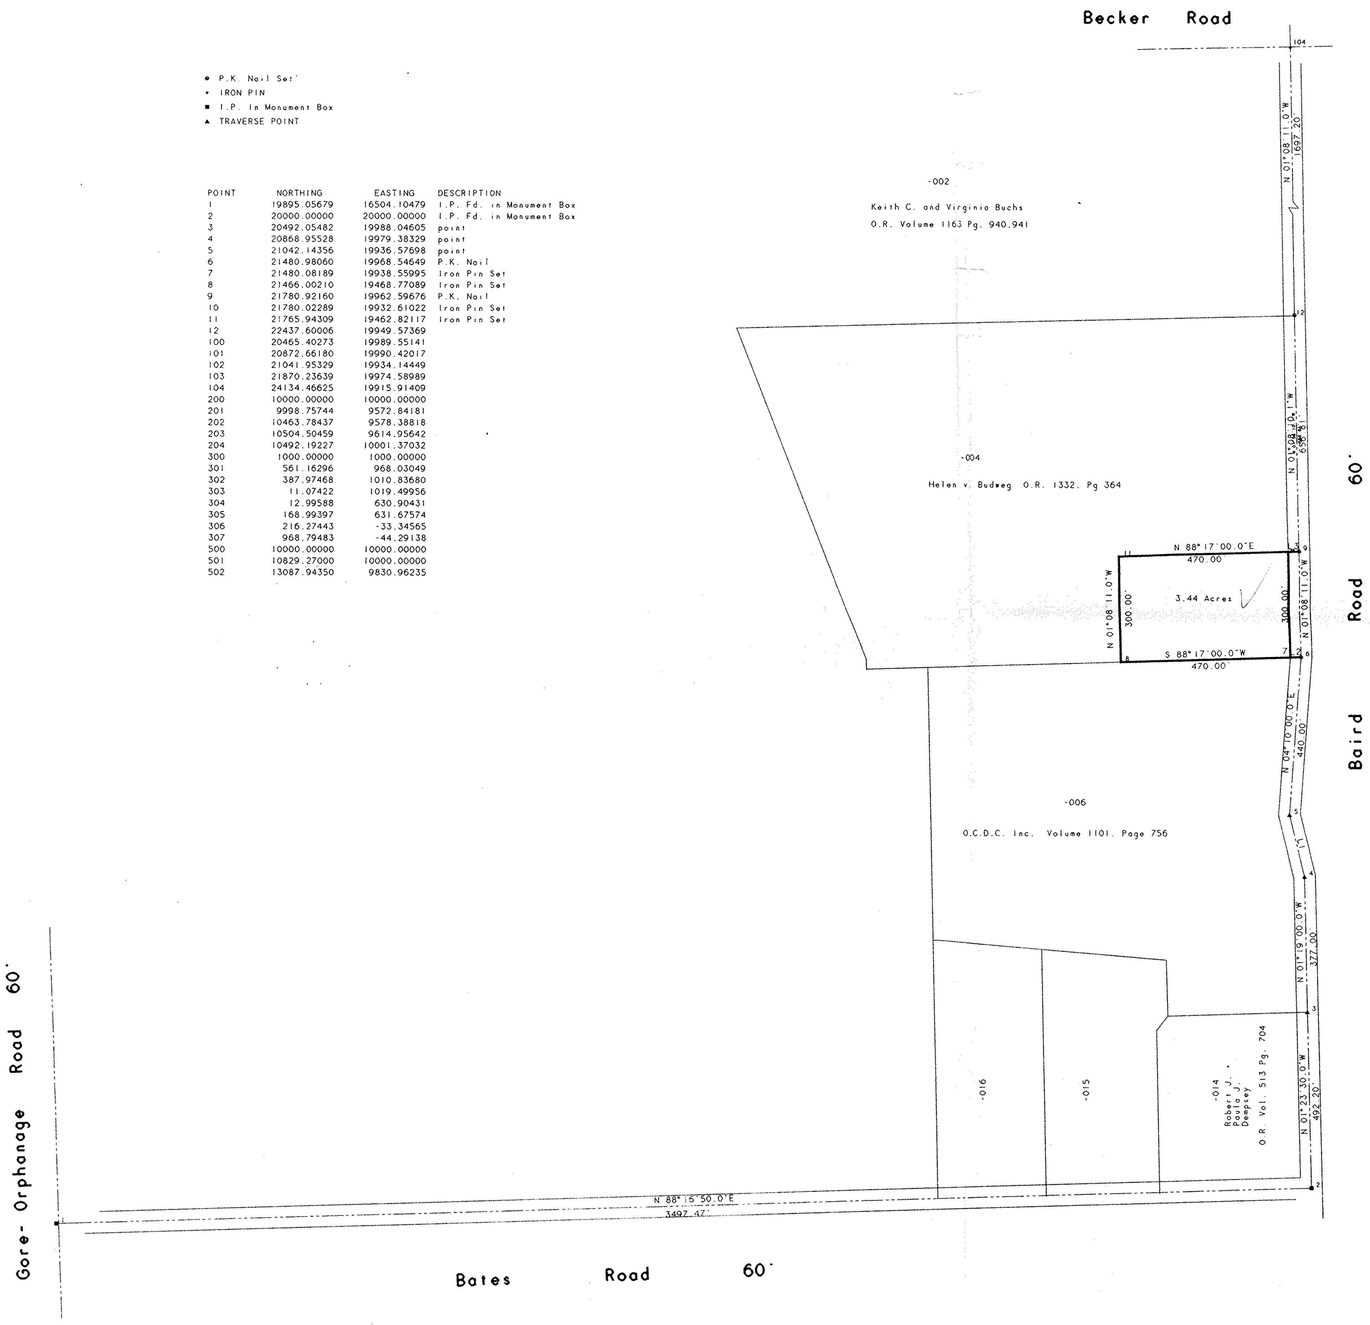


| LINE | BEARING | DISTANCE |
|---|---|---|
| L 1 | N 13°53'00.0"W | 178.40' |
| L 2 | S 88°17'00.0"W | 30.00' |
| L 3 | N 88°17'00.0"E | 30.00' |

0' 200'
Scale 1" = 200'
May 14, 1997

Note: Bearings shown are to an assumed meridian and are used to describe angles only.

Note: Only copies signed with Red Ink shall be considered Valid.

Patrick A. McGannon
Patrick A. McGannon P.S. 7154

Prepared for Mr. Budweg
of 51991 Becker Road
Wakeman, Ohio 44889

Being known as part of Original Lot 13 of the township of Henrietta in County of Lorain, in the State of Ohio.

#22323

APPROVED
LORAIN CO.
MAP DEPT
DATE 10/23/97
PAGE 8-E
BY K. Colbert

Boundary Survey (Lot Split)

Patrick A. McGannon. Registered Professional Surveyor

1731 Gettysburg Drive, Lorain, Ohio (216) 282-2712

STATE OF OHIO
PATRICK A. McGANNON
7154
REGISTERED
PROFESSIONAL SURVEYOR