#21456

Need Qc.
breakdown on
Survey Map
LATEST REVISION IS IN
"SPLIT" SURVEY MAPS YET
TO BE FILED 9-18-95 - THROW
THESE OUT ONCE REV. IS FOUND

JESSIE BORN
08-12-005-000-014

PLAT OF SURVEY FOR
LOT SPLITS
MRS. VIOLA BUCHS

HENRIETTA TOWNSHIP, LORAIN
COUNTY, OHIO.

BEING A PART OF HENRIETTA TOWNSHIP, LORAIN COUNTY, OHIO AND A PART OF ORIGINAL TOWNSHIP LOTS 4 AND 5, TRACT 12.

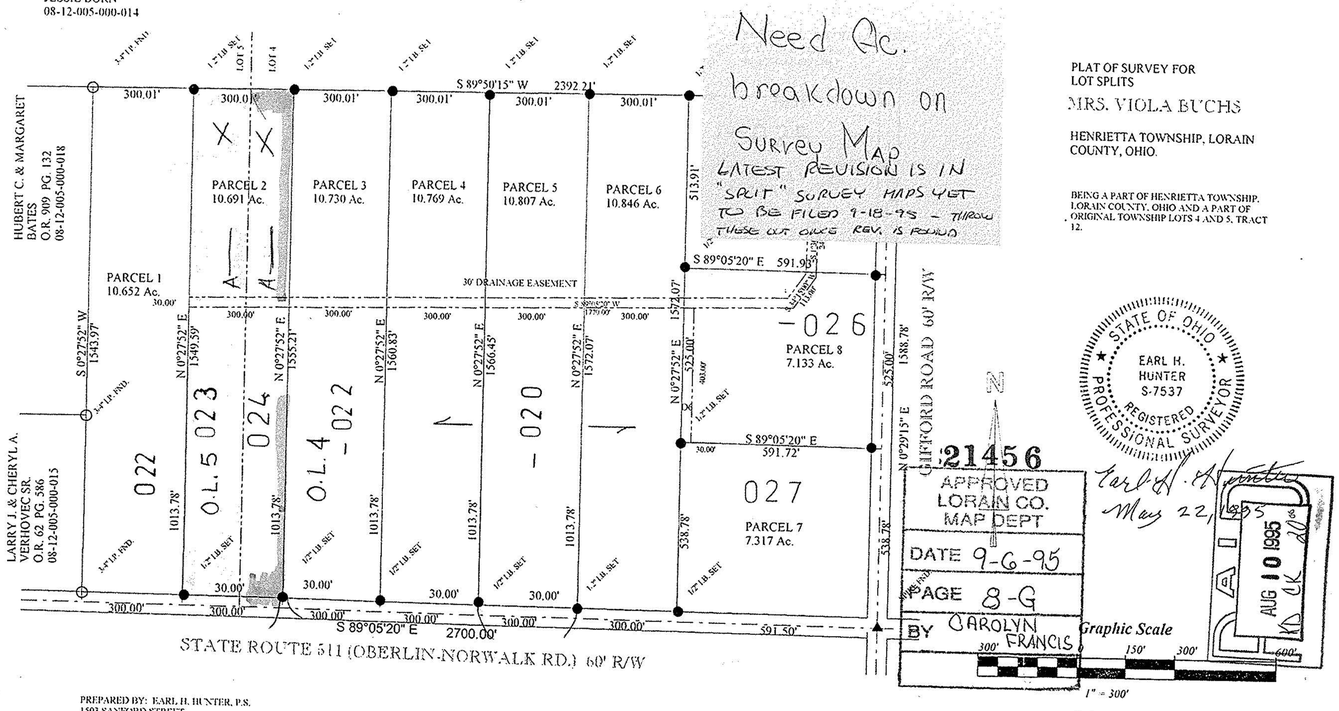


STATE OF OHIO
EARL H. HUNTER
S-7537
REGISTERED
PROFESSIONAL SURVEYOR

Earl H. Hunter
May 22, 1995

21456
APPROVED
LORAIN CO.
MAP DEPT
DATE 9-6-95
PAGE 8-G
BY CAROLYN FRANCIS

AUG 10 1995
KD CK 20"

Graphic Scale
300' 0 150' 300' 600'
1" = 300'

MARCH 15, 1995

PREPARED BY: EARL H. HUNTER, P.S.
1503 SANFORD STREET
VERMILION, OHIO 44089
(216) 967-2037

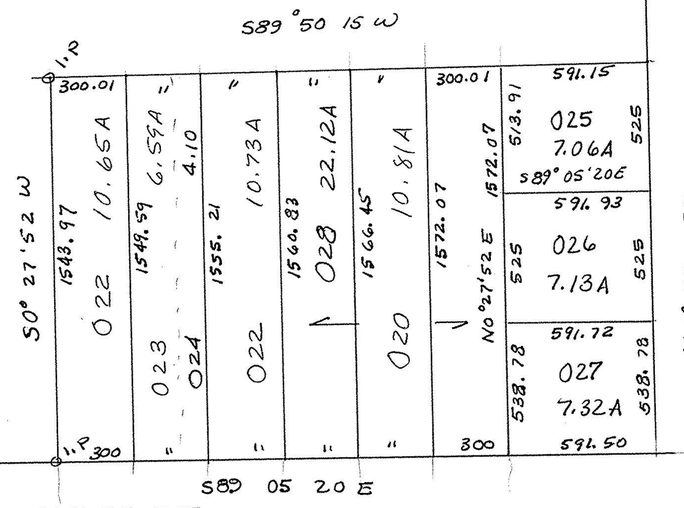


— TAX MAP OFF —

SPLIT MAP R/W DO NOT LINE UP.

1800
591.50

#21456

JESSIE BORN
08-12-005-000-014

ROBERT W. & EDITH J. RONEZ
D.V. 1277 PG. 186
08-12-004-000-013

Need Ac breakdown on Survey Map #21456




STATE OF OHIO
EARL H. HUNTER
S-7537
REGISTERED
PROFESSIONAL SURVEYOR

Earl H. Hunter
Aug 28, 1995

21456
APPROVED
LORAIN CO.
MAP DEPT
DATE 9-6-95
PAGE 8-G
BY CAROLYN FRANCIS
#21456

Graphic Scale
300' 0 150' 300' 600'
1" = 300'

MARCH 15, 1995

PREPARED BY: EARL H. HUNTER, P.S.
1503 SANFORD STREET
VERMILION, OHIO 44089
(216) 967-2037

21456

JESSIE BORN
08-12-005-000-014

ROBERT W. & EDITH J. RONEZ
D.V. 1277 PG. 186
08-12-004-000-013

PLAT OF SURVEY FOR
LOT SPLITS
MRS. VIOLA BUCHS

HENRIETTA TOWNSHIP, LORAIN
COUNTY, OHIO.

BEING A PART OF HENRIETTA TOWNSHIP, LORAIN COUNTY, OHIO AND A PART OF ORIGINAL TOWNSHIP LOTS 4 AND 5, TRACT 12.




STATE OF OHIO
EARL H. HUNTER
S-7537
REGISTERED
PROFESSIONAL SURVEYOR

Graphic Scale
300' 0 150' 300' 600'
1" = 300'

MARCH 15, 1995

PREPARED BY: EARL H. HUNTER, P.S.
1503 SANFORD STREET
VERMILION, OHIO 44089
(216) 967-2037