Map of location Bldgs.
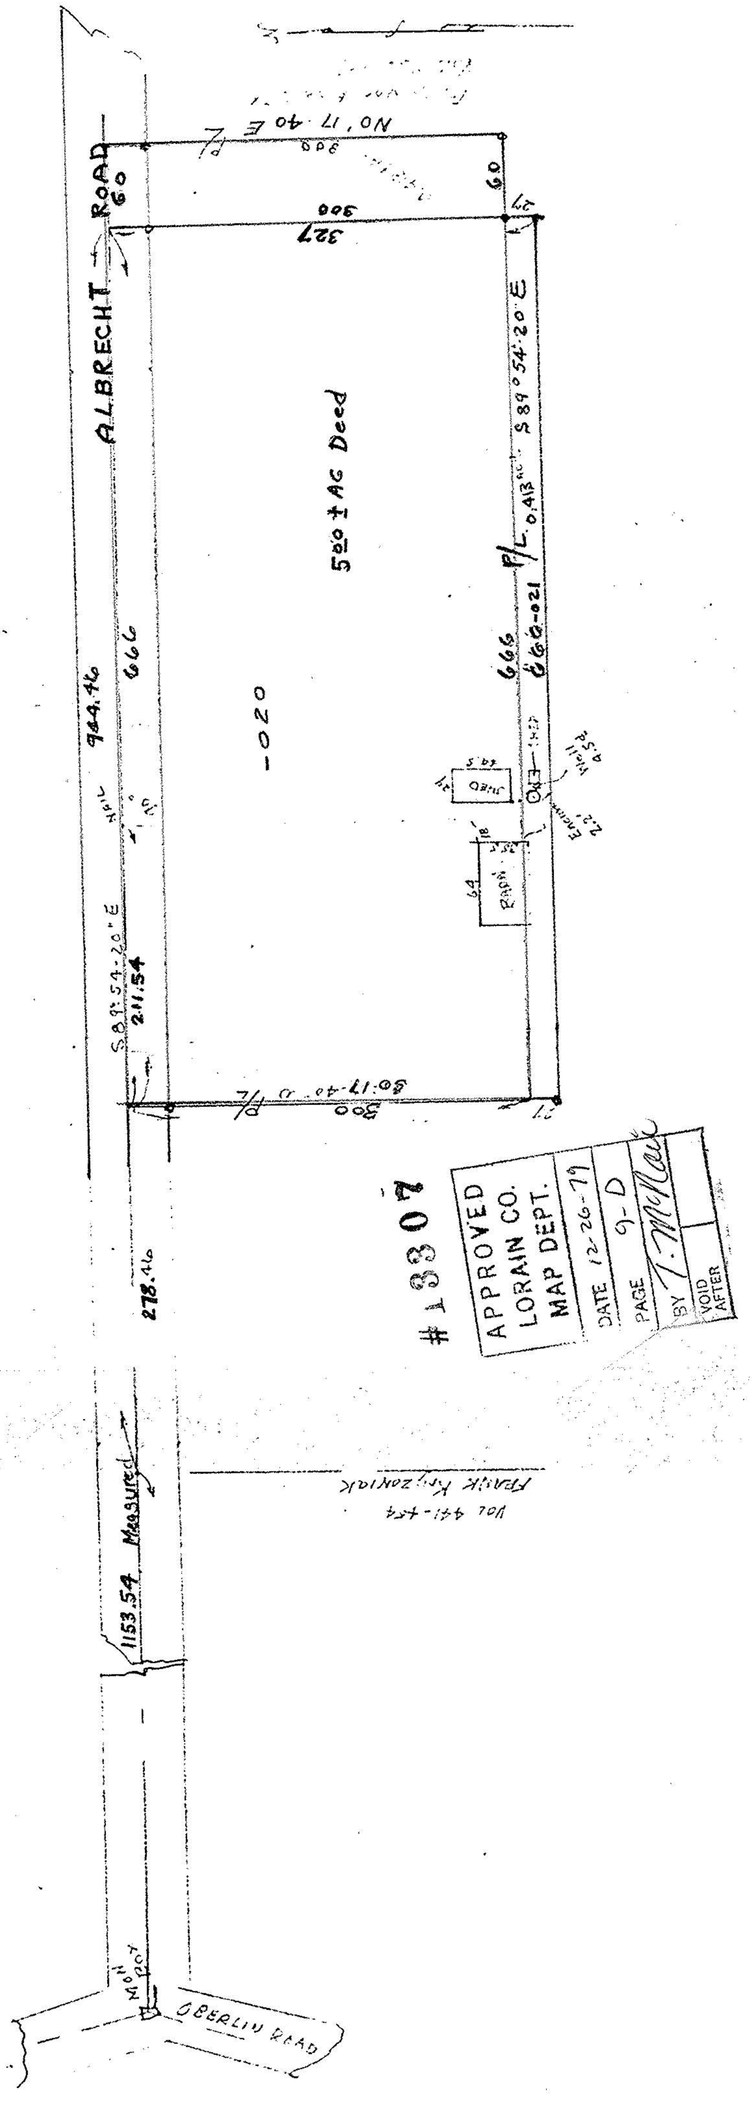
Survey Nov. 29, 1979 request Attorney Martin Conry
In accordance with description furnished by Conry