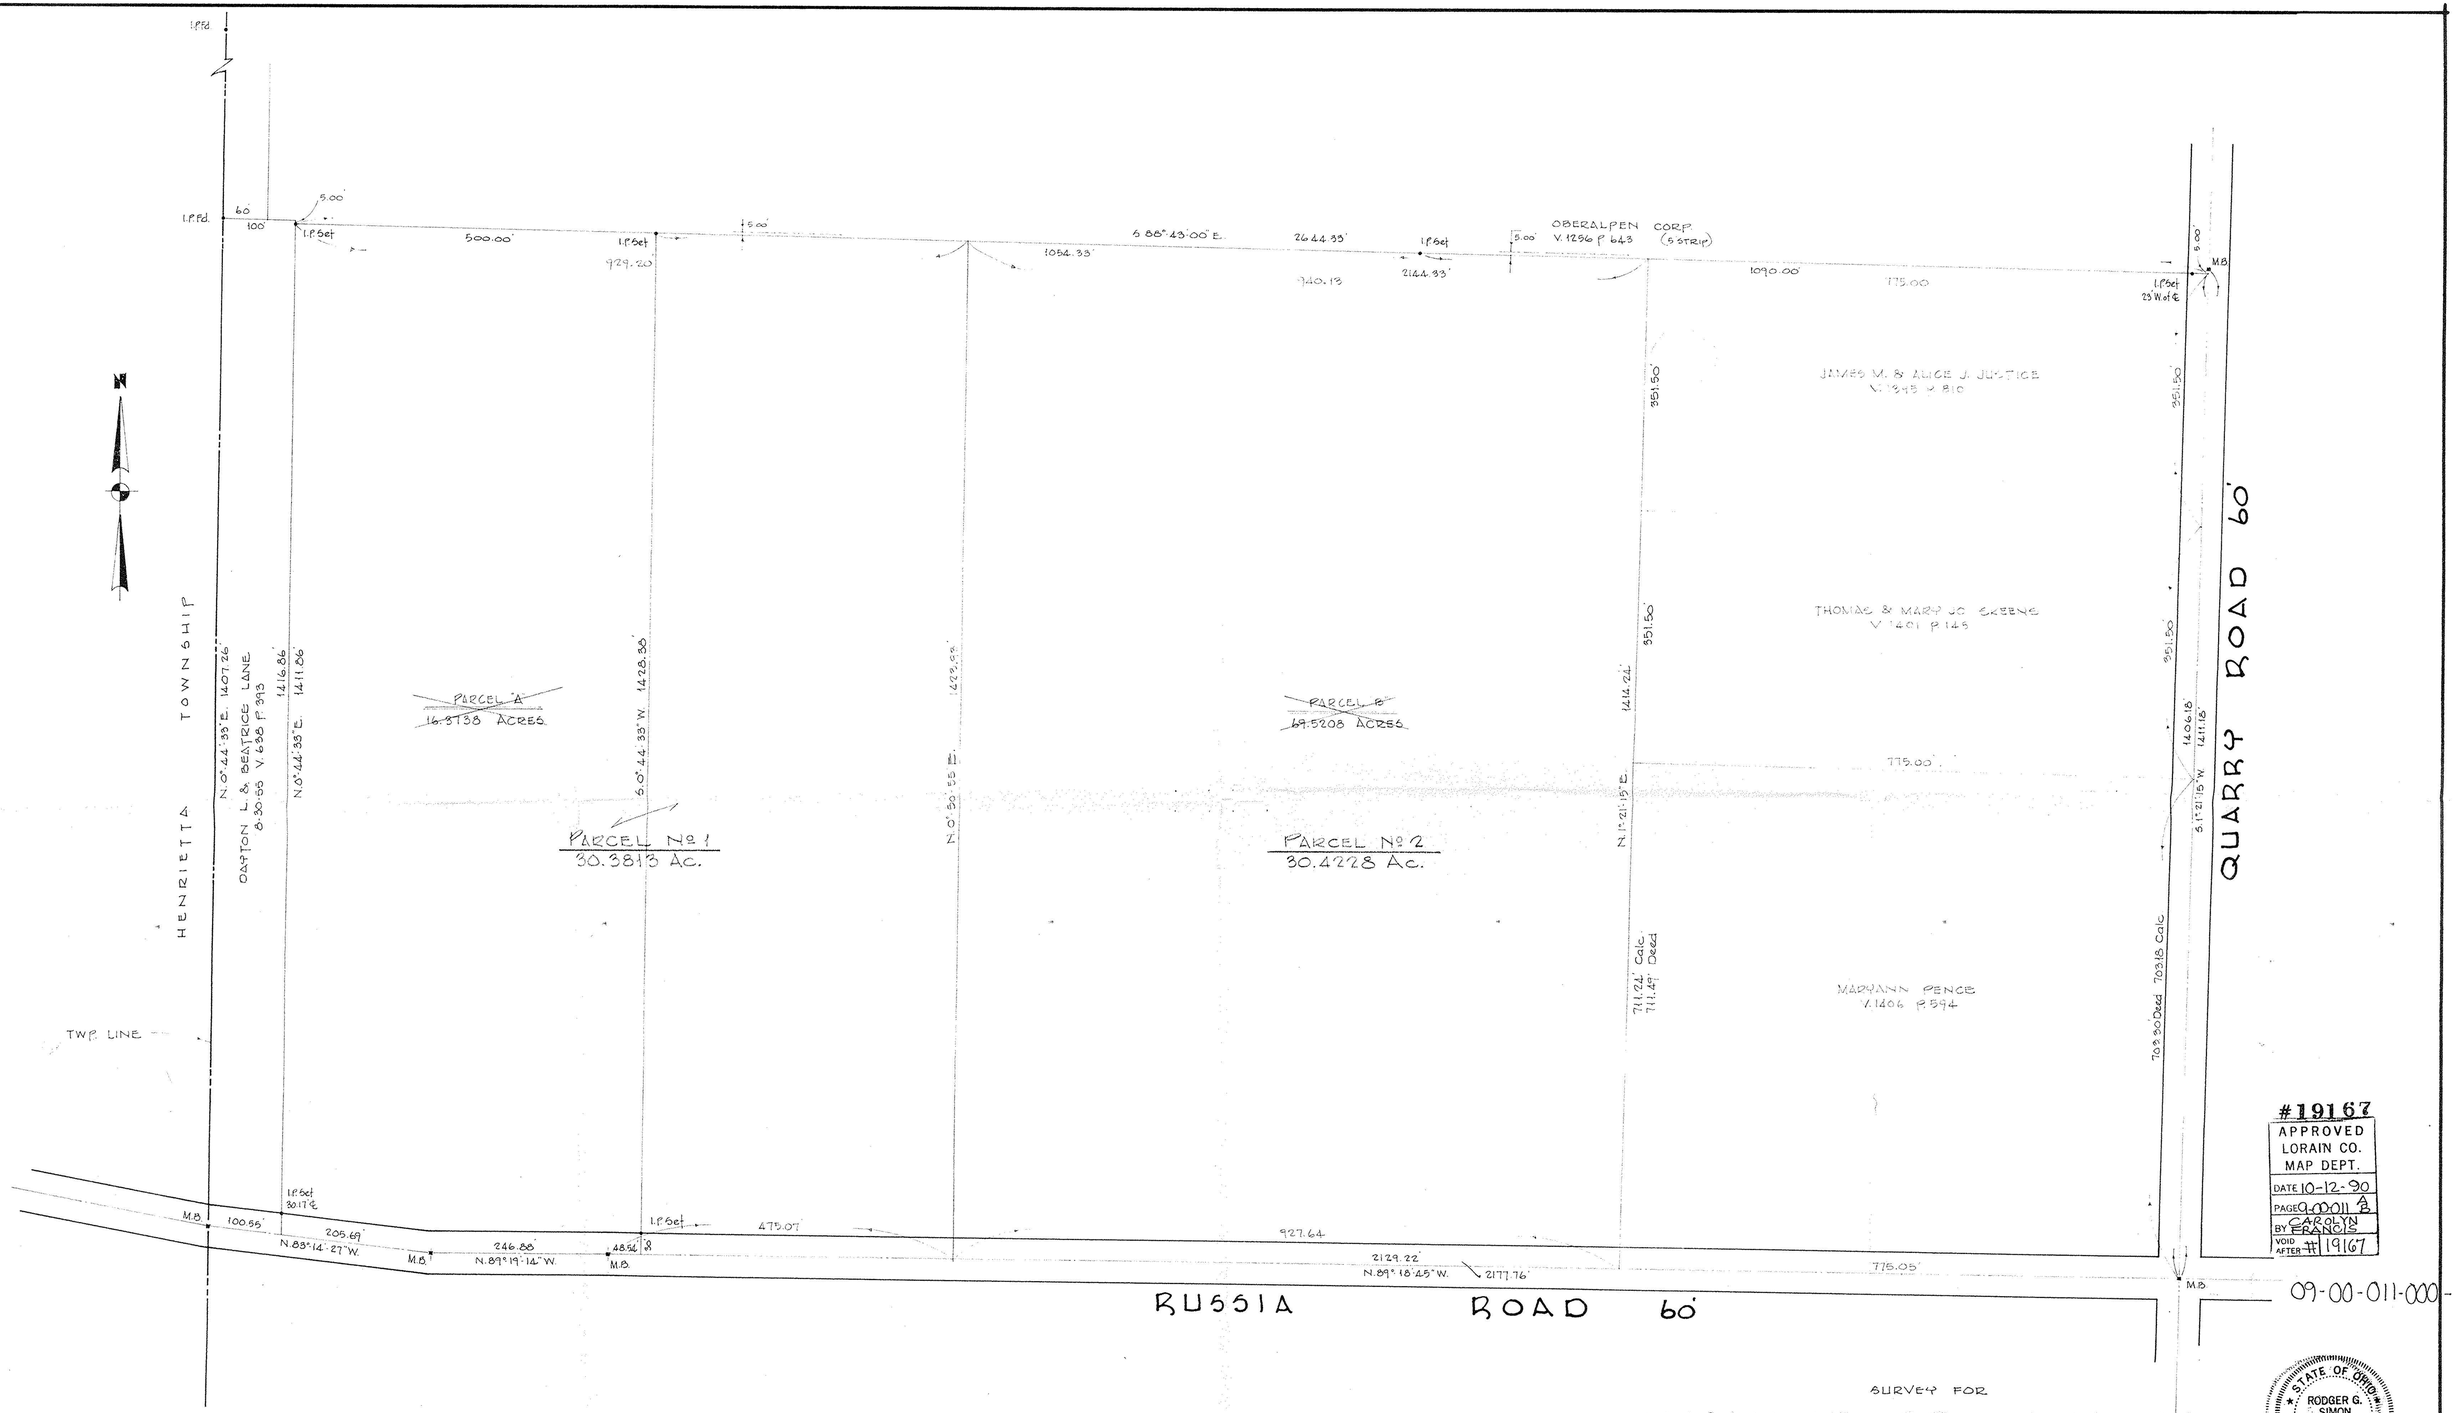

#19167
APPROVED
LORAIN CO.
MAP DEPT.
DATE 10-12-90
PAGE 09-00011 A
BY CAROLYN FRANCIS
VOID AFTER #19167

STATE OF OHIO
RODGER G. SIMON
5101
REGISTERED SURVEYOR
AUG 22

SURVEY FOR

ALMON R. BROCKSIEKER

PART OF O.L. 11 RUSSIA TOWNSHIP LORAIN COUNTY OHIO
SCALE 1"=100' OCTOBER 18, 1984
LAUNDON • SIMON • CAHL & ASSOC.
ENGINEERS SURVEYORS

REV. AUG. '90 DELETE PCL'S A&B / CREATED PCL'S. 1 & 2 R.G.S. JOB Nº 90-1962

Job No. 84-1327 F.B. 98 P. 57