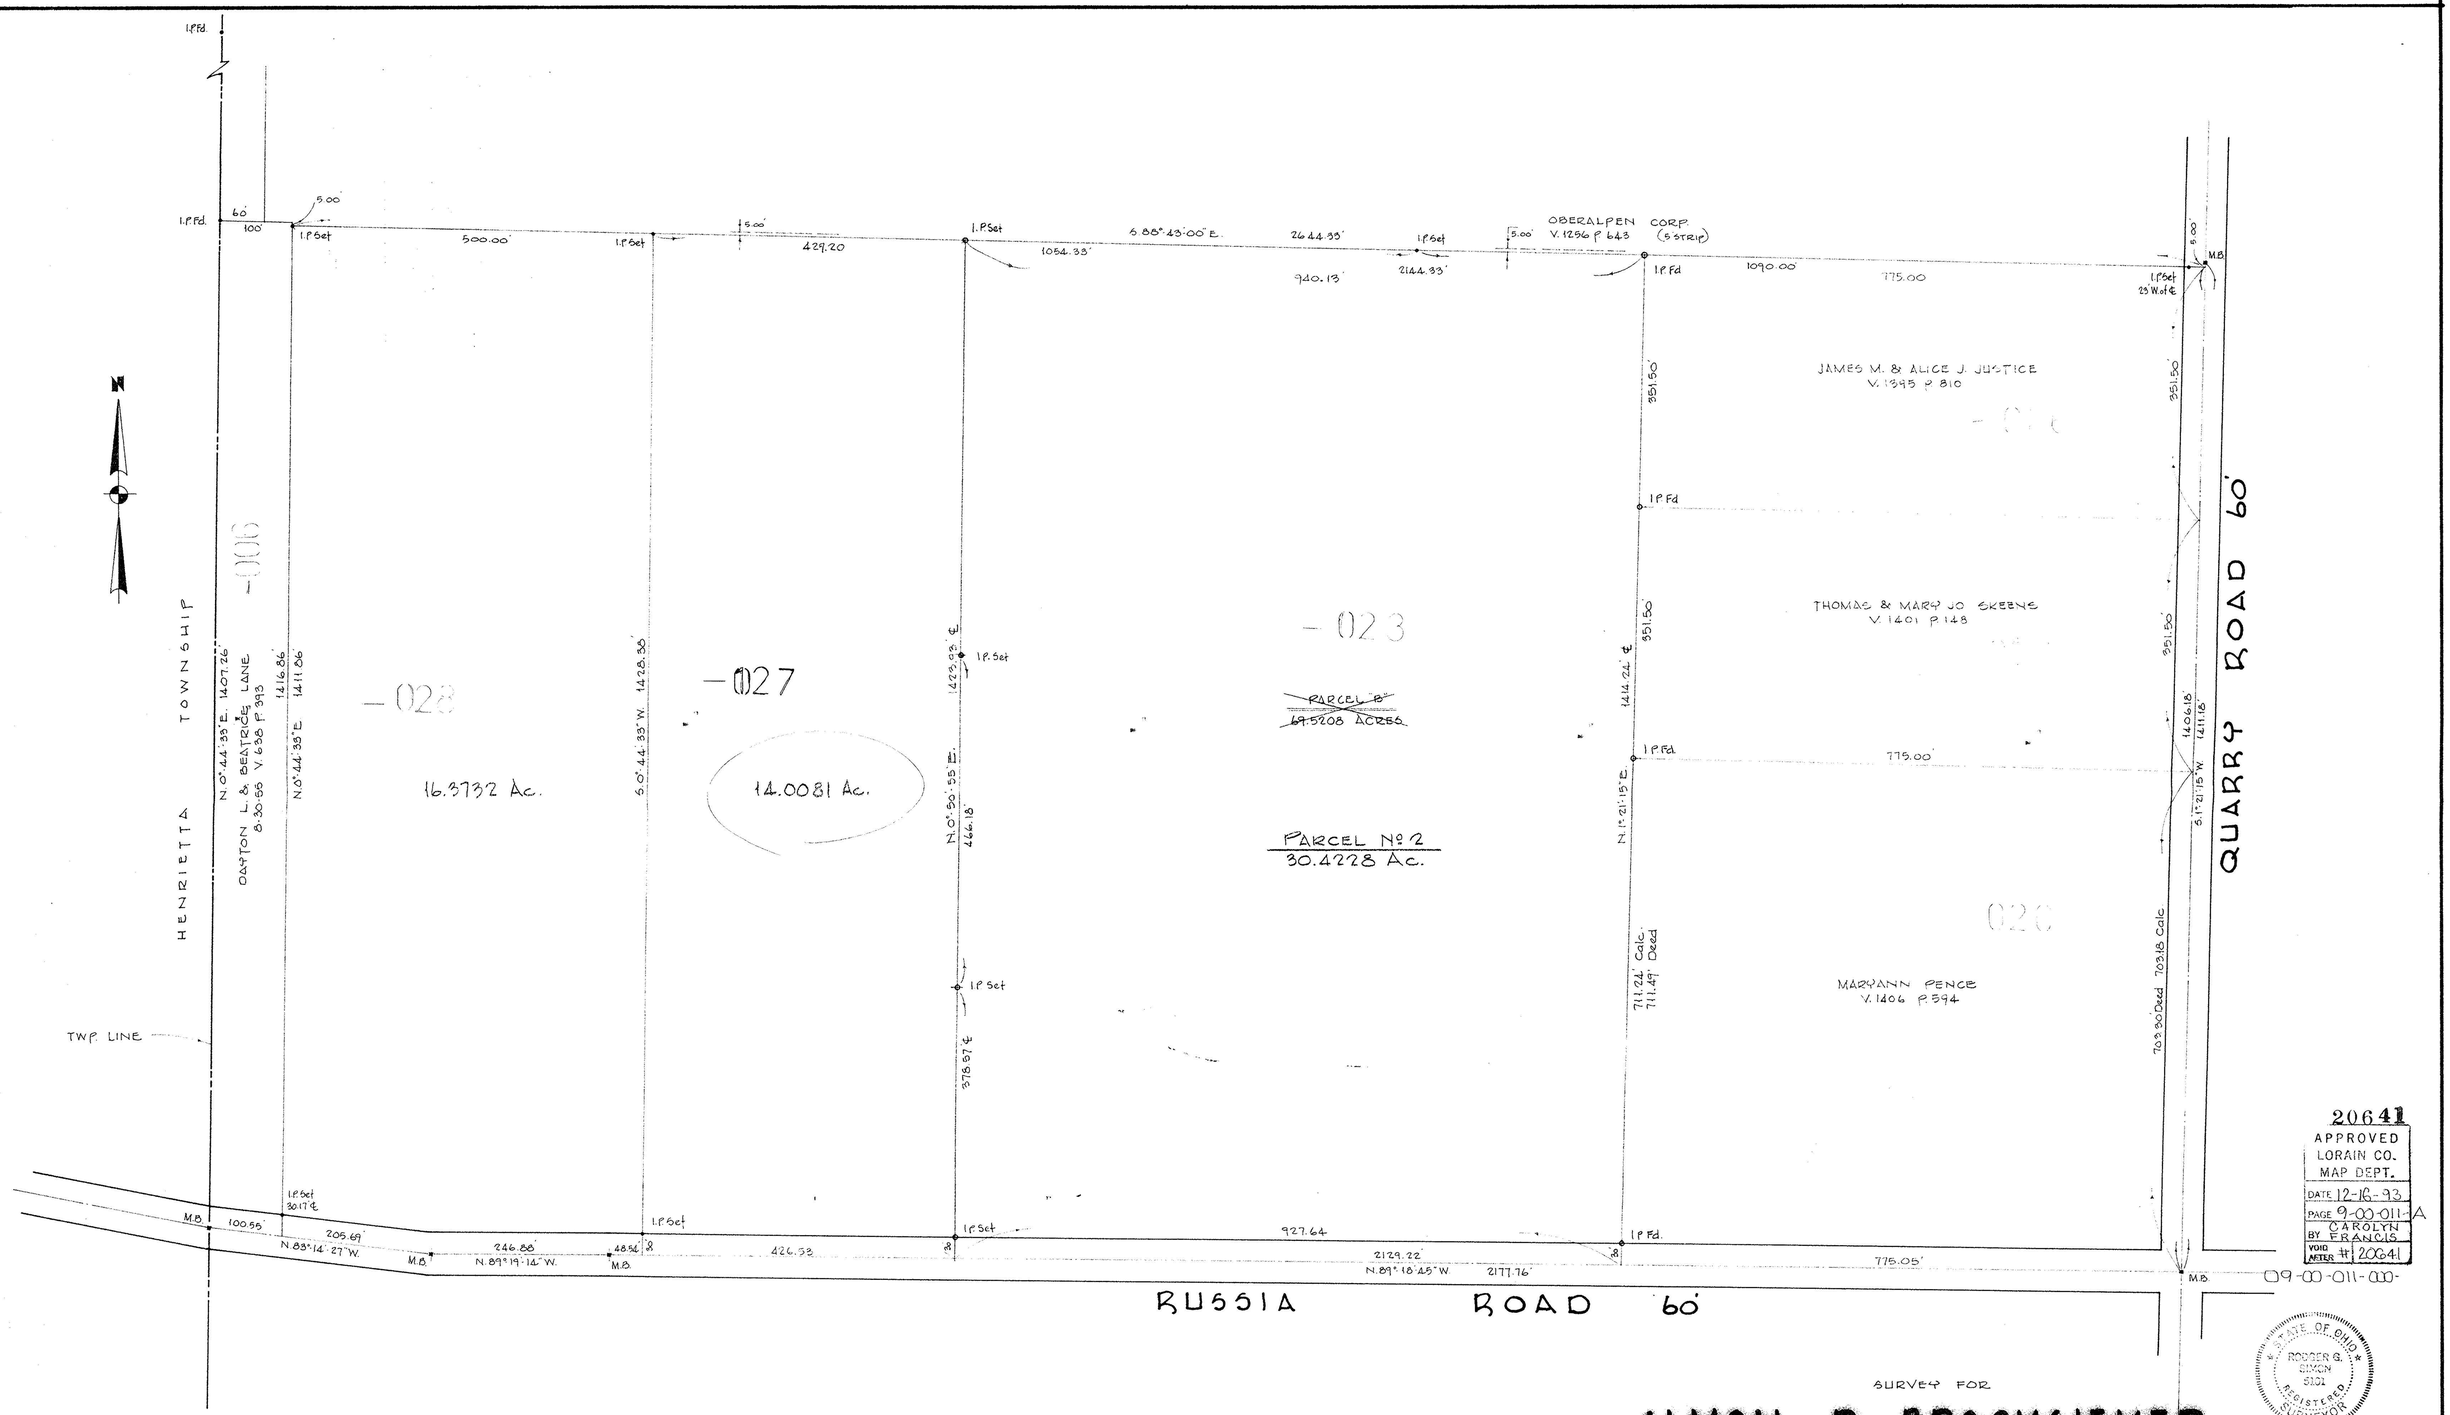

SURVEY FOR

ALMON R. BROCKSIEKER

PART OF O.L. 11 RUSSIA TOWNSHIP LORAIN COUNTY OHIO

SCALE 1" = 100' OCTOBER 18, 1984

LAUNDON • SIMON • CAHL & ASSOC.

ENGINEERS SURVEYORS

REV. 10-21-93

REV. 1-6-92 SET IRON PINS W. LINE PCL. 2 FOUND I.Ps E. LINE PCL. 2 FOR T. & D. MAHAR (R.G.S.)

REV. AUG. '90 DELETE PCL'S A&B / CREATED PCL'S. 1 & 2 R.G.S. JOB Nº 90-1962

Job No. 84-1327 F.B. 98 P. 57