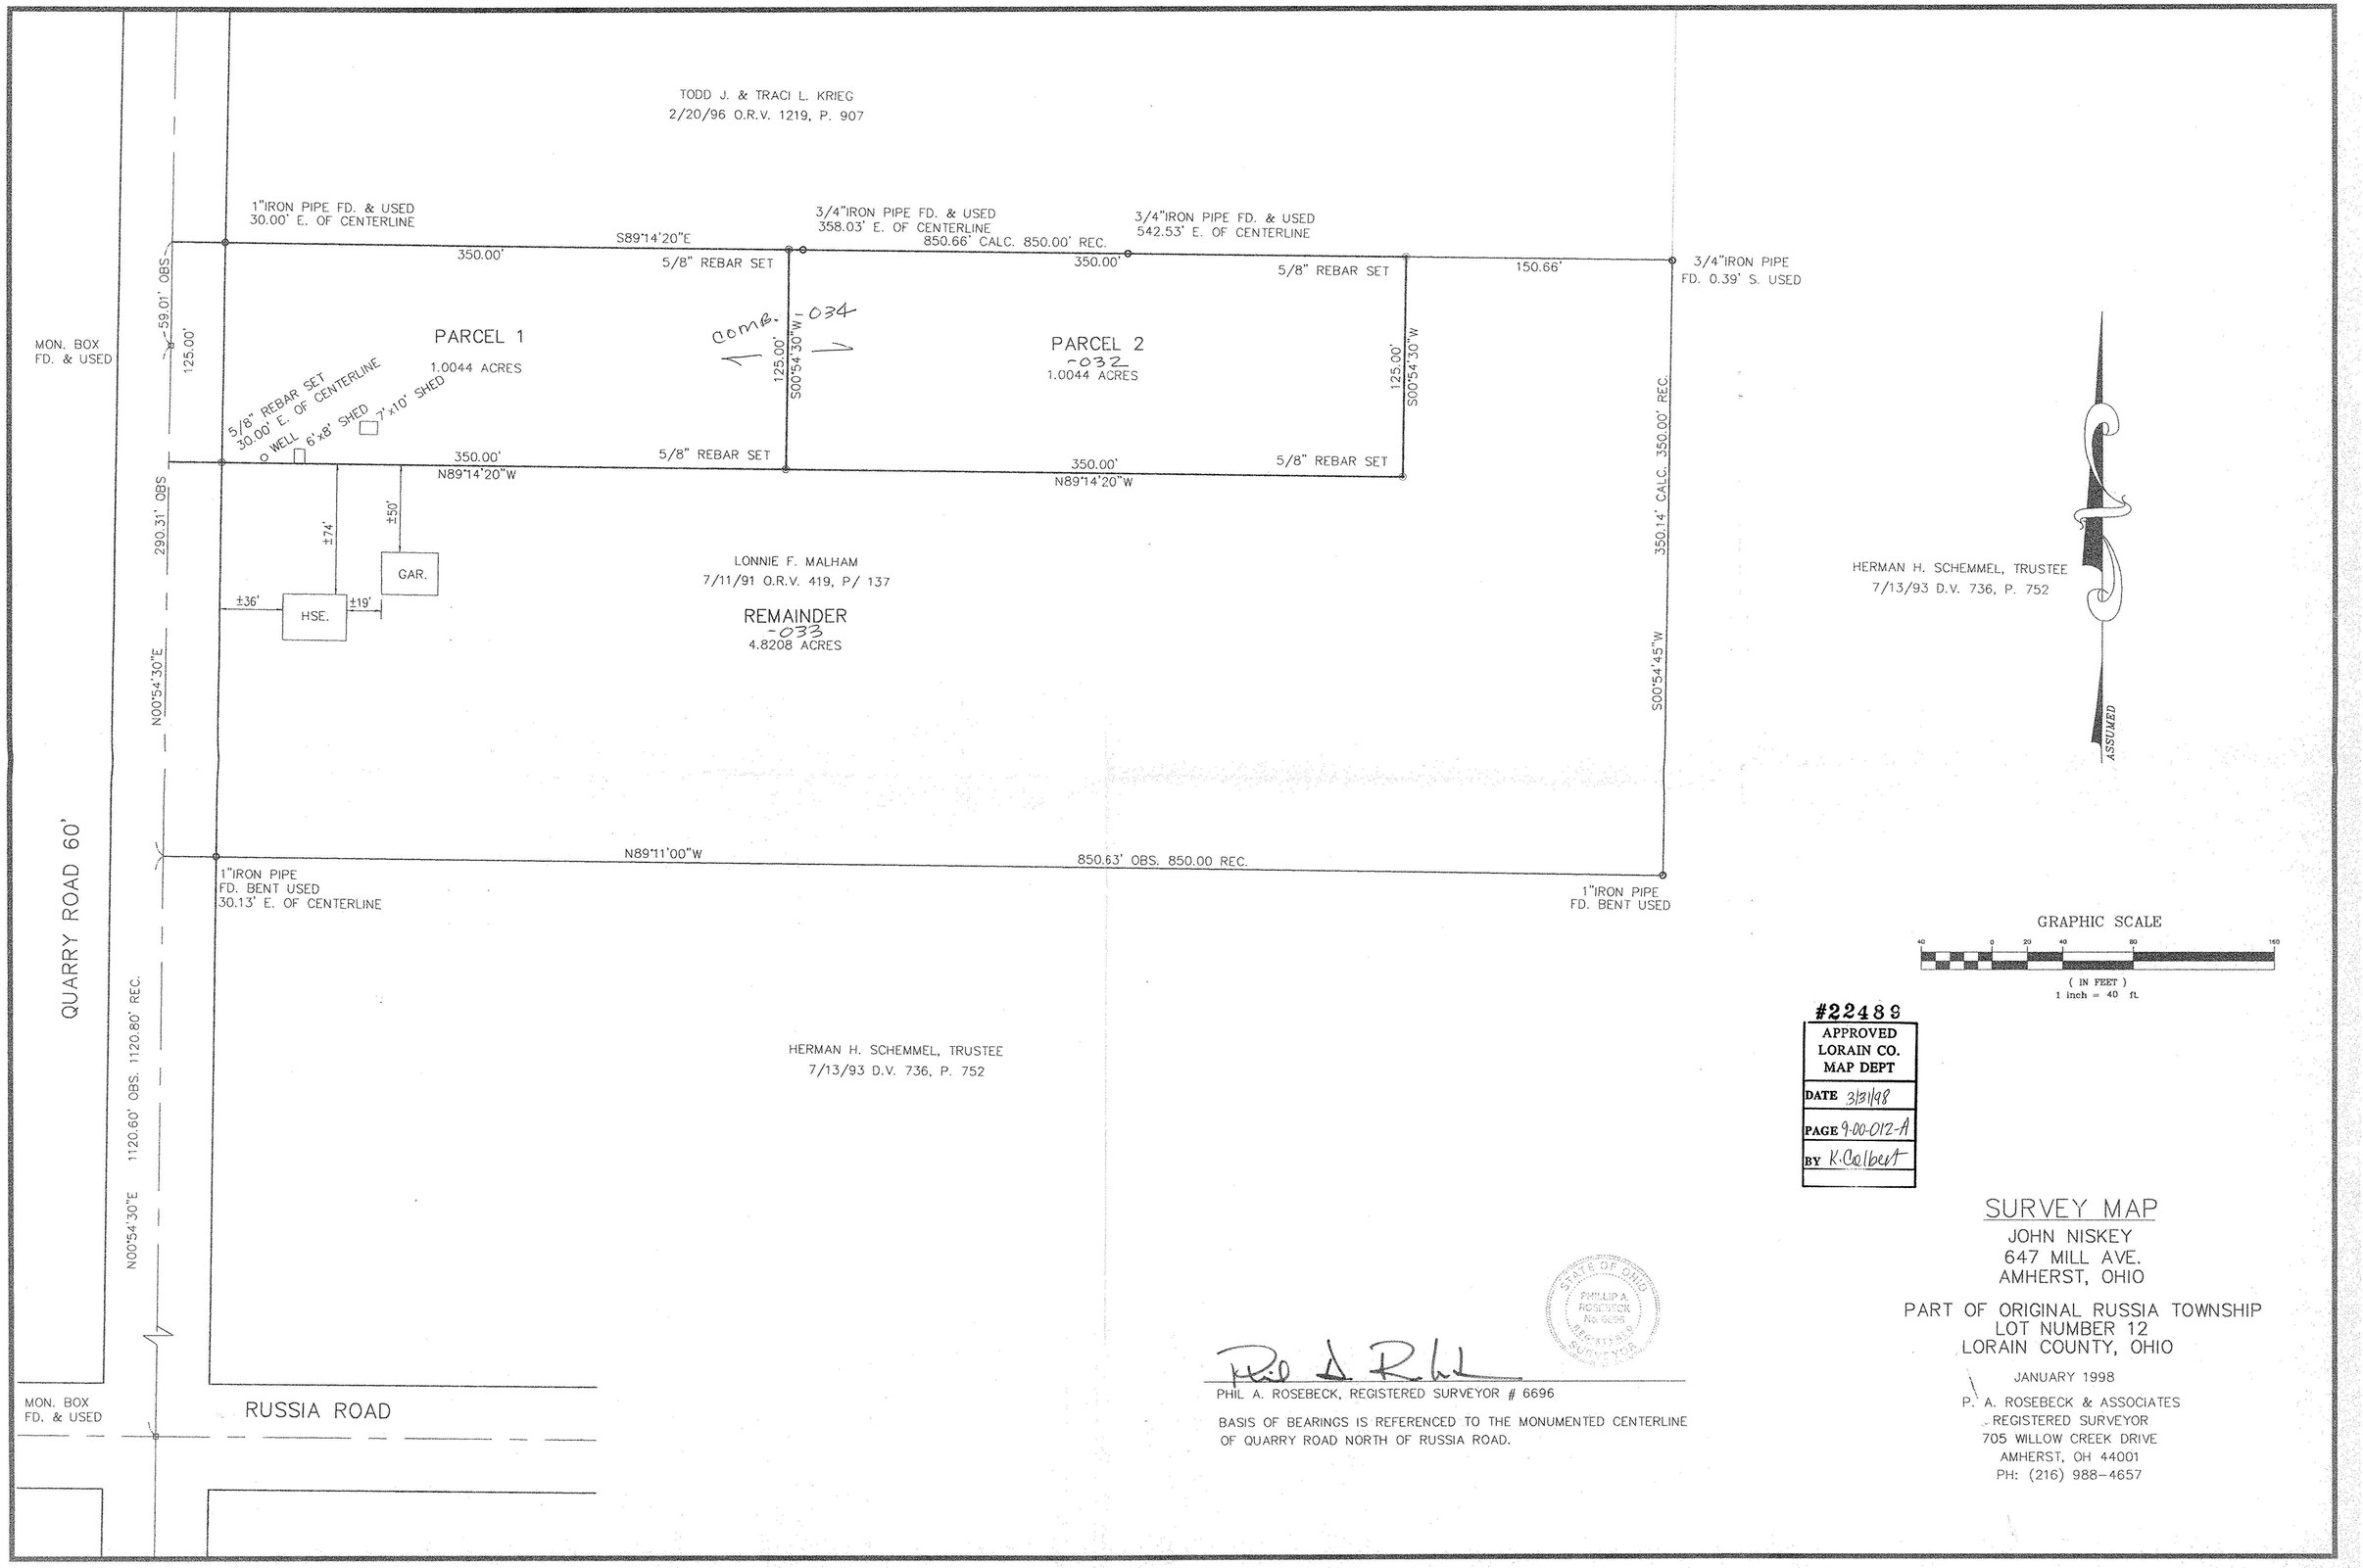
TODD J. & TRACI L. KRIEG
2/20/96 O.R.V. 1219, P. 907
1"IRON PIPE FD. & USED
30.00' E. OF CENTERLINE
S89°14'20"E
350.00'
5/8" REBAR SET
3/4"IRON PIPE FD. & USED
358.03' E. OF CENTERLINE
850.66' CALC. 850.00' REC.
3/4"IRON PIPE FD. & USED
542.53' E. OF CENTERLINE
350.00'
5/8" REBAR SET
150.66'
3/4"IRON PIPE
FD. 0.39' S. USED
MON. BOX
FD. & USED
59.01' OBS.
125.00'
PARCEL 1
1.0044 ACRES
comb. -034
125.00'
S00°54'30"W
PARCEL 2
-032
1.0044 ACRES
125.00'
S00°54'30"W
5/8" REBAR SET
30.00' E. OF CENTERLINE
WELL
6'x8' SHED
7'x10' SHED
350.00'
N89°14'20"W
5/8" REBAR SET
350.00'
N89°14'20"W
5/8" REBAR SET
350.14' CALC. 350.00' REC.
S00°54'45"W
290.31' OBS
±74'
±50'
GAR.
±36'
HSE.
±19'
LONNIE F. MALHAM
7/11/91 O.R.V. 419, P/ 137
REMAINDER
-033
4.8208 ACRES
HERMAN H. SCHEMMEL, TRUSTEE
7/13/93 D.V. 736, P. 752
ASSUMED
N00°54'30"E
QUARRY ROAD 60'
N89°11'00"W
850.63' OBS. 850.00 REC.
1"IRON PIPE
FD. BENT USED
30.13' E. OF CENTERLINE
1"IRON PIPE
FD. BENT USED
N00°54'30"E
1120.60' OBS. 1120.80' REC.
HERMAN H. SCHEMMEL, TRUSTEE
7/13/93 D.V. 736, P. 752
MON. BOX
FD. & USED
RUSSIA ROAD
GRAPHIC SCALE
40 0 20 40 80 160
(IN FEET)
1 inch = 40 ft.
#22489
APPROVED
LORAIN CO.
MAP DEPT
DATE 3/31/98
PAGE 9-00-012-A
BY K. Colbert
STATE OF OHIO
PHILLIP A.
ROSEBECK
No. 6696
REGISTERED
SURVEYOR
PHIL A. ROSEBECK, REGISTERED SURVEYOR # 6696
BASIS OF BEARINGS IS REFERENCED TO THE MONUMENTED CENTERLINE
OF QUARRY ROAD NORTH OF RUSSIA ROAD.
SURVEY MAP
JOHN NISKEY
647 MILL AVE.
AMHERST, OHIO
PART OF ORIGINAL RUSSIA TOWNSHIP
LOT NUMBER 12
LORAIN COUNTY, OHIO
JANUARY 1998
P. A. ROSEBECK & ASSOCIATES
REGISTERED SURVEYOR
705 WILLOW CREEK DRIVE
AMHERST, OH 44001
PH: (216) 988-4657