MAP OF SURVEY AND LOT SPLIT

FOR

BARBARA J. HILL

SITUATED IN THE VILLAGE OF SOUTH AMHERST, COUNTY OF LORAIN, STATE OF OHIO AND BEING KNOWN AS PART OF ORIGINAL RUSSIA TOWNSHIP LOT NO. 13 AND 14.

SURVEYOR'S STATEMENT

DISTANCES ARE EXPRESSED IN FEET AND DECIMAL PARTS THEREOF. BEARINGS ARE BASED ON GYRAL 1959, PRELIMINARY ADJUSTED GEOGRAPHIC POSITIONS COMPILED FROM RECORDS AT THE LORAIN COUNTY ENGINEER'S OFFICE. PERMANENT MONUMENTS WERE FOUND OR SET AS INDICATED HEREON. ALL OF WHICH I DECLARE TO BE CORRECT.

Thomas M. Snezek
THOMAS M. SNEZEK P.S. 7051

STATE OF OHIO — THOMAS M. SNEZEK S-7051 — SURVEYOR

09-00-014-101-

19752
APPROVED
LORAIN CO.
MAP DEPT.
DATE 1-30-92
PAGE 9-00-014-B
BY CAROLYN FRANCIS
VOID AFTER # 19752

09-00-013-102
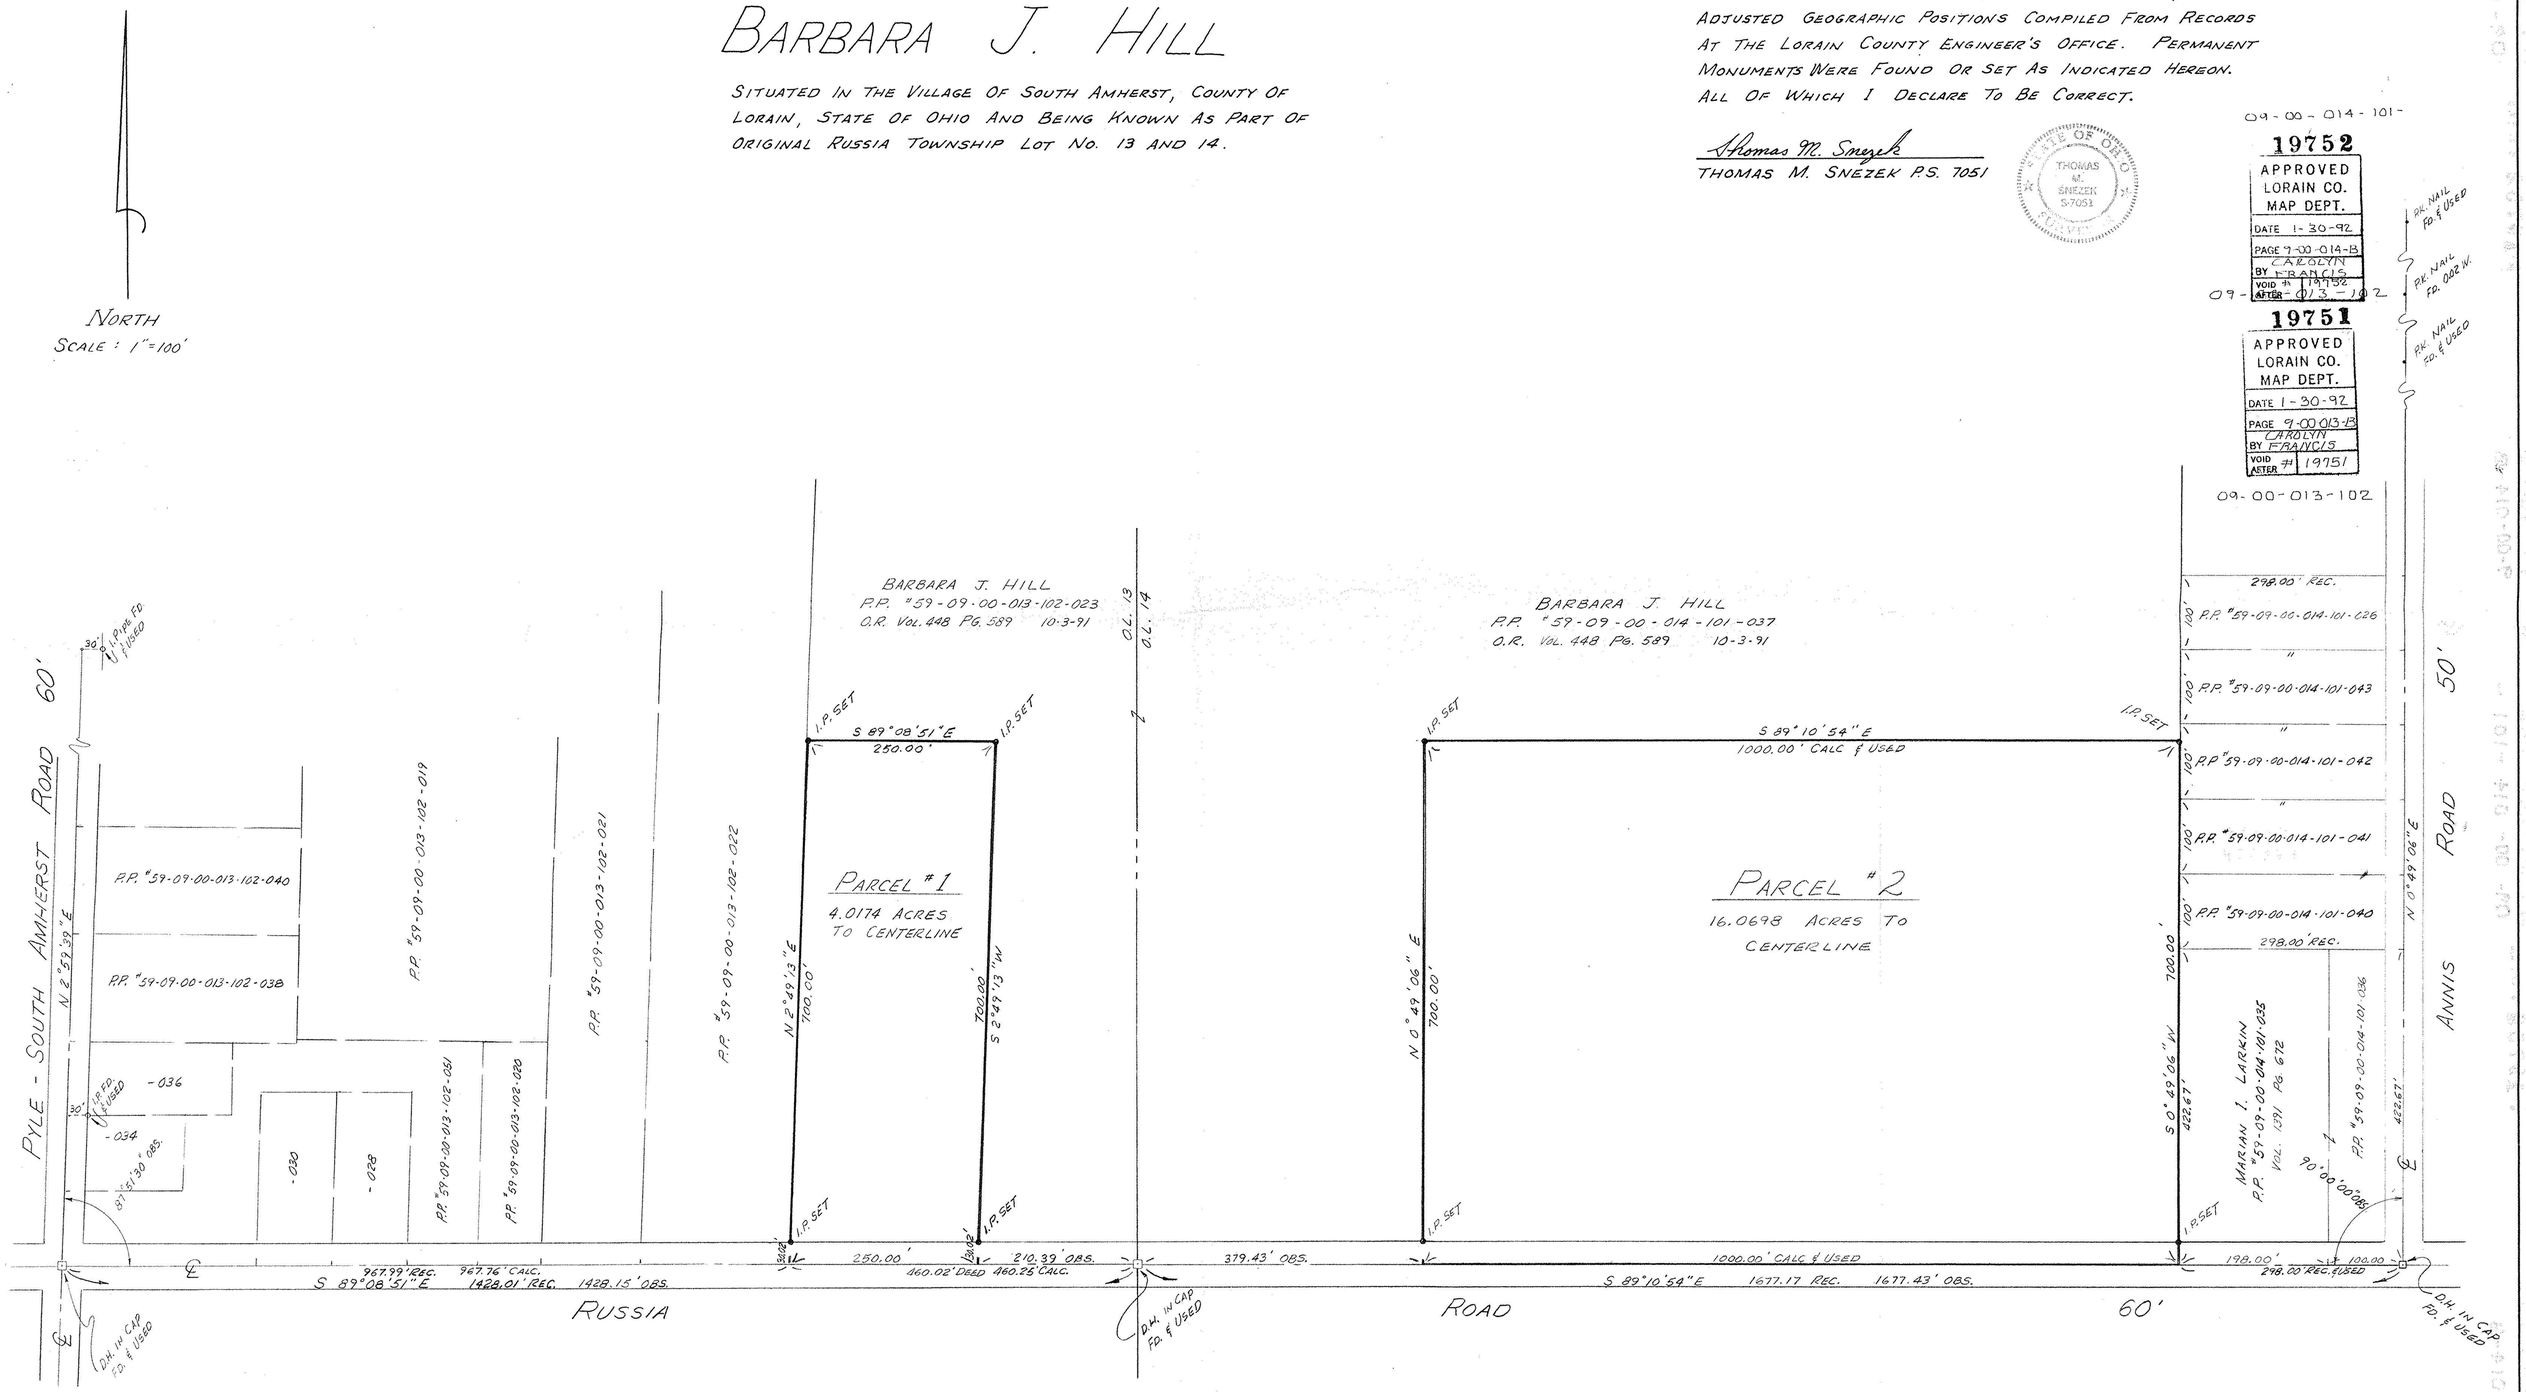
19751
APPROVED
LORAIN CO.
MAP DEPT.
DATE 1-30-92
PAGE 9-00-013-B
BY CAROLYN FRANCIS
VOID AFTER # 19751