MAP OF SURVEY AND LOT SPLIT

FOR

BARBARA J. HILL

SITUATED IN THE VILLAGE OF SOUTH AMHERST, COUNTY OF LORAIN, STATE OF OHIO AND BEING KNOWN AS PART OF ORIGINAL RUSSIA TOWNSHIP LOT NO. 13 AND 14.

SURVEYOR'S STATEMENT

DISTANCES ARE EXPRESSED IN FEET AND DECIMAL PARTS THEREOF. BEARINGS ARE BASED ON GYRAL 1959, PRELIMINARY ADJUSTED GEOGRAPHIC POSITIONS COMPILED FROM RECORDS AT THE LORAIN COUNTY ENGINEER'S OFFICE. PERMANENT MONUMENTS WERE FOUND OR SET AS INDICATED HEREON. ALL OF WHICH I DECLARE TO BE CORRECT.

Thomas M. Snezek REV. 1-27-92 1-20-92

THOMAS M. SNEZEK P.S. 7051

Approved 2/5/92

Chester Arcaba Mayor

STATE OF OHIO THOMAS M. SNEZEK S-7051

09-00-014-101- 19782

APPROVED LORAIN CO. MAP DEPT.
DATE 2-20-92
PAGE 9-00-014A
BY CAROLYN FRANCIS
VOID AFTER # 19782

09-00-013-102- 19781
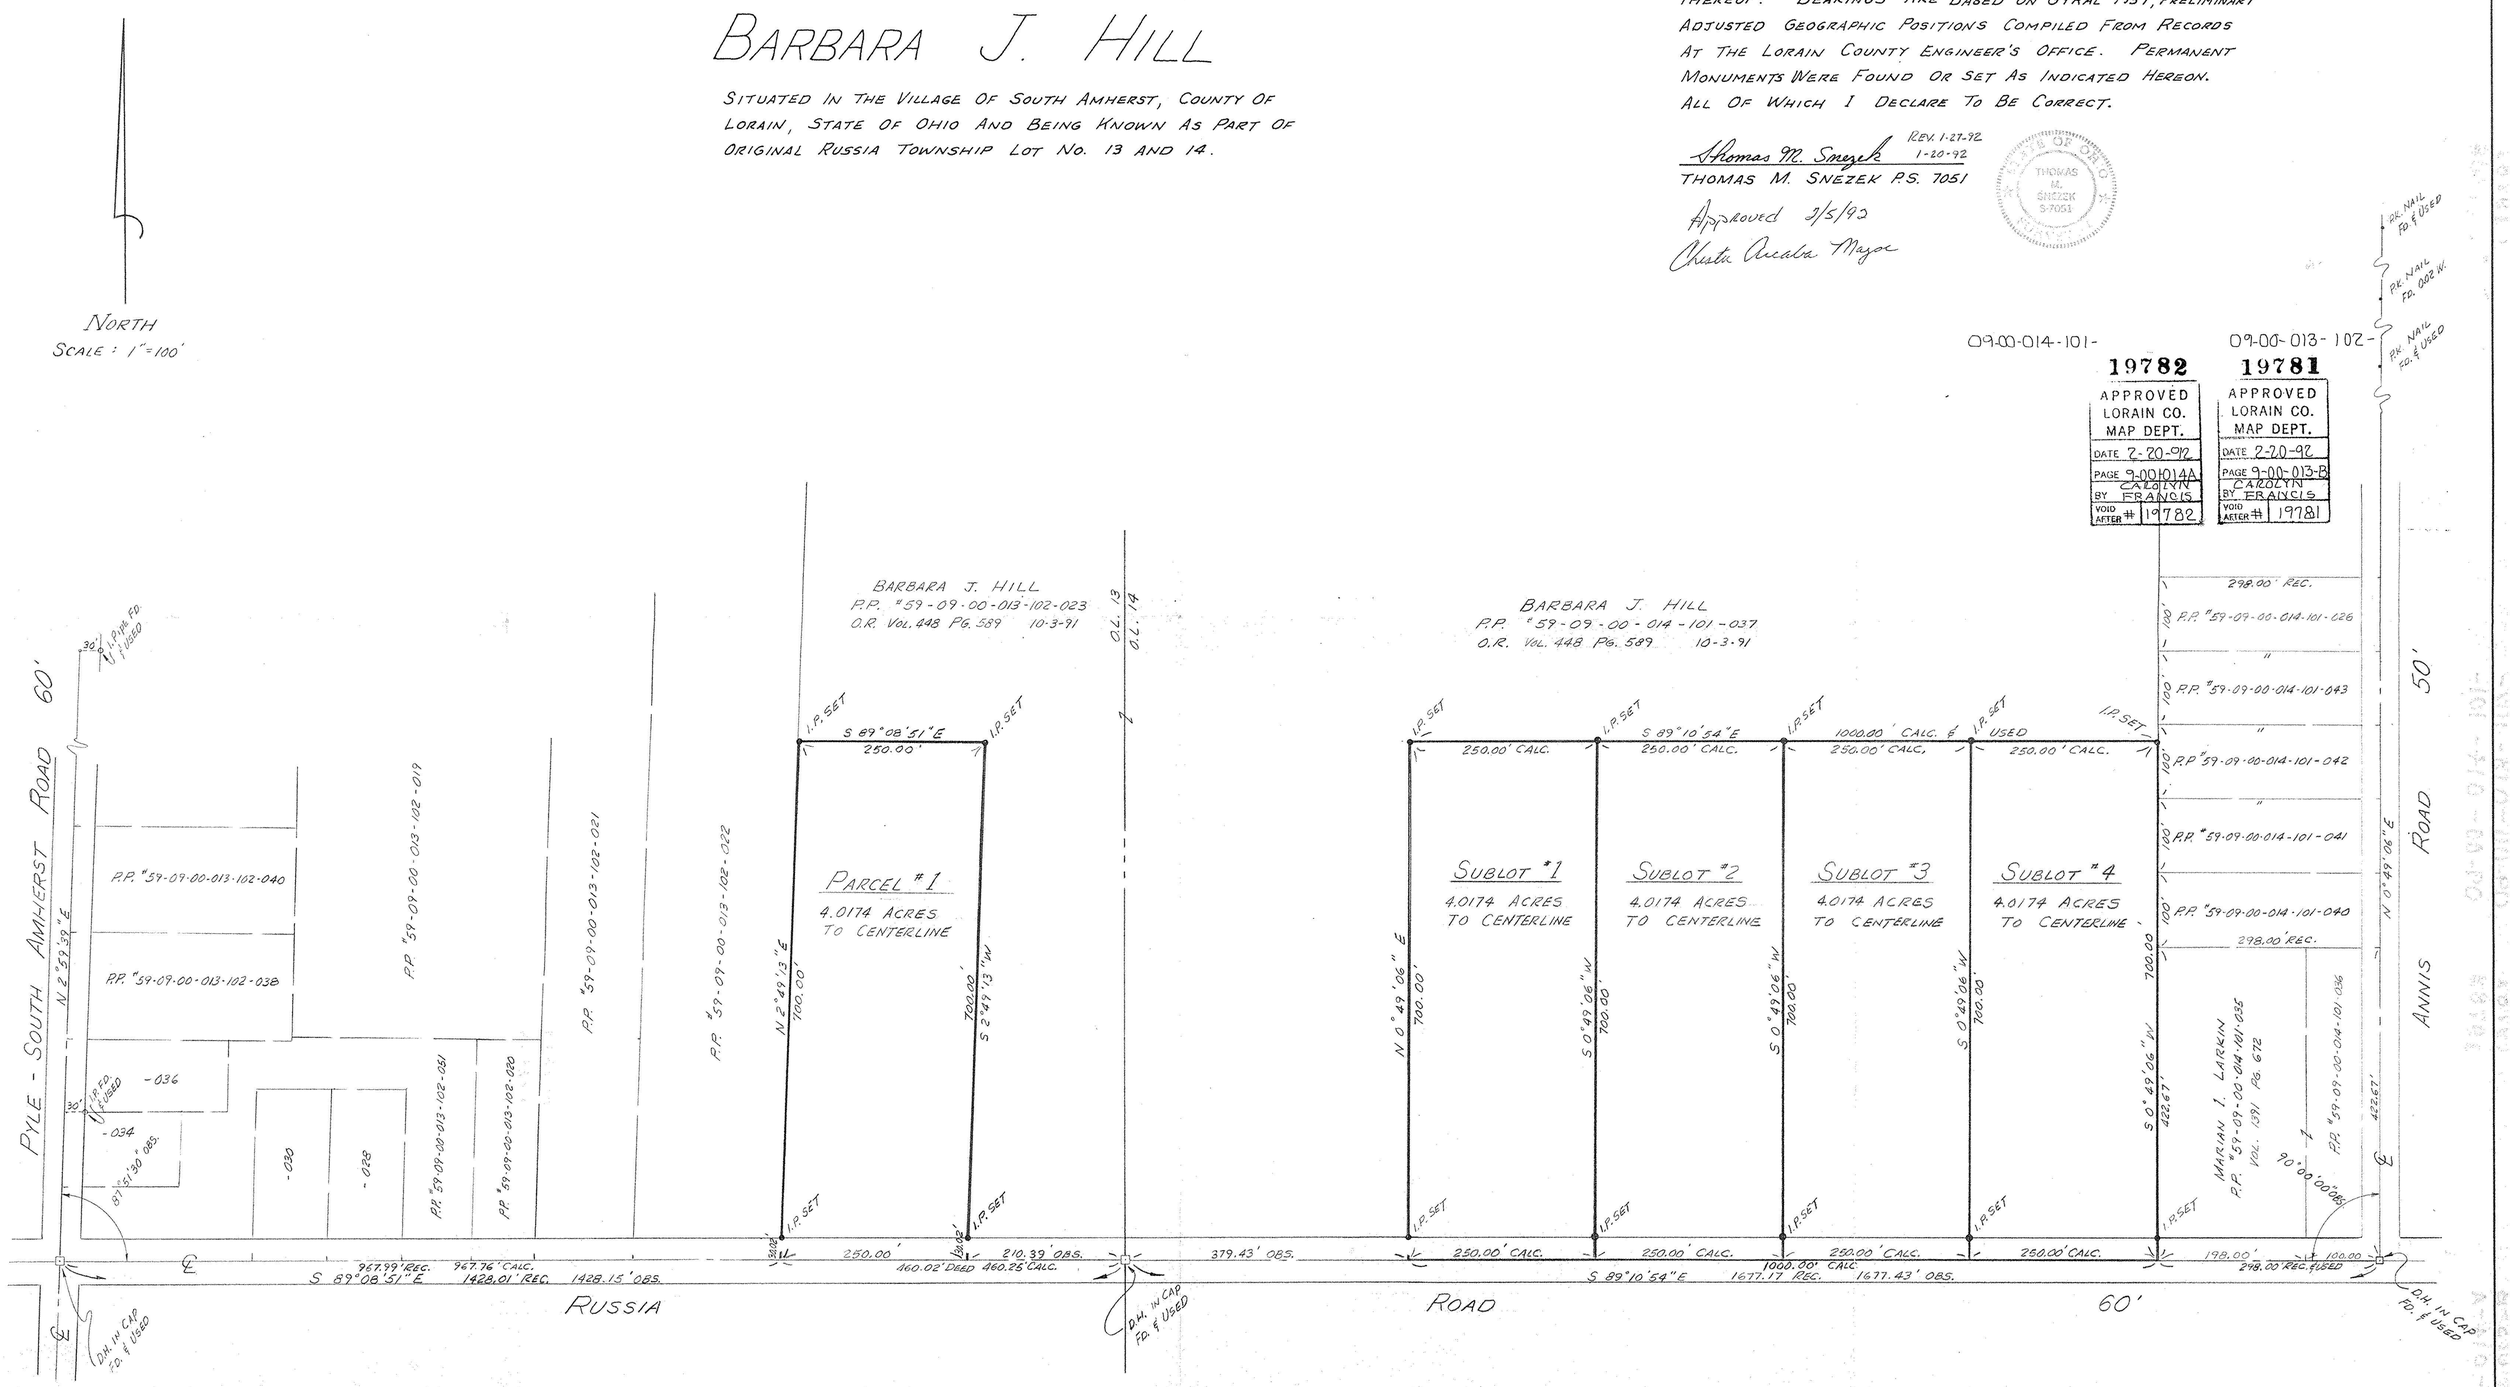
APPROVED LORAIN CO. MAP DEPT.
DATE 2-20-92
PAGE 9-00-013-B
BY CAROLYN FRANCIS
VOID AFTER # 19781