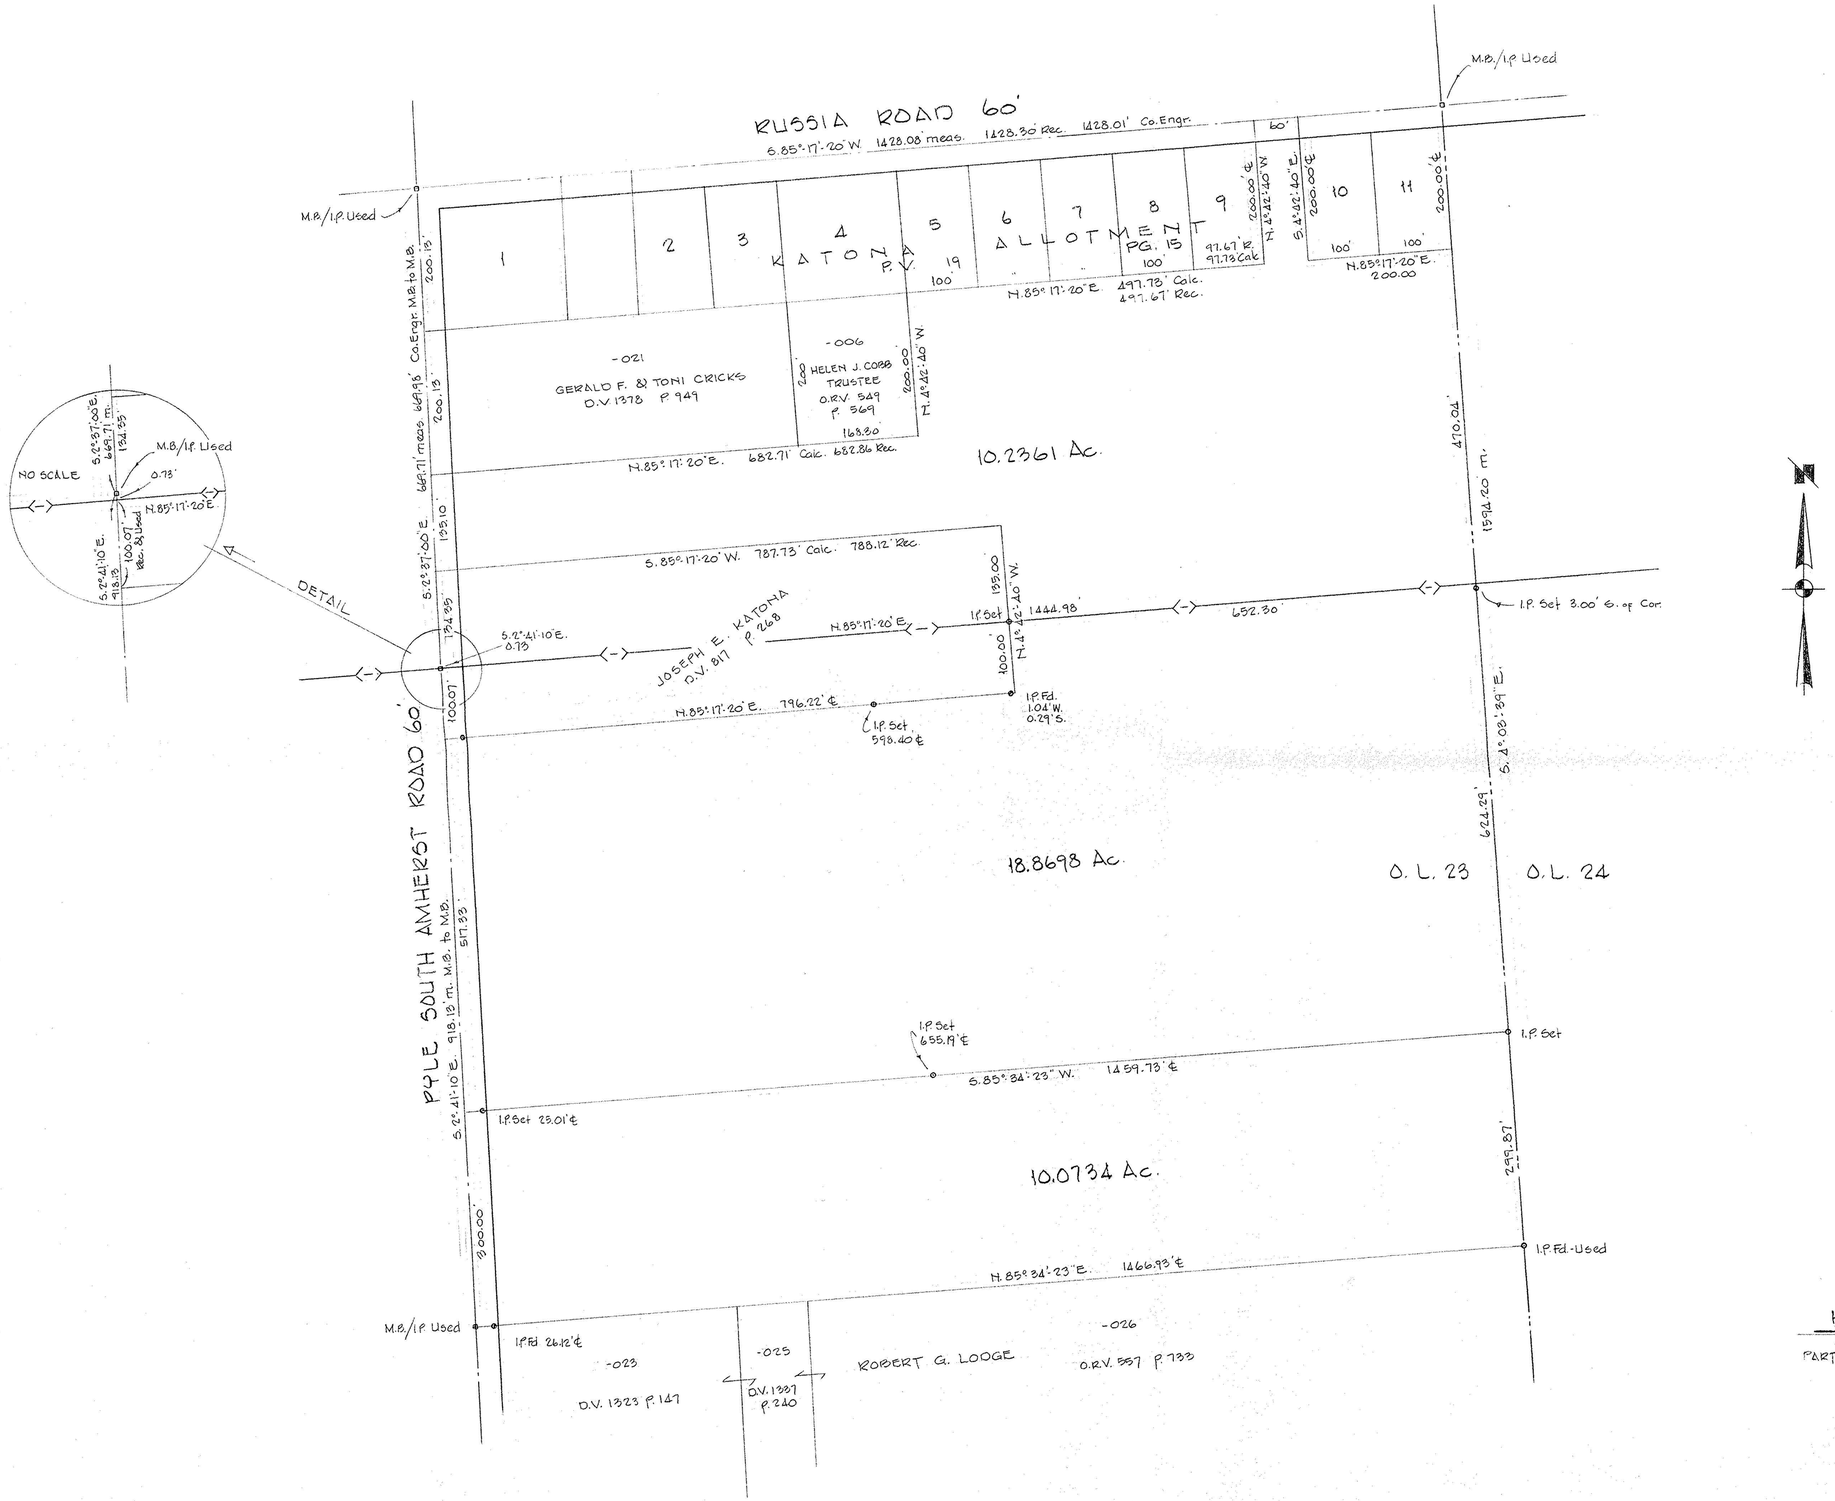

SURVEY FOR

HELEN J. COBB & JOSEPH E. KATONA

PART OF THE VILLAGE OF SOUTH AMHERST & O.L.23 OF NEW RUSSIA TWP.
COUNTY OF LORAIN STATE OF OHIO
DECEMBER, 1998 SCALE 1" = 100'
BY
LAUNDON • SIMON • CAHL & ASSOC.
PROFESSIONAL LAND SURVEYORS
JOB Nº 98-3097 F.B. 244 P. 73

362