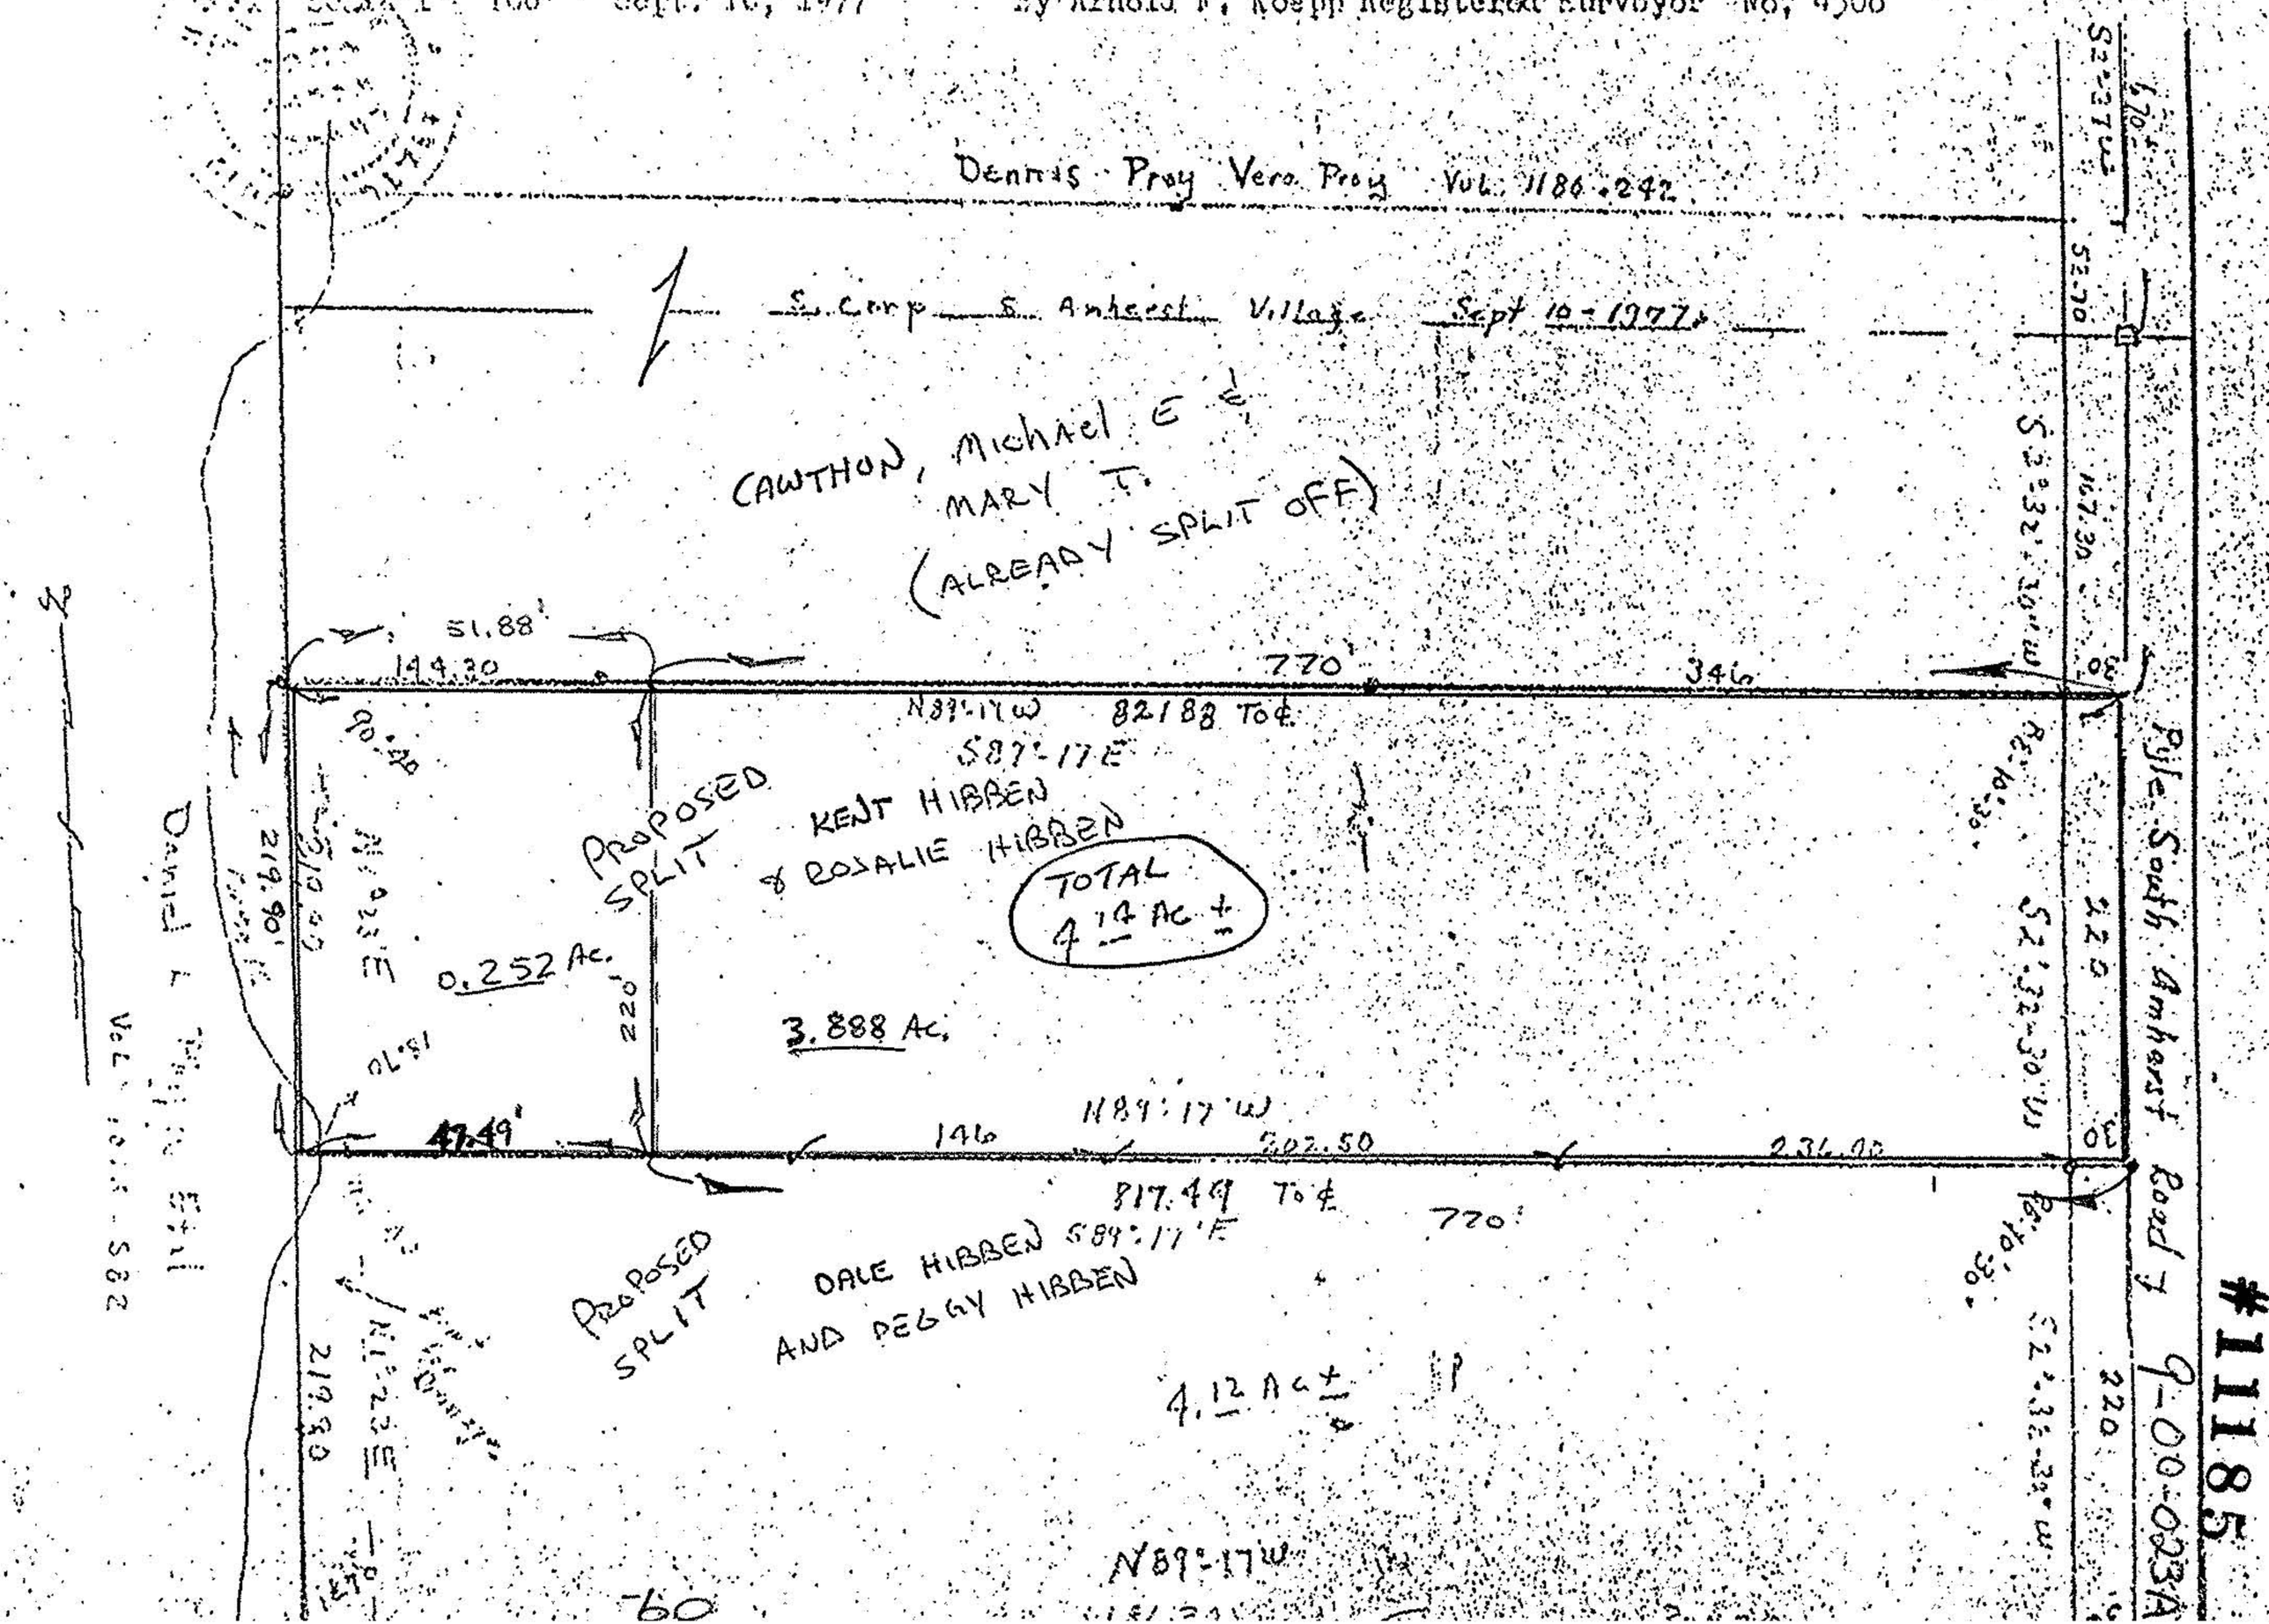Map of Survey Part of O.L. 23 Russia Twp. Lorain Co. Ohio
Scale 1" 100' Sept. 10, 1977 By Arnold F. Koepp Registered Surveyor No. 4506