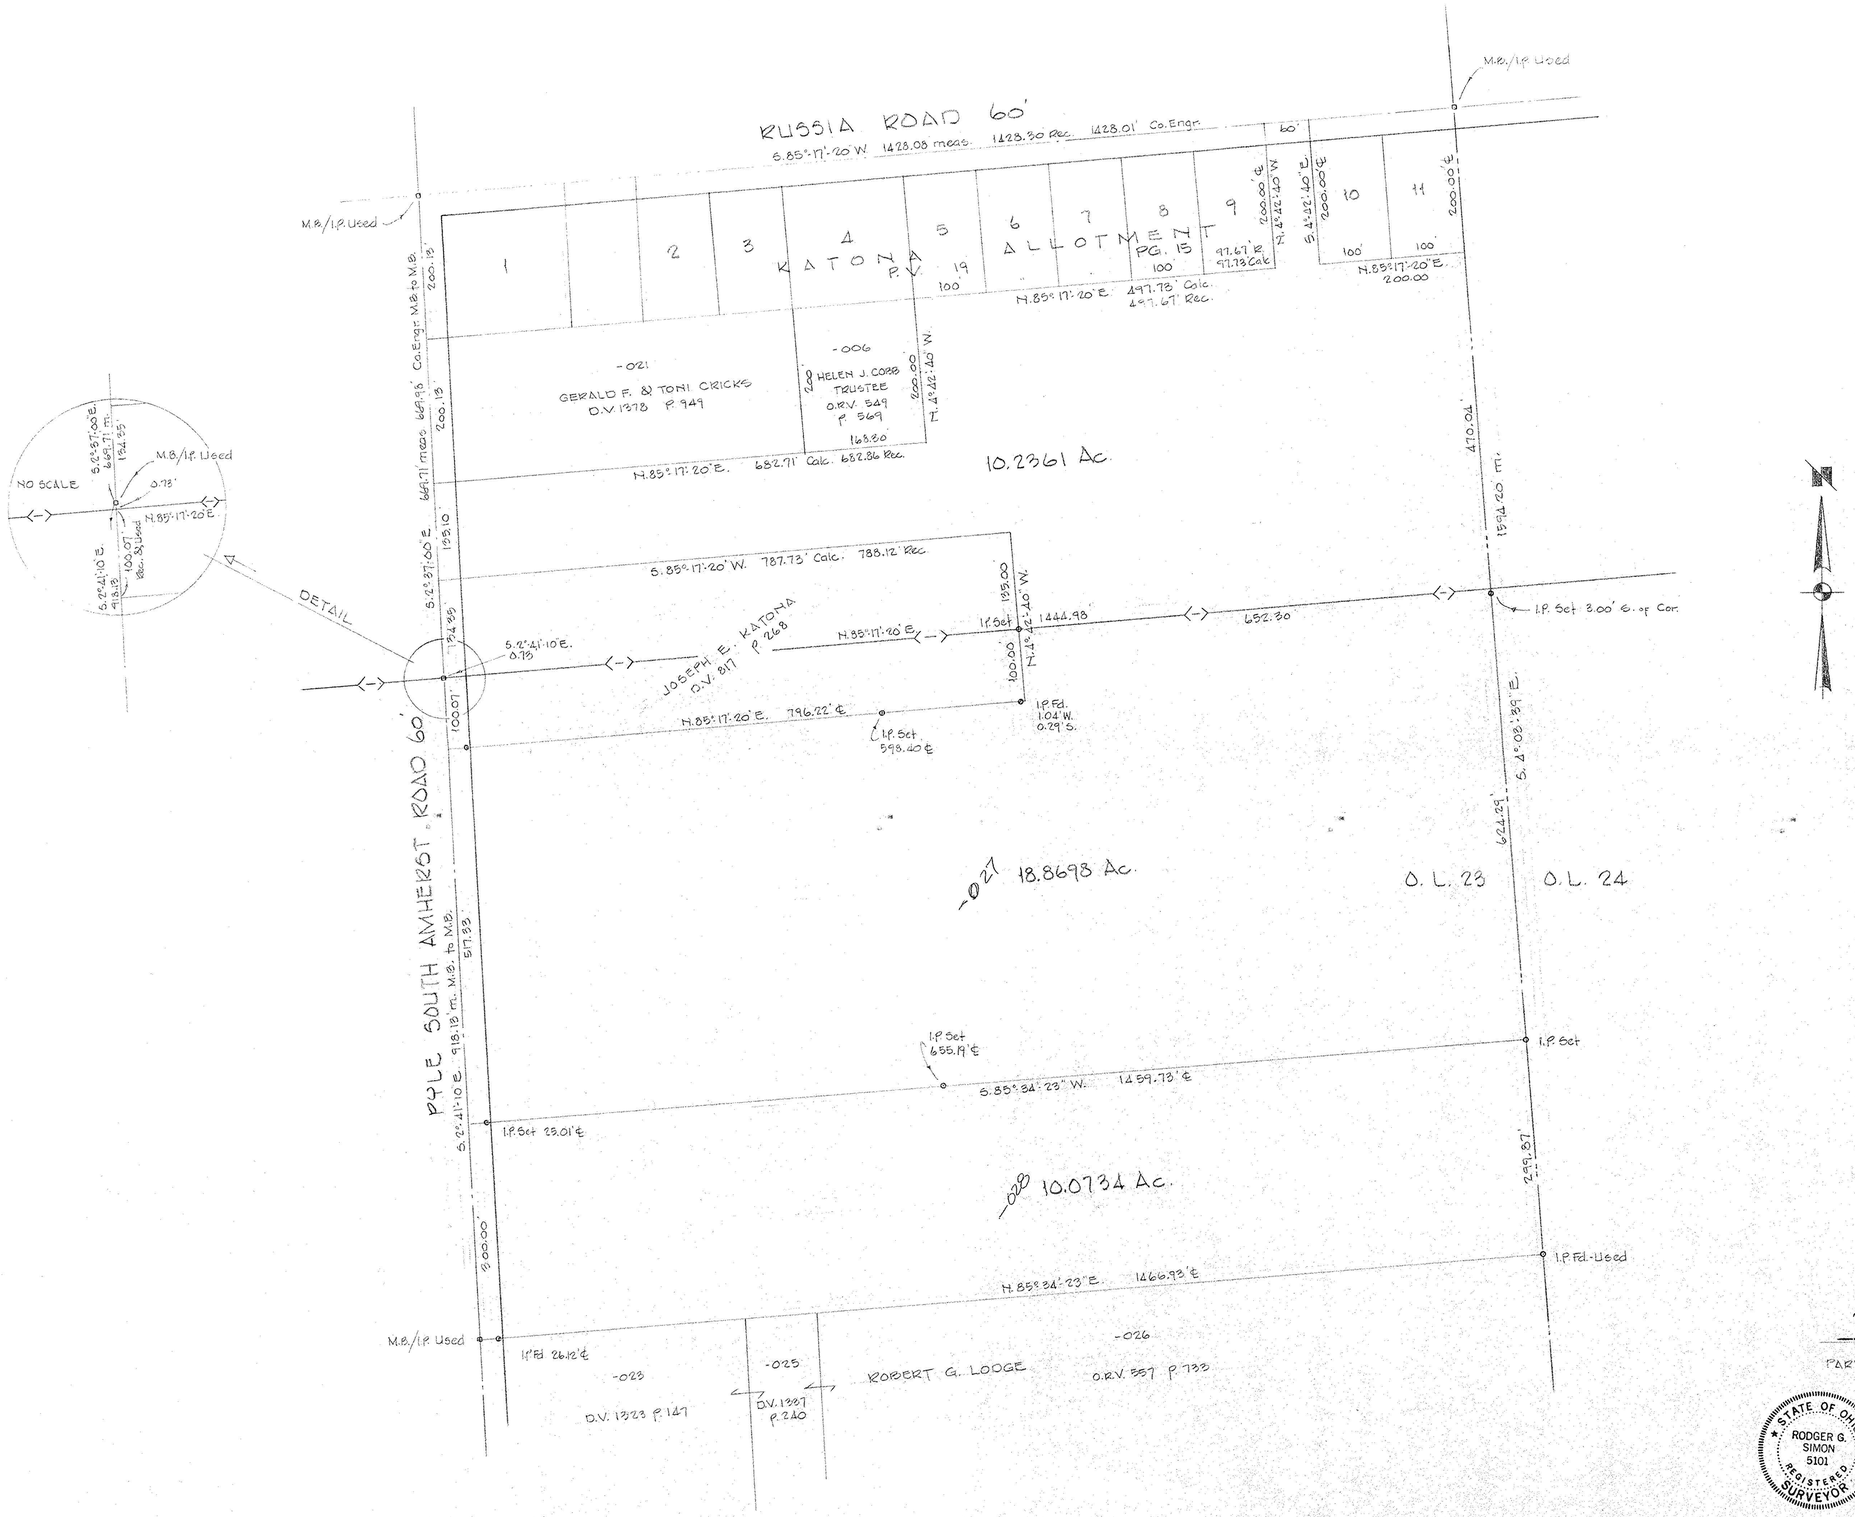

27.91
18.87
9.04

99-00072

APPROVED
LORAIN CO.
MAP DEPT
DATE 4-23-99
PAGE 9-00-023B
BY
99-00072

SURVEY FOR

HELEN J. COBB & JOSEPH E. KATONA

PART OF THE VILLAGE OF SOUTH AMHERST & O.L.23 OF NEW RUSSIA TWP.
COUNTY OF LORAIN STATE OF OHIO
DECEMBER, 1998 SCALE 1" = 100'
BY
LAUNDON · SIMON · CAHL & ASSOC.
PROFESSIONAL LAND SURVEYORS
JOB No 98-3097 F.B. 244 P. 73

STATE OF OHIO
RODGER G. SIMON
5101
REGISTERED SURVEYOR