

JESSIE BORN
08-12-005-000-014

ROBERT W. & EDITH J. RONEZ
D.V. 1277 PG. 186
08-12-004-000-013

HUBERT C. & MARGARET
BATES
O.R. 909 PG. 132
08-12-005-000-018


LARRY J. & CHERYL A.
VERHOVEC SR.
O.R. 62 PG. 586
08-12-005-000-015

PLAT OF SURVEY FOR
LOT SPLITS

MRS. VIOLA BUCHS

HENRIETTA TOWNSHIP, LORAIN
COUNTY, OHIO.

BEING A PART OF HENRIETTA TOWNSHIP,
LORAIN COUNTY, OHIO AND A PART OF
ORIGINAL TOWNSHIP LOTS 4 AND 5, TRACT
12.

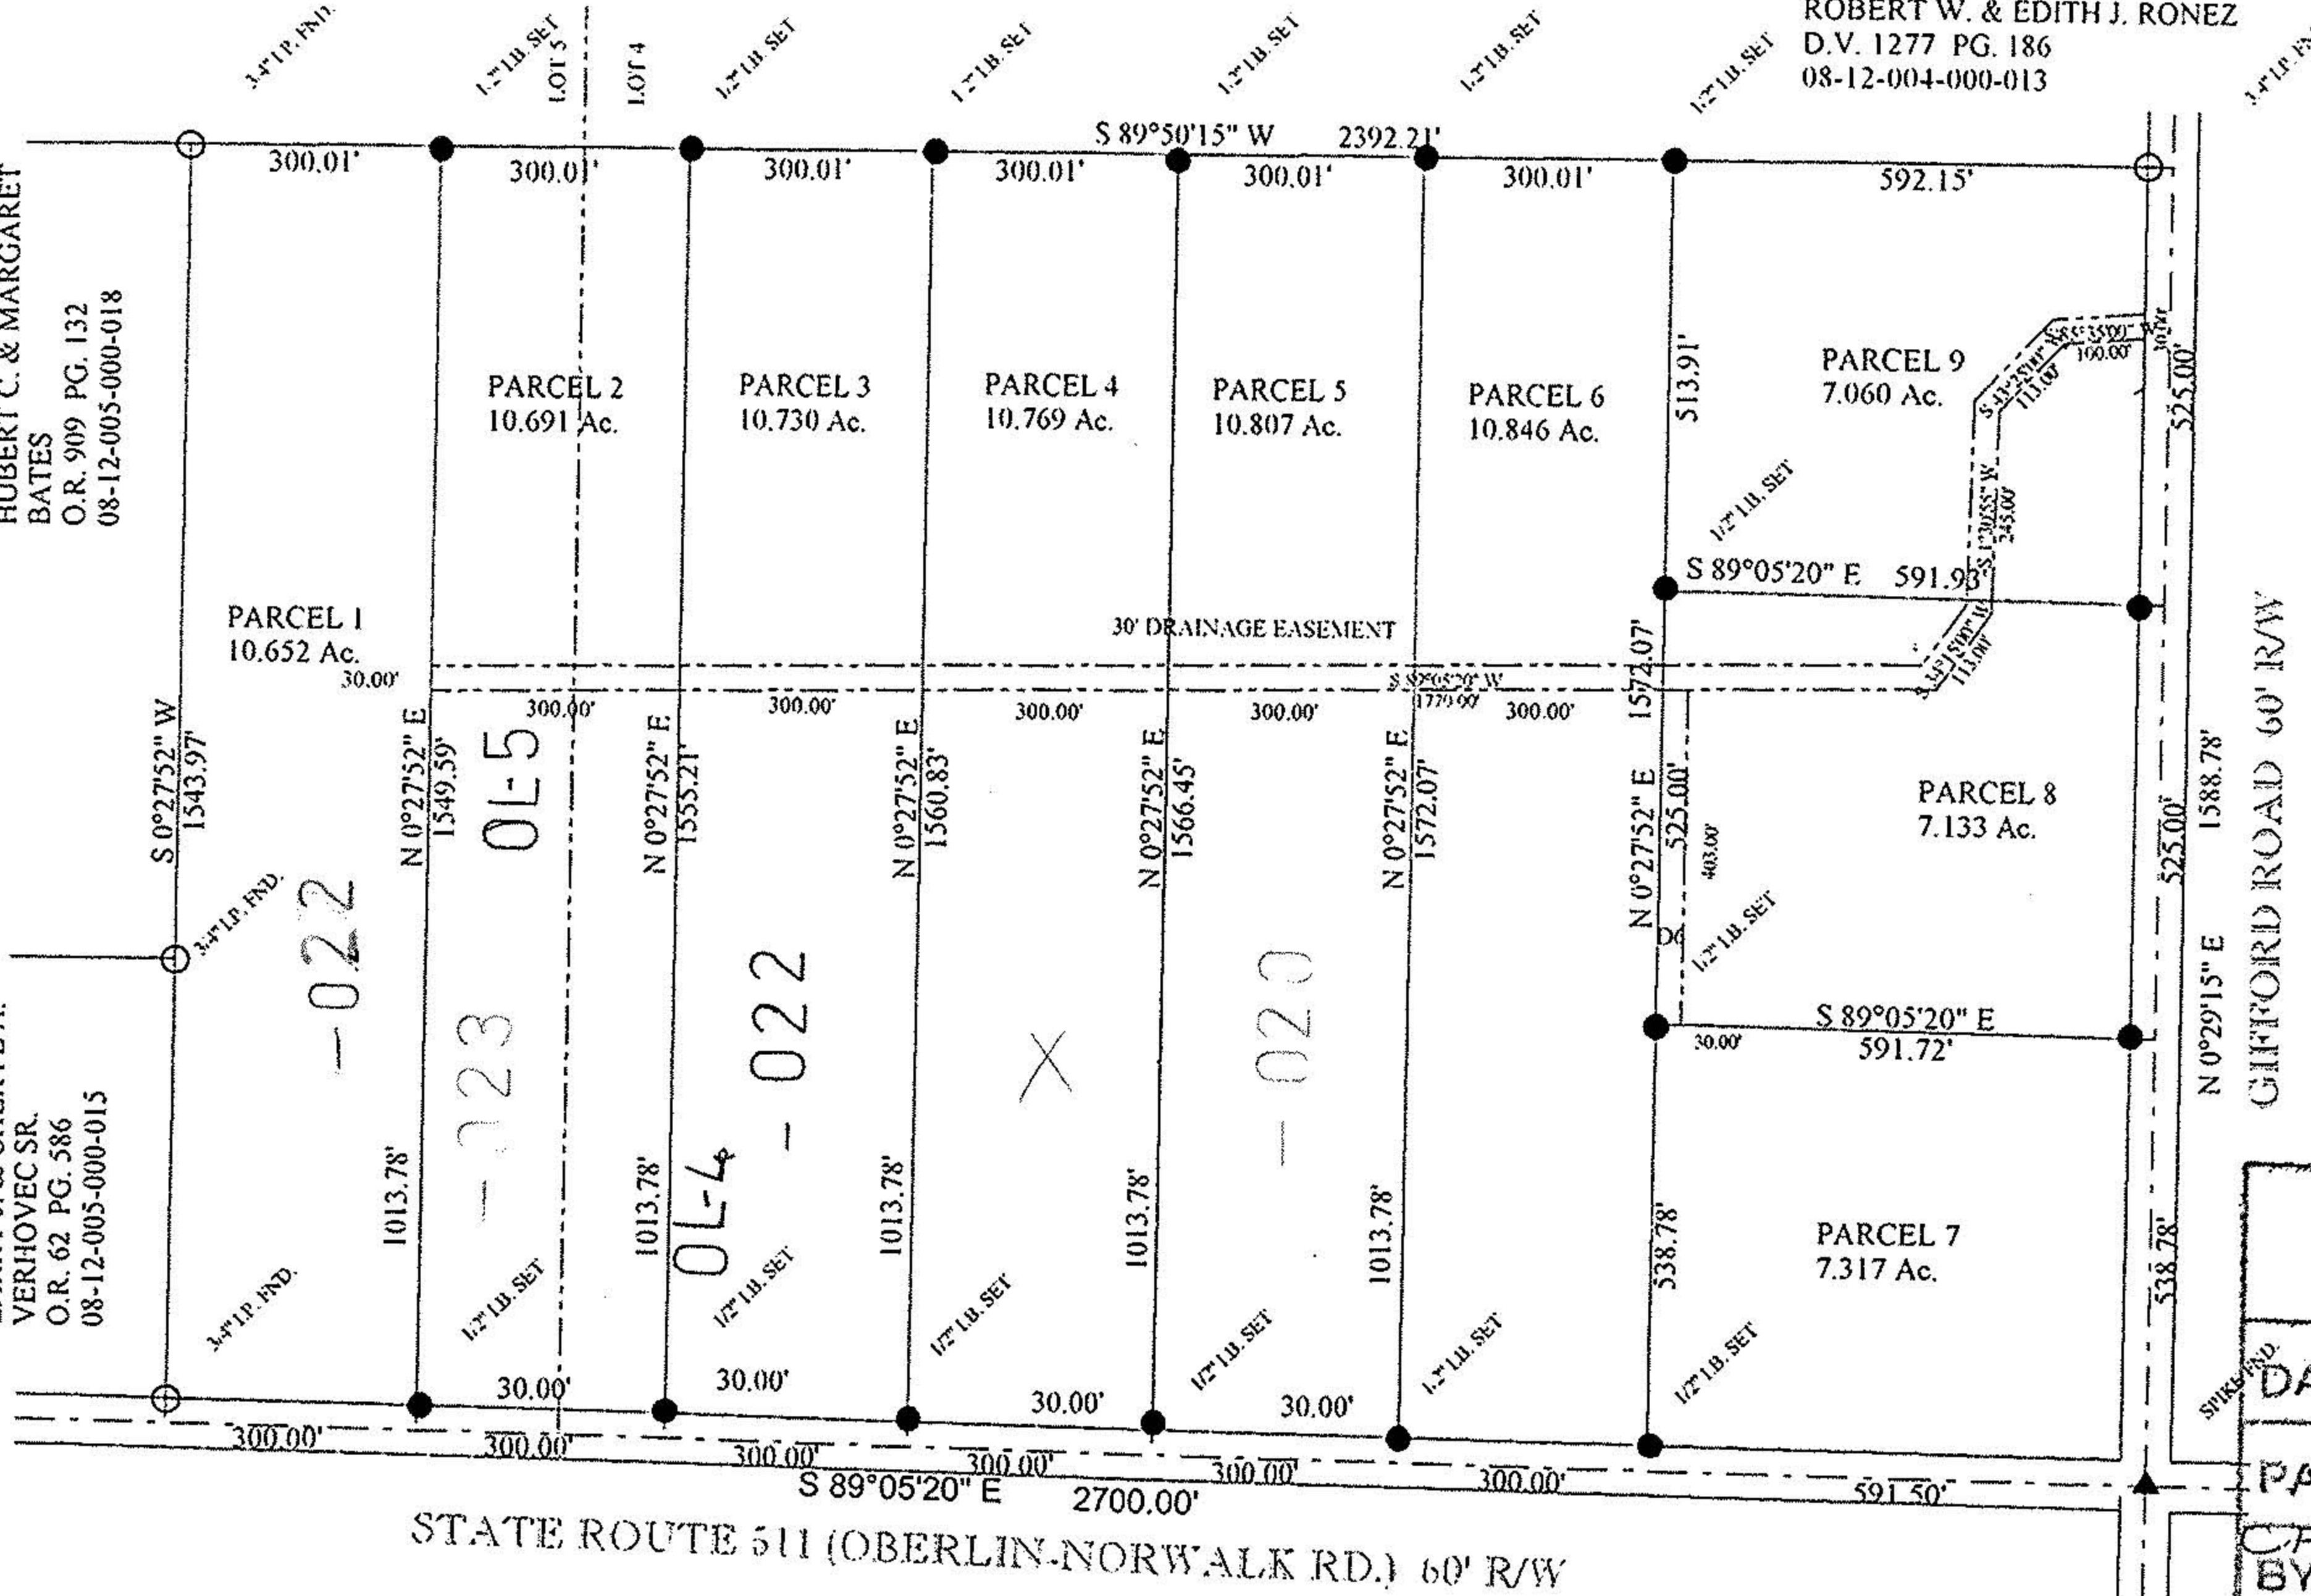

Earl H. Hunter
May 22, 1995

21455

APPROVED
LORAIN CO.
MAP DEPT

DATE 8-22-95

PAGE 8-G


Graphic Scale



CF BY

21455

MARCH 15, 1995

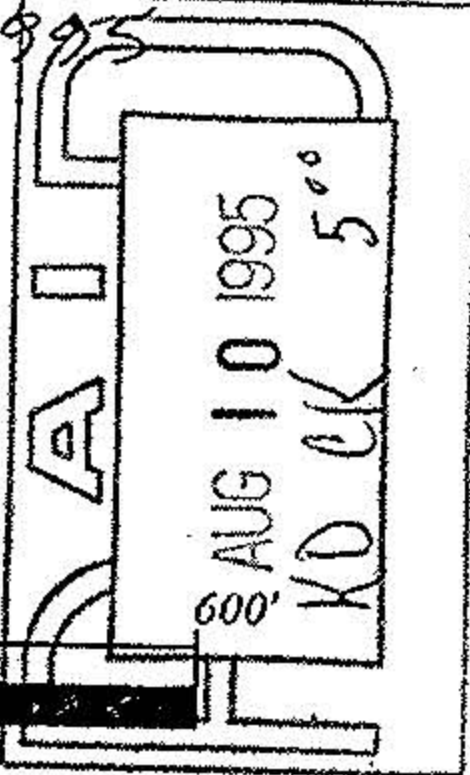

STATE ROUTE 511 (OBERLIN-NORWALK RD.) 60' R/W

PREPARED BY: EARL H. HUNTER, P.S.
1503 SANFORD STREET
VERMILION, OHIO 44089
(216) 967-2037