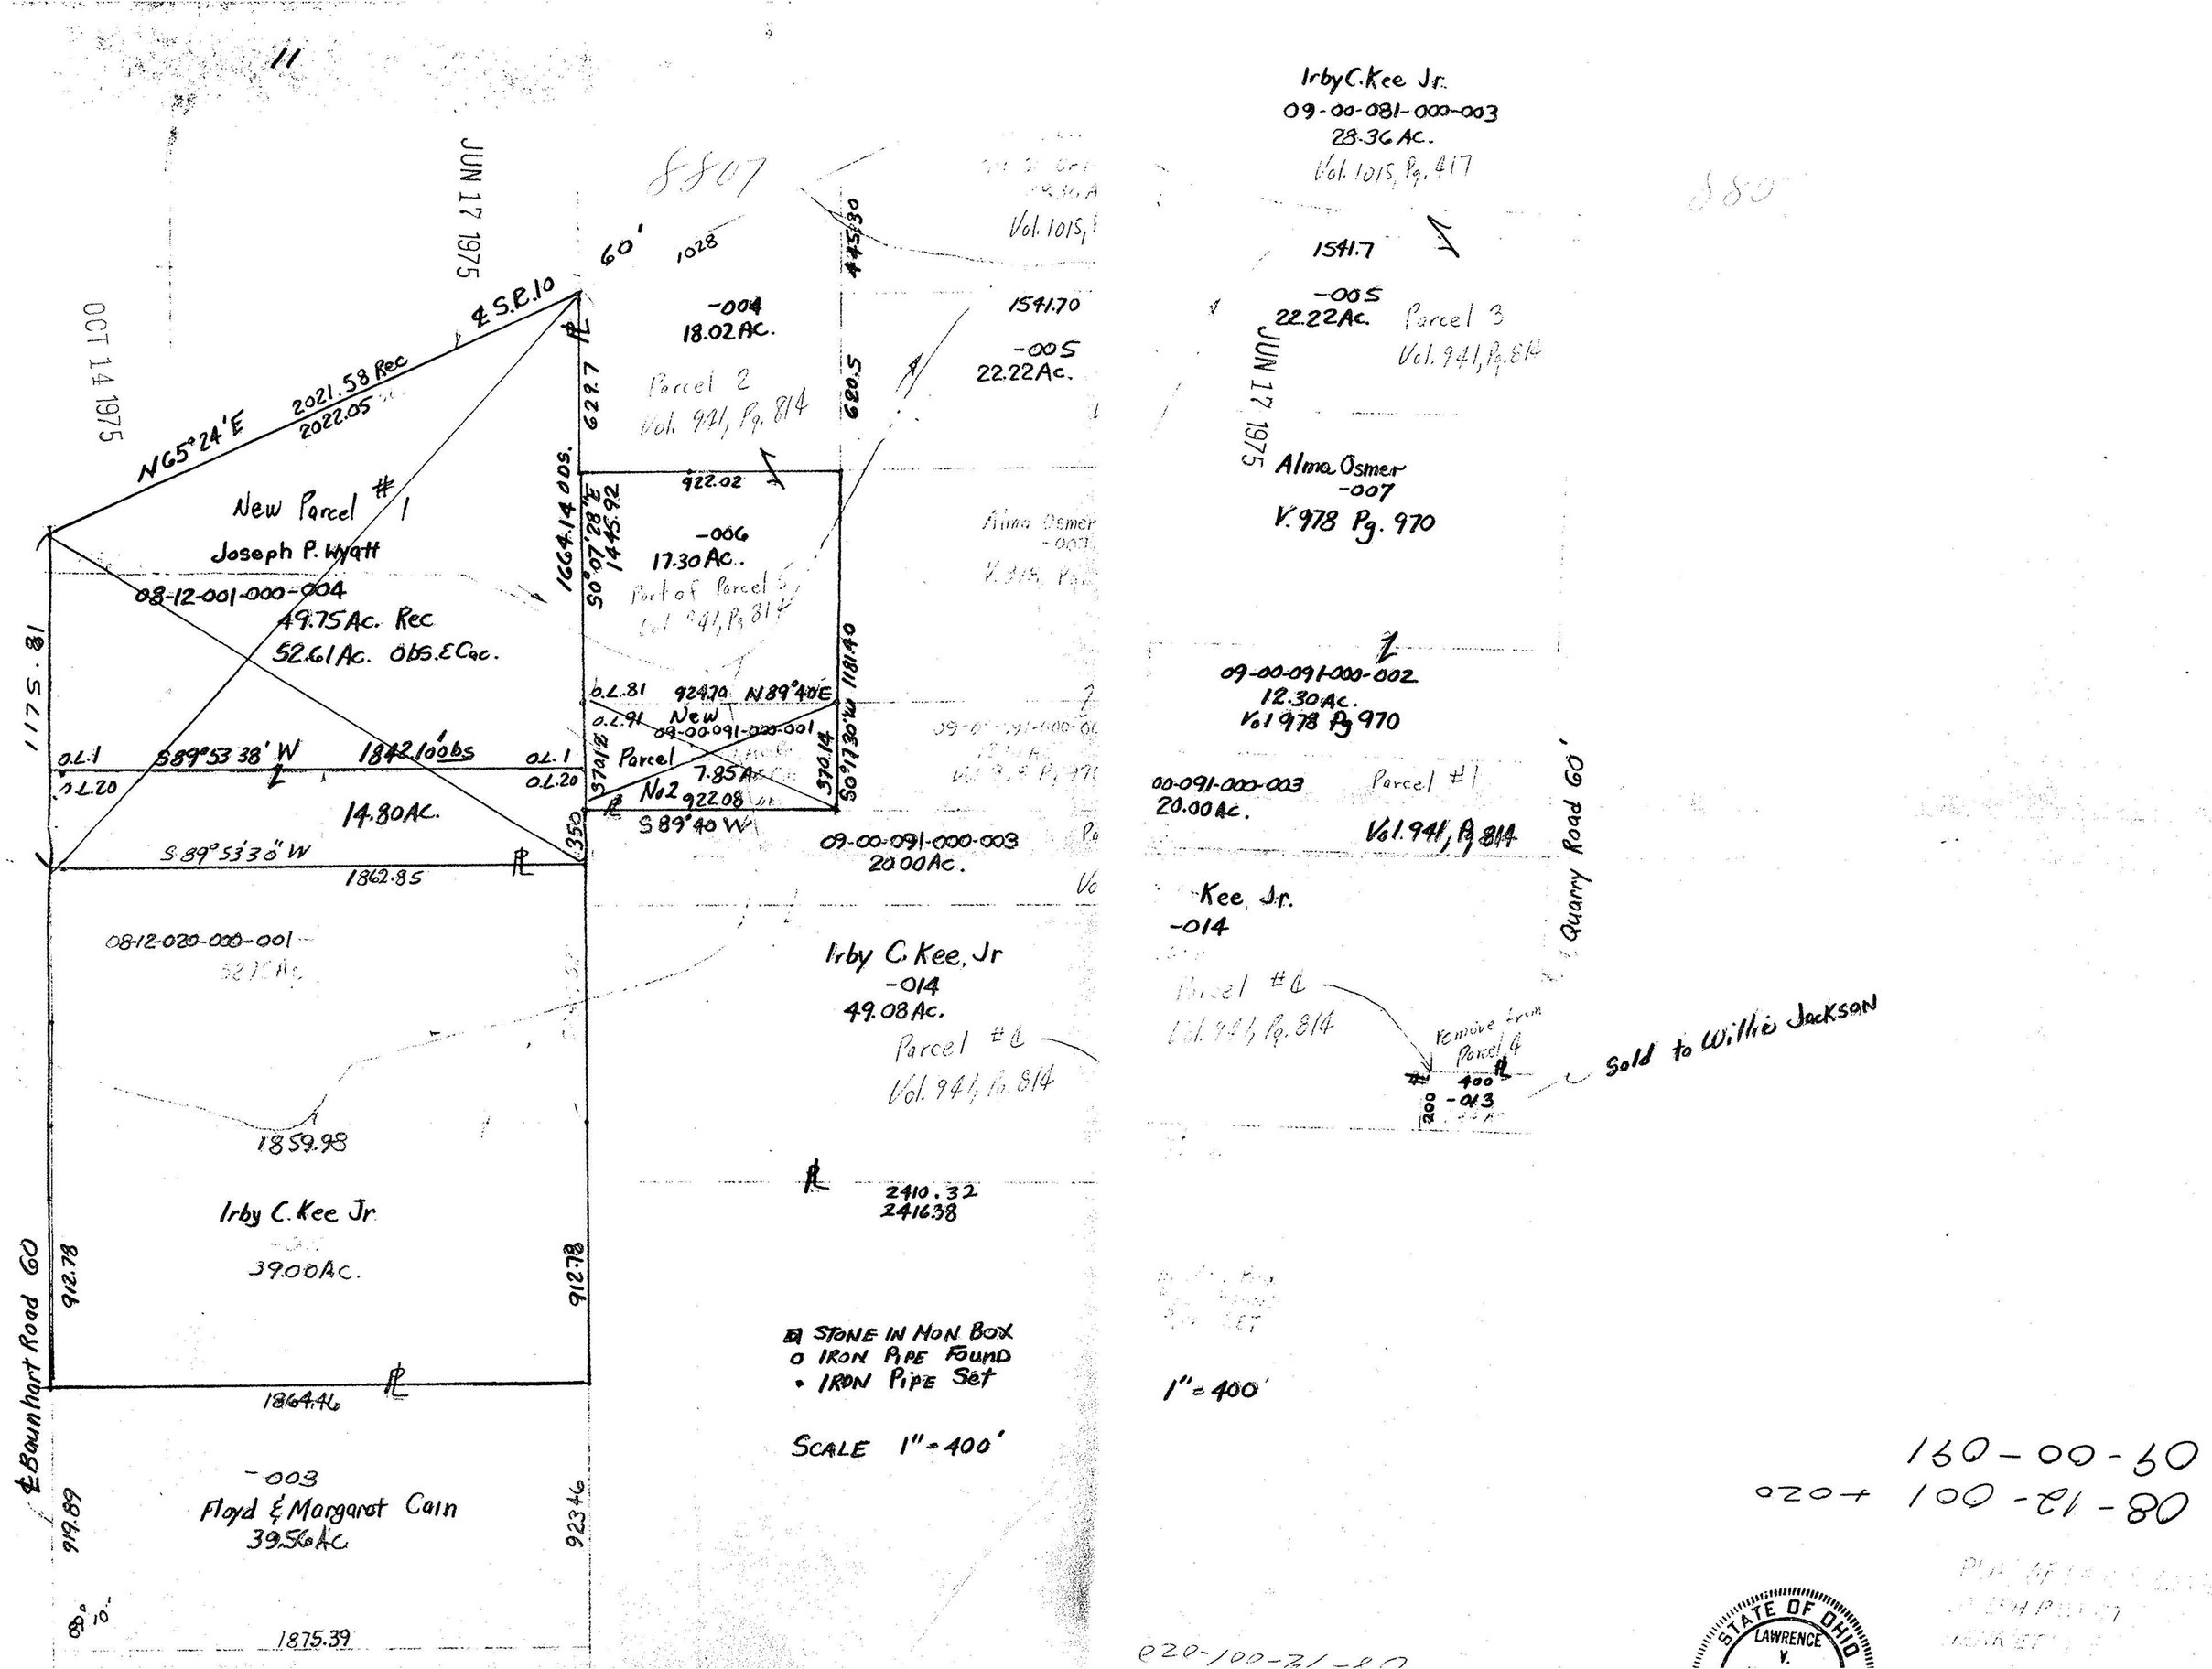

11
JUN 17 1975
OCT 14 1975
8807
60'
1028
445.30
℄ S.R.10
N65°24'E
2021.58 Rec
2022.05
New Parcel #1
Joseph P. Wyatt
08-12-001-000-004
49.75 Ac. Rec
52.61 Ac. Obs. & Cac.
1175.81
O.L.1
O.L.20
S89°53'38" W
1842.10 obs
14.80 AC.
S89°53'30" W
1862.85
08-12-020-000-001
1859.98
Irby C. Kee Jr.
39.00 Ac.
912.78
1864.46
-003
Floyd & Margaret Cain
39.56 Ac.
919.89
923.46
1875.39
℄ Baunhart Road 60
-004
18.02 AC.
Parcel 2
Vol. 941, Pg. 814
629.7
620.5
1664.14 obs.
S0°07'28"E
1445.92
922.02
-006
17.30 Ac.
Part of Parcel 5
Vol. 941, Pg. 814
O.L.81
O.L.91
924.70
N89°40'E
New
09-00-091-000-001
Parcel
No 2
7.85 Ac.
922.08
S89°40'W
370.14
S0°17'30"W
1181.40
350
09-00-091-000-003
20.00 Ac.
Irby C. Kee, Jr
-014
49.08 Ac.
Parcel #1
Vol. 941, Pg. 814
2410.32
2416.38
STONE IN MON BOX
IRON PIPE FOUND
IRON PIPE SET
SCALE 1" = 400'
Irby C. Kee Jr.
09-00-081-000-003
28.36 AC.
Vol. 1015, Pg. 417
1541.7
-005
22.22 Ac.
Parcel 3
Vol. 941, Pg. 814
Alma Osmer
-007
V. 978 Pg. 970
09-00-091-000-002
12.30 Ac.
Vol 978 Pg 970
00-091-000-003
20.00 Ac.
Parcel #1
Vol. 941, Pg. 814
Kee, Jr.
-014
Parcel #1
Vol. 941, Pg. 814
Remove from Parcel 4
400
-013
200
Sold to Willie Jackson
Quarry Road 60'
1" = 400'
160-00-60
08-12-001
STATE OF OHIO
LAWRENCE
V.