08-00-103-000-036

LAUNDON . SIMON . CAHL & ASSOC. INC.
CONSULTING ENGINEERS & SURVEYORS
ELYRIA, OHIO 44035

SURVEY FOR:
KENT C. & DEBRA K. CRIGGER

Orig. Lot 103	City of	Date AUG. '89 Scale 1"=200
Orig. Sec	Village of	Dwn. by R.G.S. Chkd. by C.J.
Tract	County of LORAIN	Job No. 89-1833 F.B. .
Township of HENRIETTA	State of OHIO	Printed OCT 9

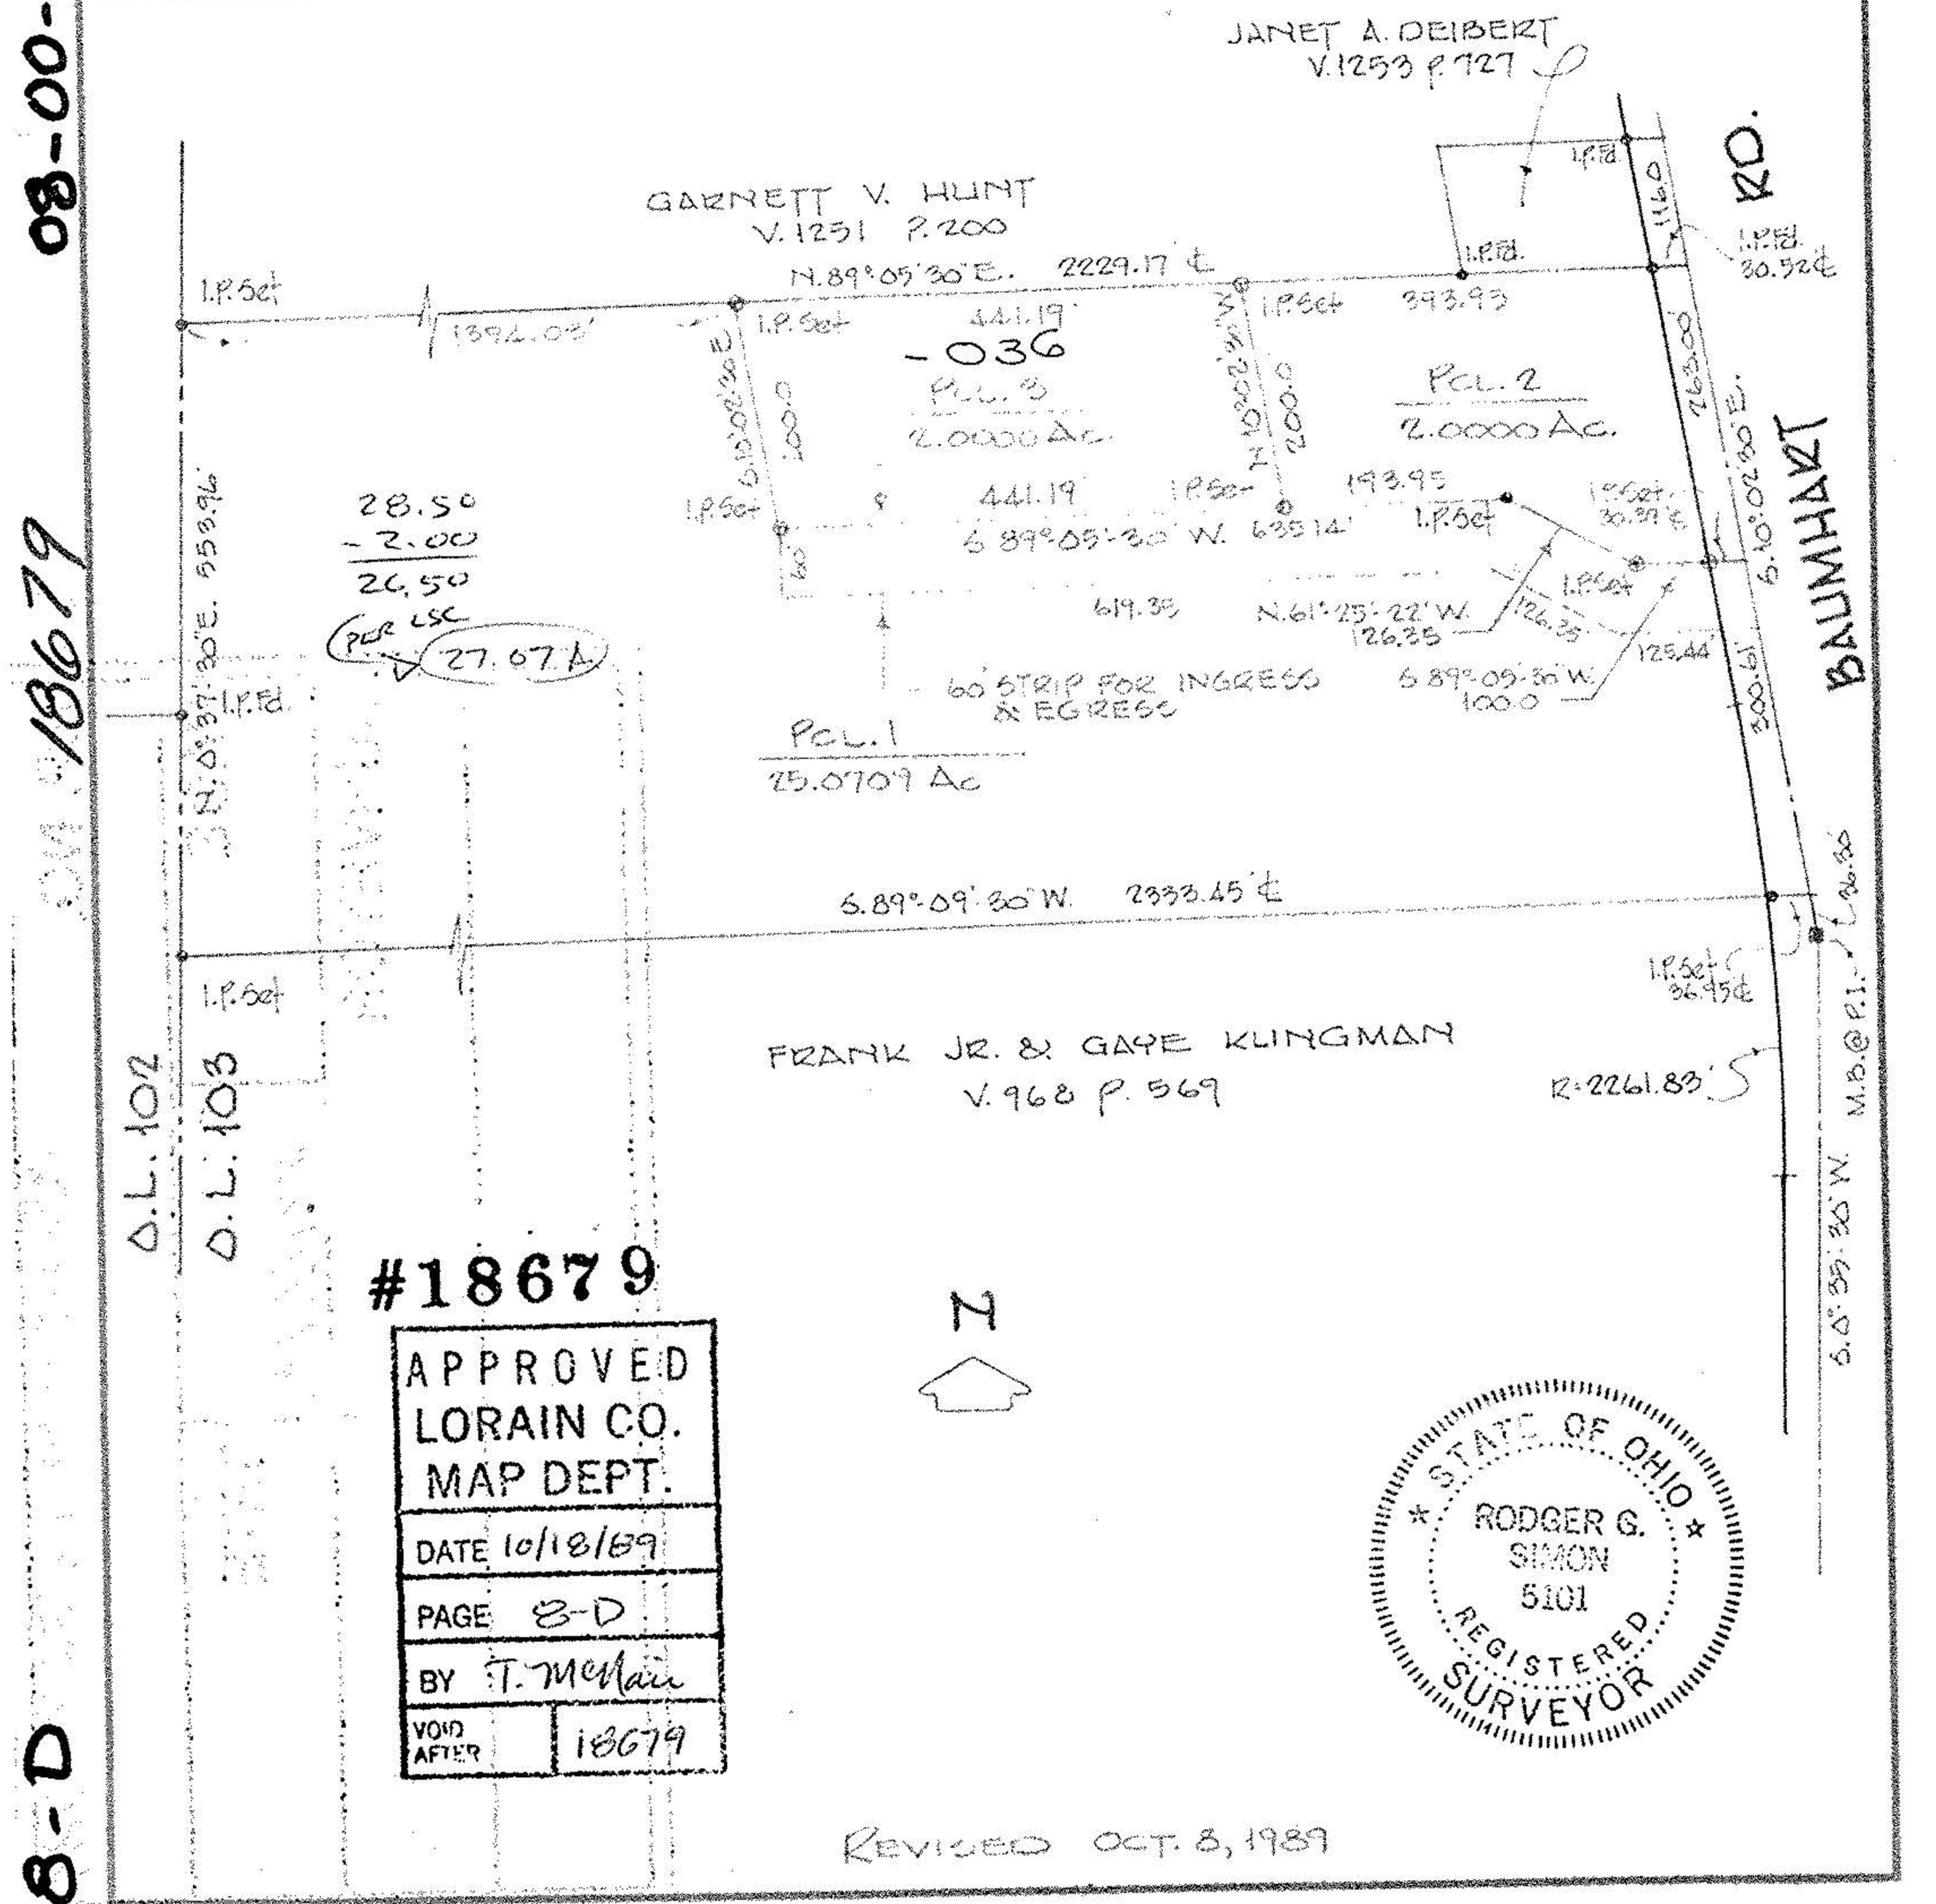

#18679

APPROVED LORAIN CO. MAP DEPT.	
DATE 10/18/89	
PAGE 8-D	
BY T. McMain	
VOID AFTER	18679

STATE OF OHIO
RODGER G. SIMON 5101
REGISTERED SURVEYOR

REVISED OCT. 8, 1989

8-D