PARCEL: 08-00-103-000-002, 039
PARCEL: 08-00-103-000-040, 041, 042
TIE POINT: cL of Baumhart Rd. & cL of Russia Rd.

~~#22285~~
NO. 22285

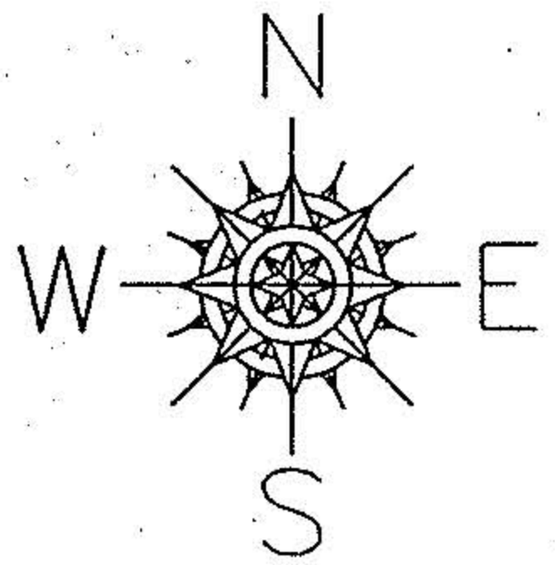

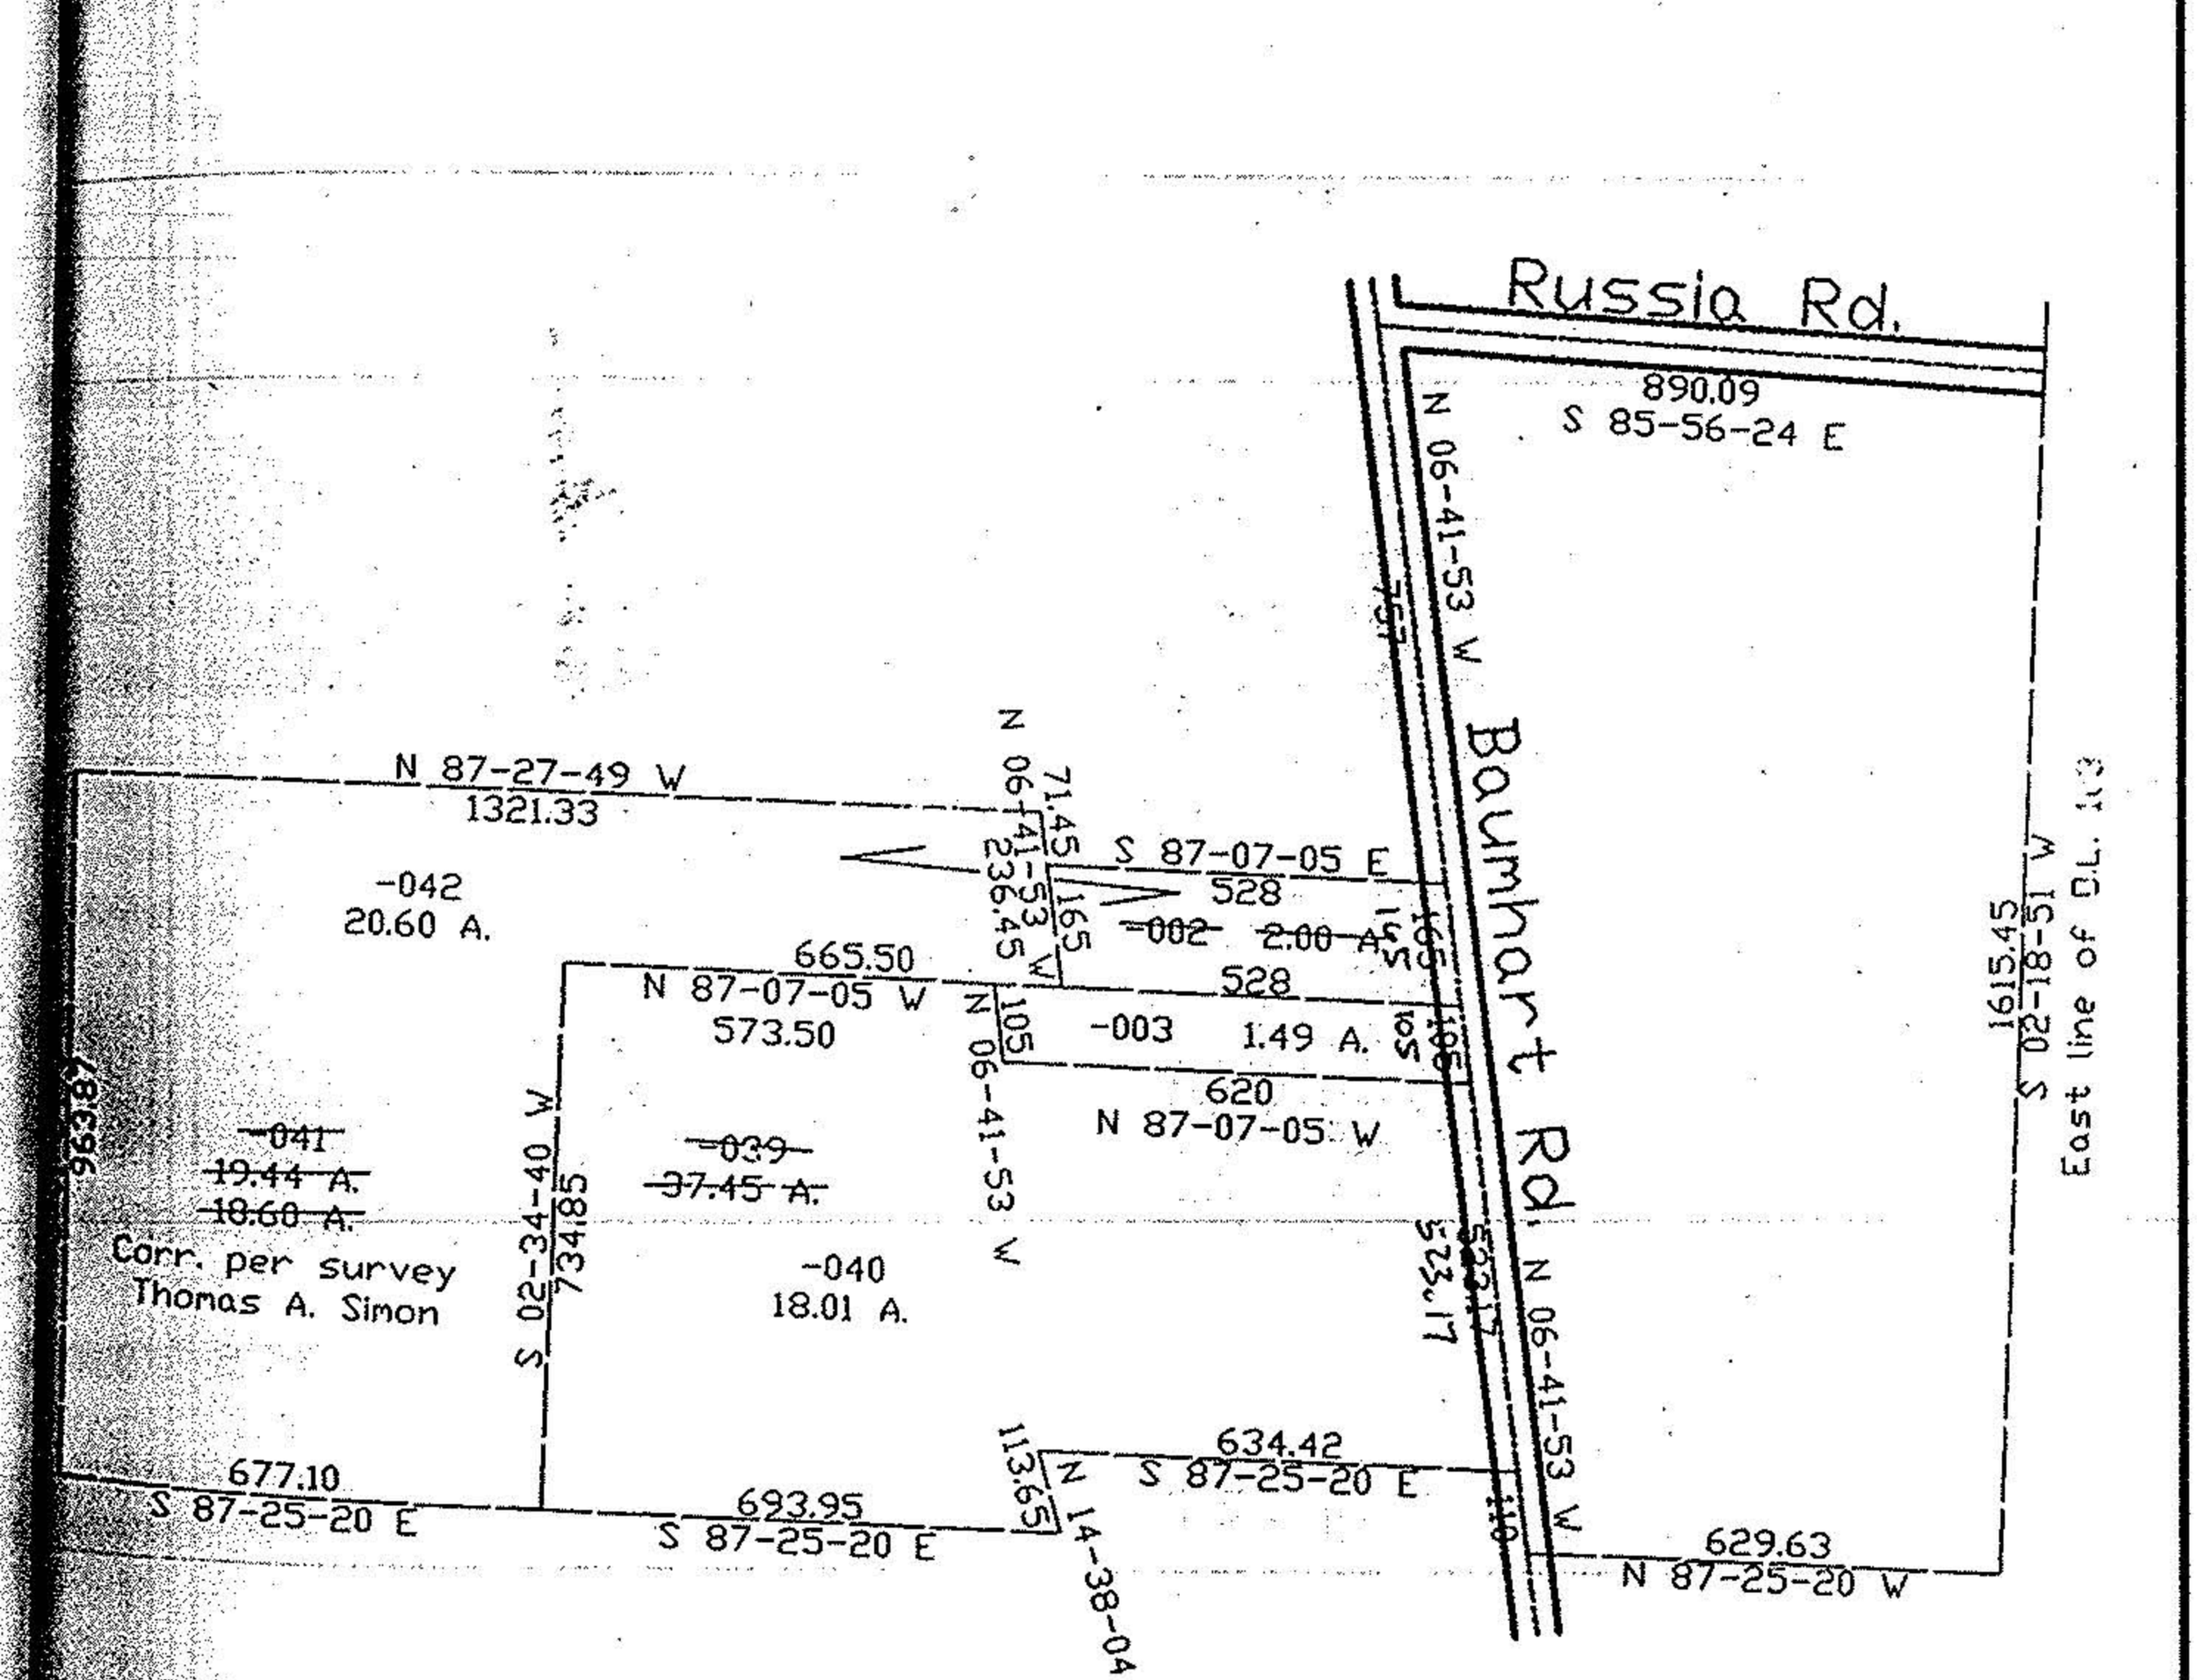

SPLITS/DEEDS PROCESSED
LORAIN COUNTY TAX MAP DEPARTMENT
226 MIDDLE AVE. ELYRIA, OHIO

SURVEYED BY: Thomas A. Simon
CLOSURE: 0.01 per 10,000
MAP PAGE(S): 8-0
APPROVED BY: kac DATE: 9/18/97
SCALE: 1"= 400 PRIOR INSTRUMENT: OR 699/707