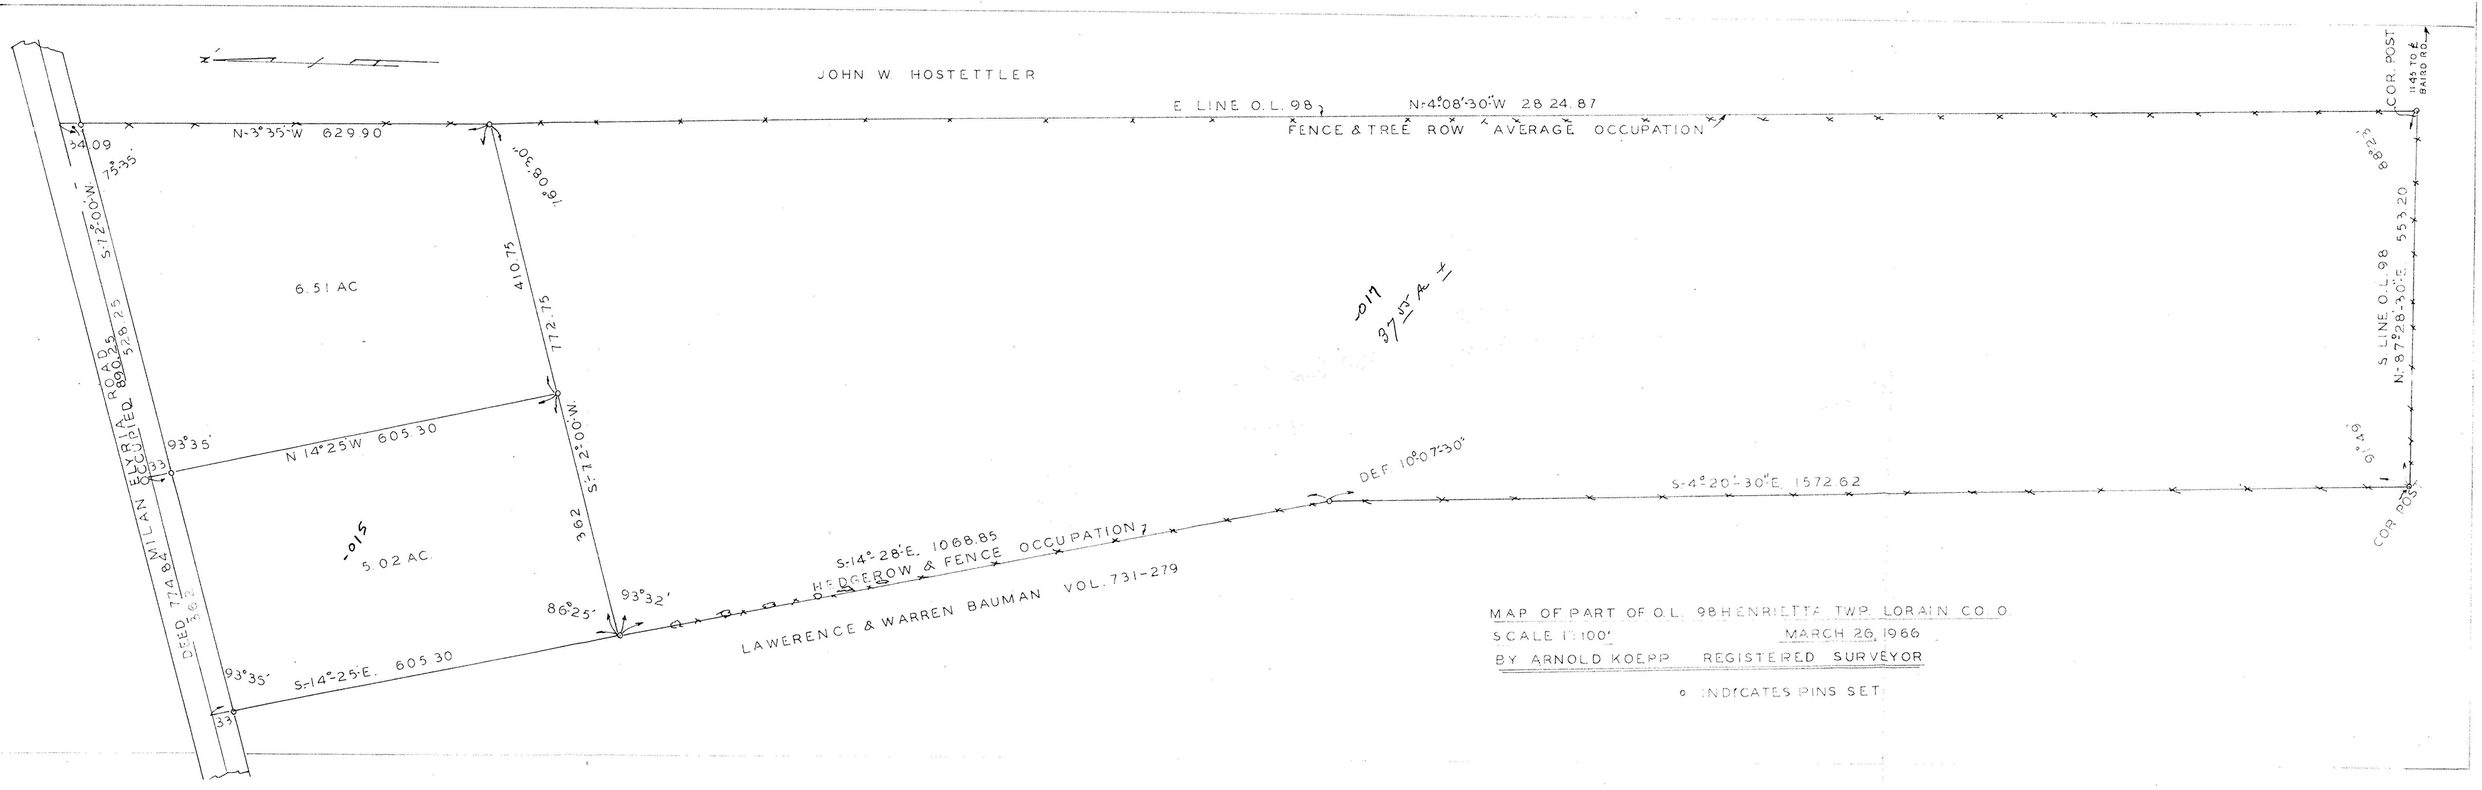

MAP OF PART OF O.L. 98 HENRIETTA TWP. LORAIN CO. O

SCALE 1"=100' MARCH 26, 1966

BY ARNOLD KOEPP REGISTERED SURVEYOR

o INDICATES PINS SET