
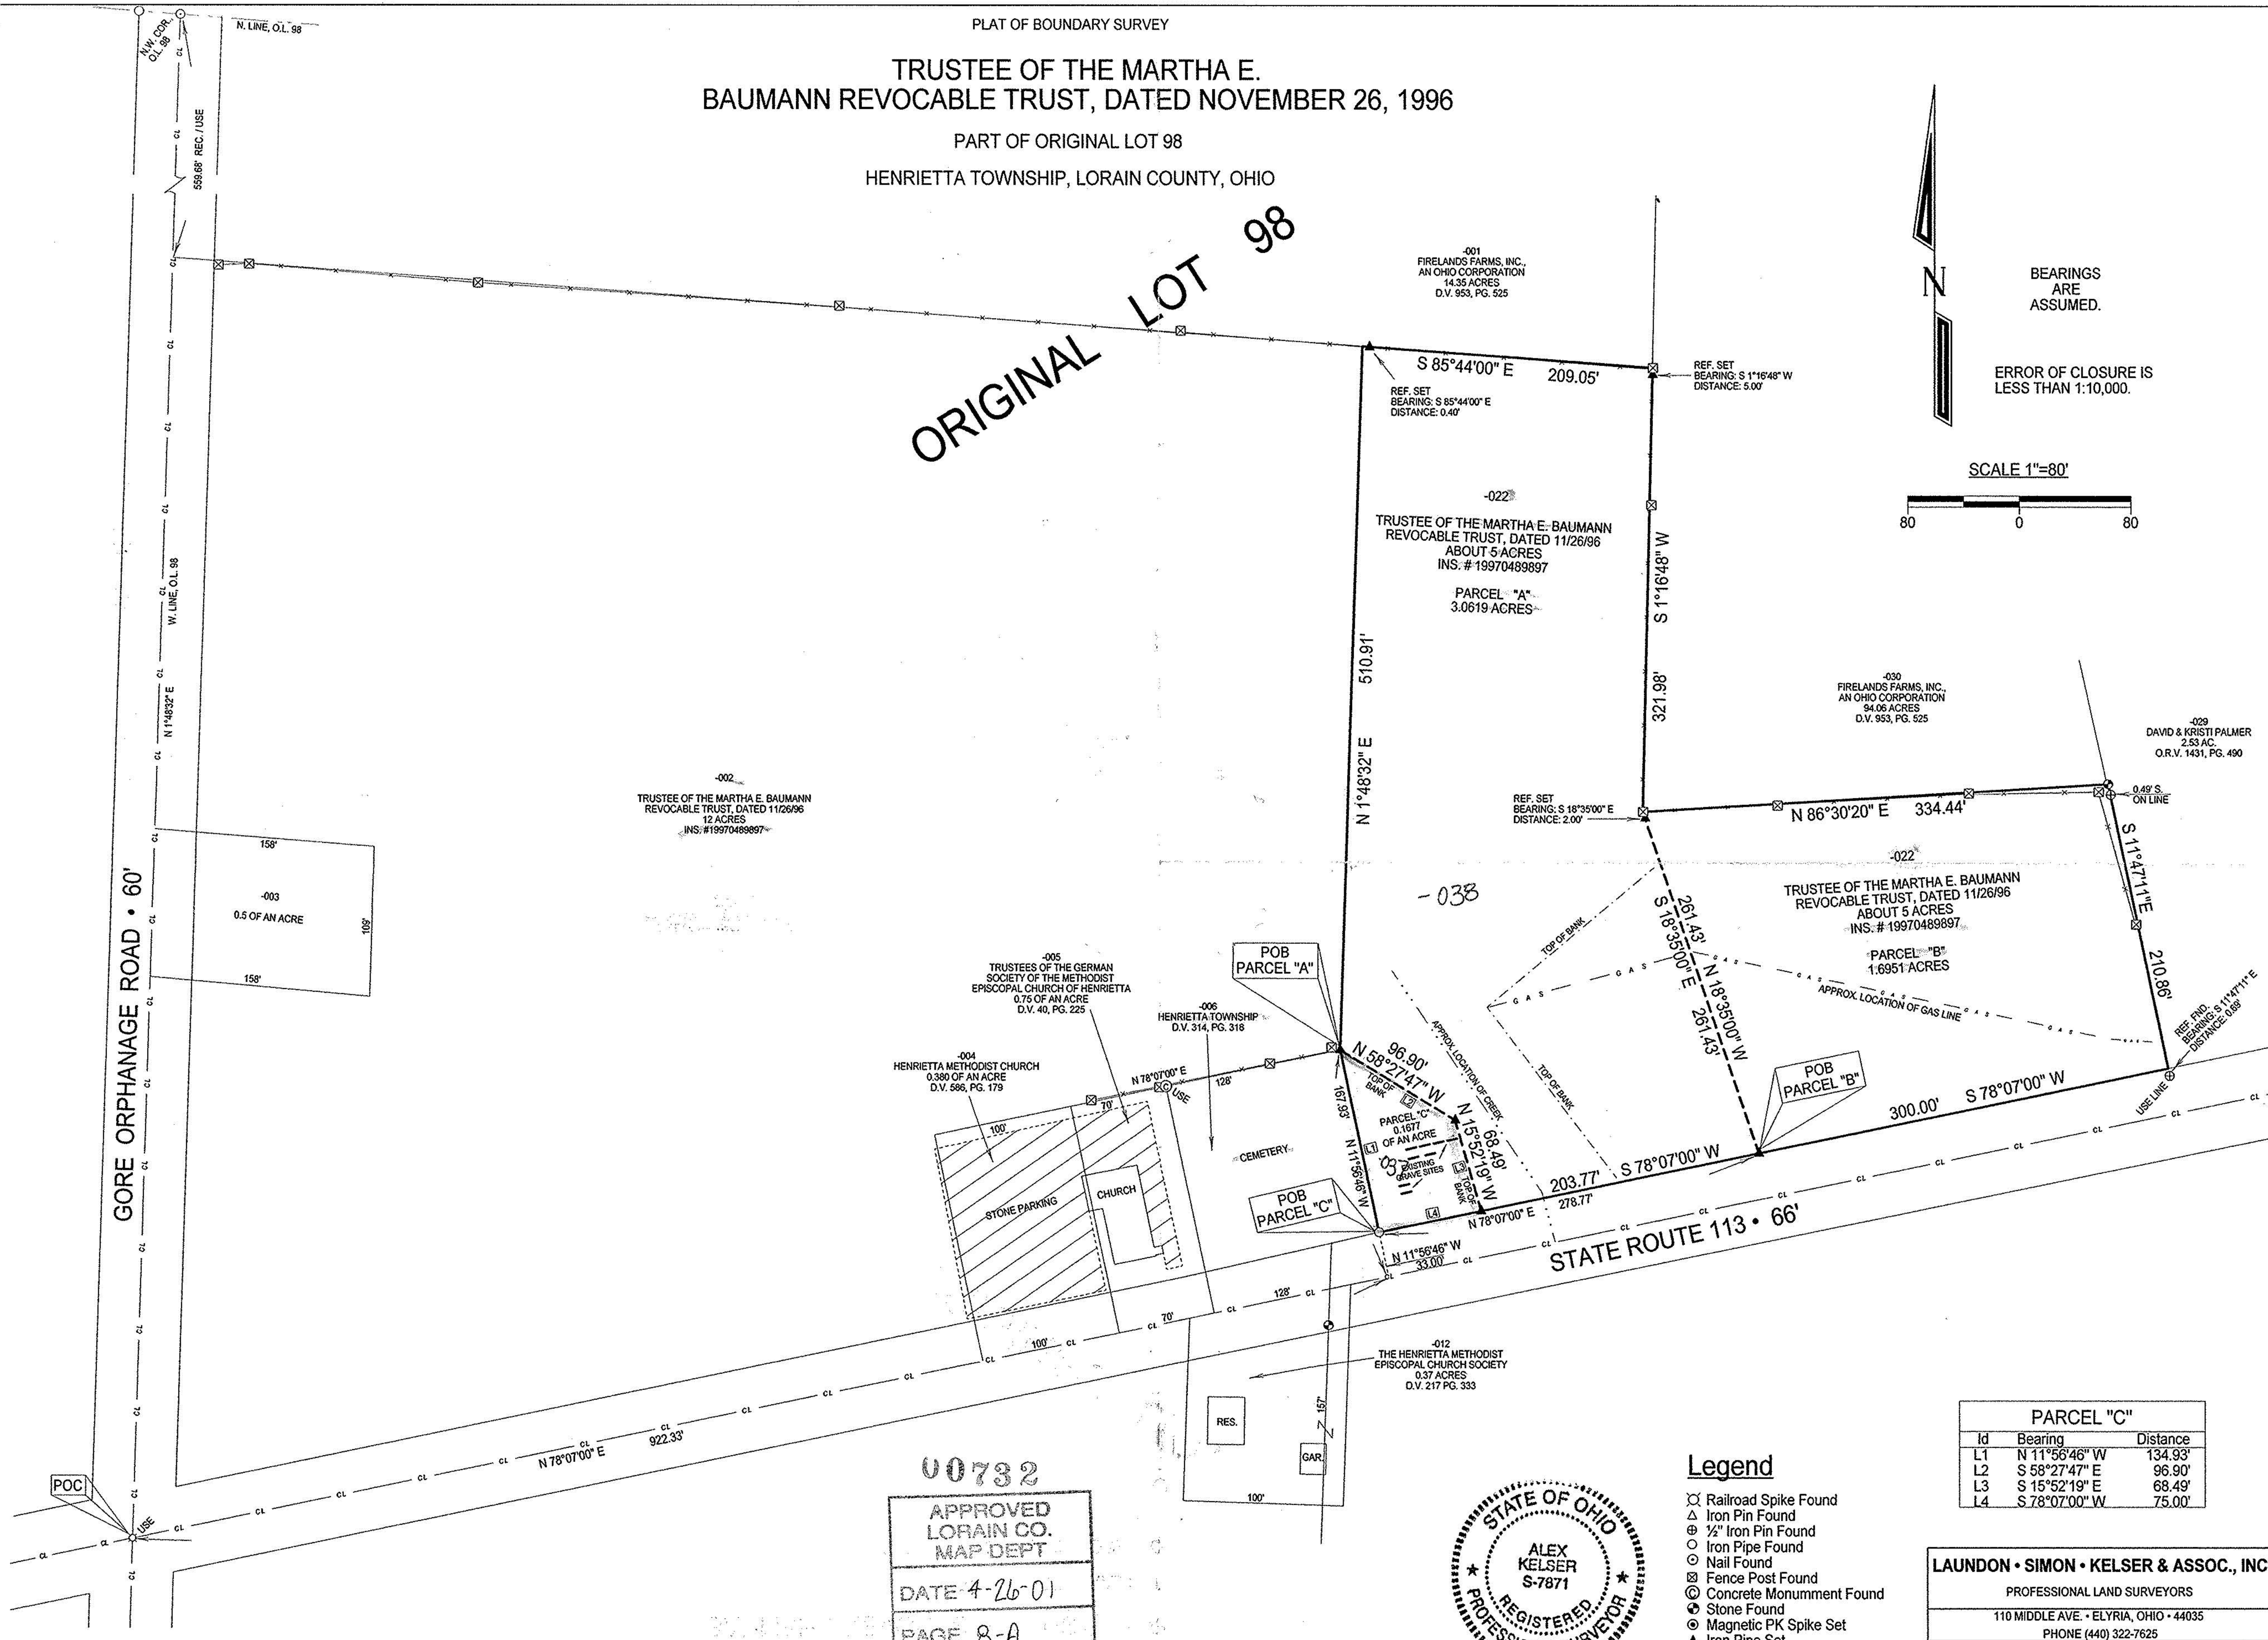


TRUSTEE OF THE MARTHA E. BAUMANN REVOCABLE TRUST, DATED NOVEMBER 26, 1996

PART OF ORIGINAL LOT 98

HENRIETTA TOWNSHIP, LORAIN COUNTY, OHIO

ORIGINAL LOT 98

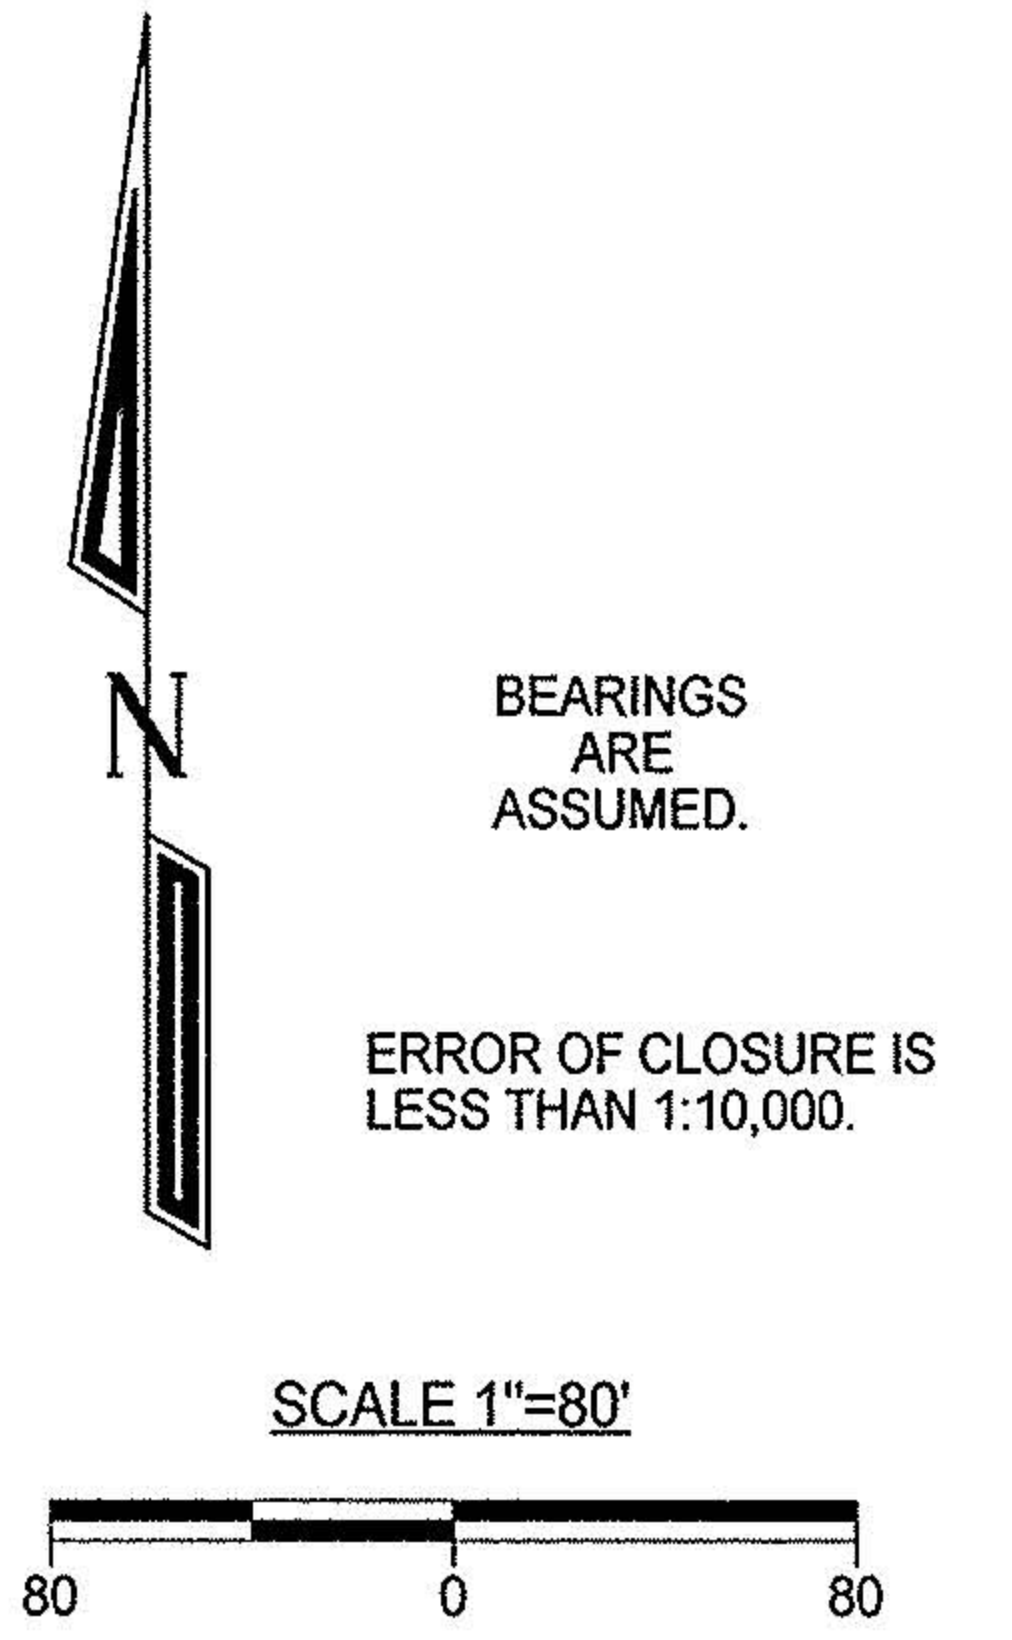

00732  
 APPROVED  
 LORAIN CO.  
 MAP DEPT  
 DATE 4-26-01  
 PAGE 8-A  
 BY JHATFIELD  
 # 01-00732



- Legend**
- ⊗ Railroad Spike Found
  - △ Iron Pin Found
  - ⊕ 1/2" Iron Pin Found
  - Iron Pipe Found
  - Nail Found
  - ⊗ Fence Post Found
  - ⊙ Concrete Monument Found
  - ⊙ Stone Found
  - ⊙ Magnetic PK Spike Set
  - ▲ Iron Pipe Set

PARCEL "C"		
Id	Bearing	Distance
L1	N 11°56'46" W	134.93'
L2	S 58°27'47" E	96.90'
L3	S 15°52'19" E	68.49'
L4	S 78°07'00" W	75.00'

**LAUNDON • SIMON • KELSNER & ASSOC., INC.**  
 PROFESSIONAL LAND SURVEYORS  
 110 MIDDLE AVE. • ELYRIA, OHIO • 44035  
 PHONE (440) 322-7625  
 Alex Kelsler  
 RLS #7871

DATE: 01/01/01  
 JOB NO.: 003314