
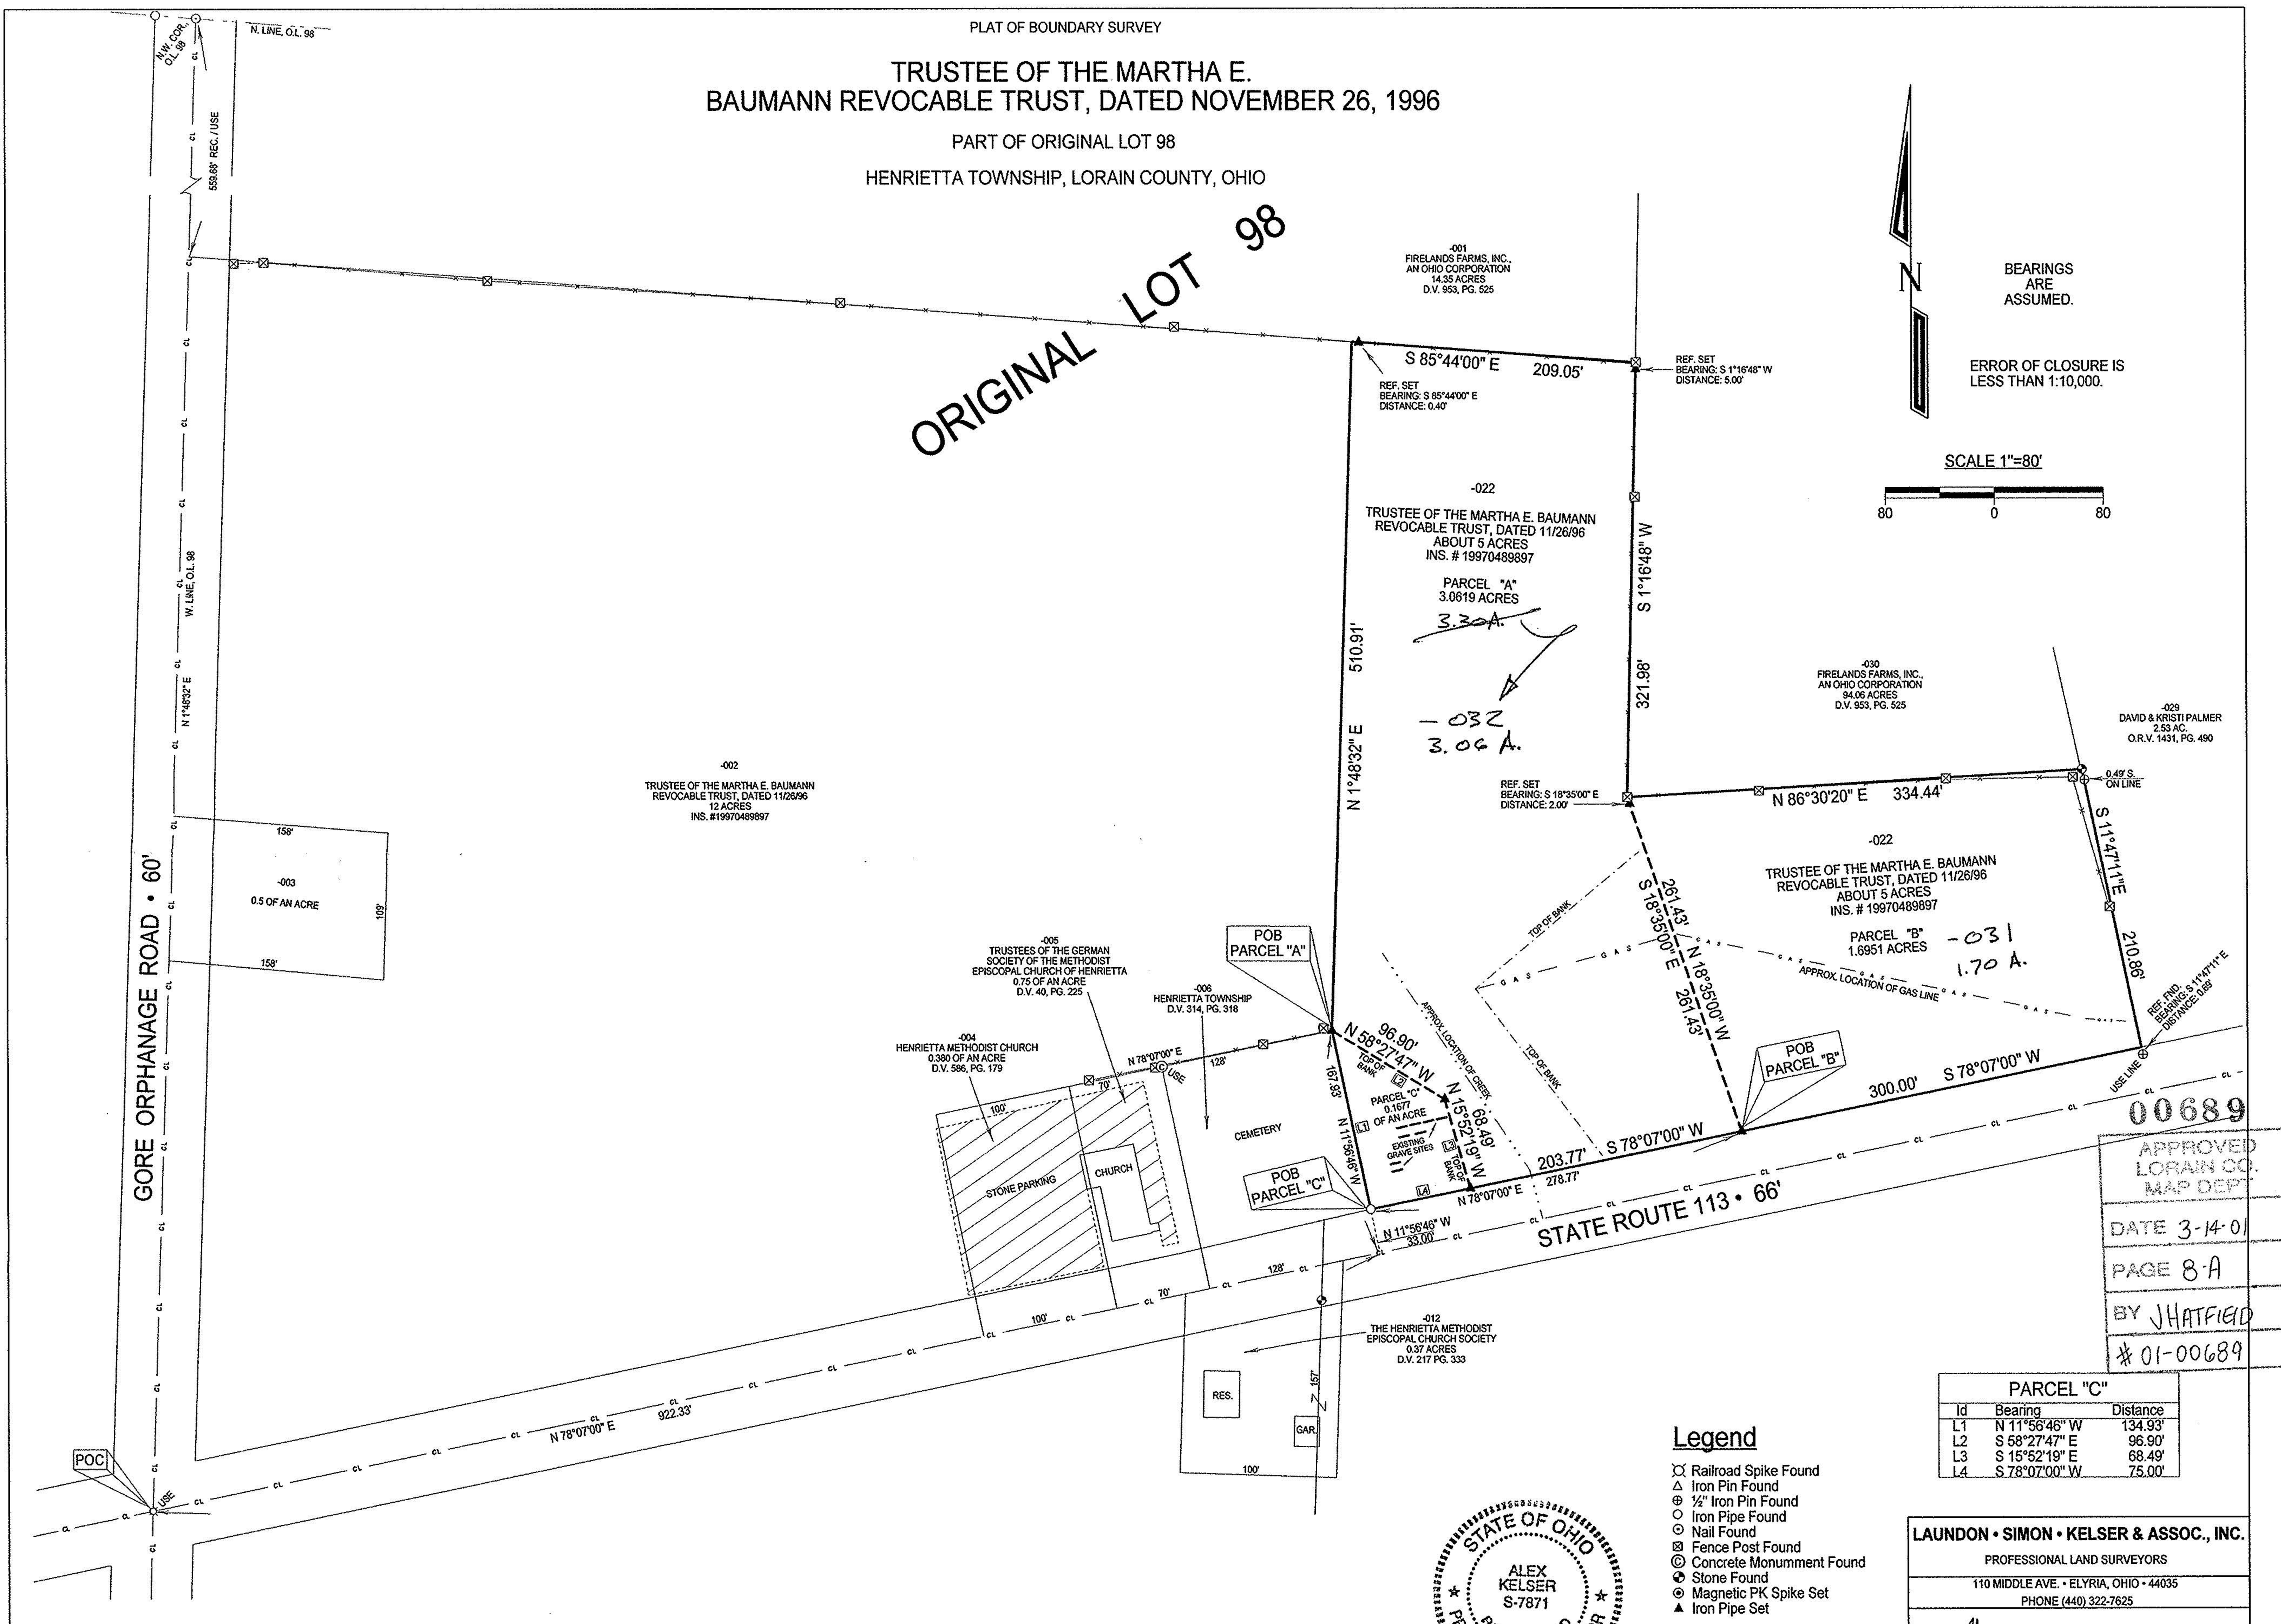


TRUSTEE OF THE MARTHA E. BAUMANN REVOCABLE TRUST, DATED NOVEMBER 26, 1996

PART OF ORIGINAL LOT 98
HENRIETTA TOWNSHIP, LORAIN COUNTY, OHIO

ORIGINAL LOT 98

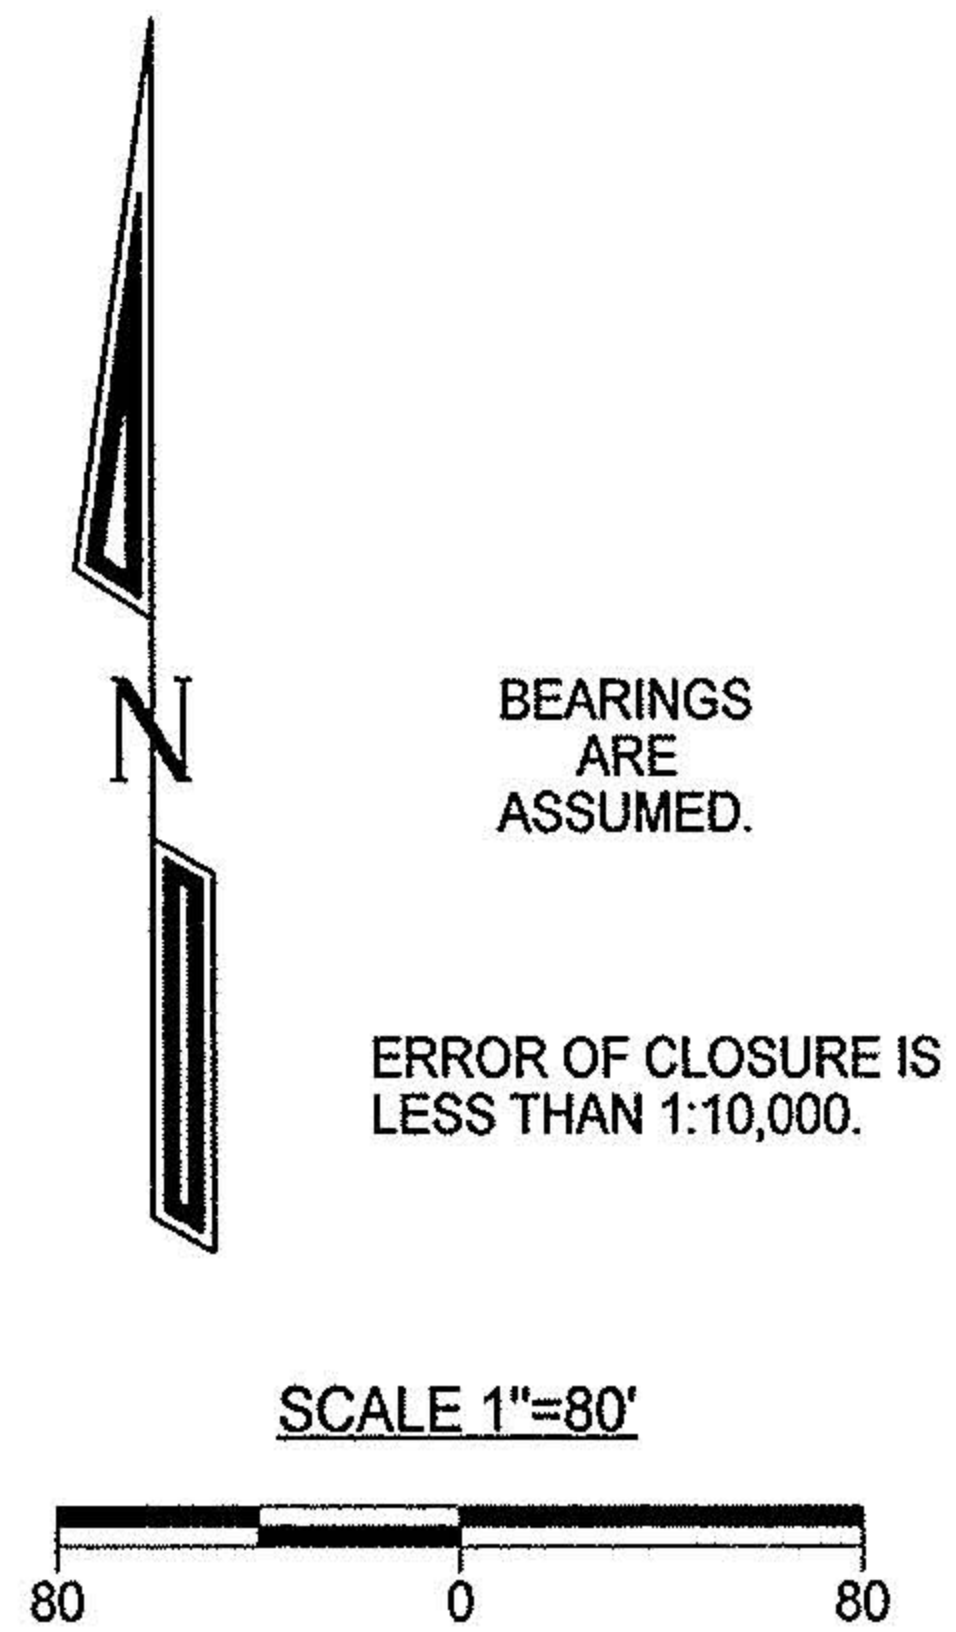

GORE ORPHANAGE ROAD • 60'

STATE ROUTE 113 • 66'

00689

APPROVED
LORAIN CO.
MAP DEPT.
DATE 3-14-01
PAGE 8-A
BY JHATFIELD
01-00689

PARCEL "C"		
Id	Bearing	Distance
L1	N 11°56'46" W	134.93'
L2	S 58°27'47" E	96.90'
L3	S 15°52'19" E	68.49'
L4	S 78°07'00" W	75.00'

Legend

- ⊗ Railroad Spike Found
- △ Iron Pin Found
- ⊕ 1/2" Iron Pin Found
- Iron Pipe Found
- Nail Found
- ⊗ Fence Post Found
- ⊙ Concrete Monument Found
- ⊕ Stone Found
- ⊙ Magnetic PK Spike Set
- ▲ Iron Pipe Set



LAUNDON • SIMON • KELSNER & ASSOC., INC.
PROFESSIONAL LAND SURVEYORS
110 MIDDLE AVE. • ELYRIA, OHIO • 44035
PHONE (440) 322-7625

Alex Kelsler RLS #7871

DATE:	01/01/01
JOB NO.:	003314