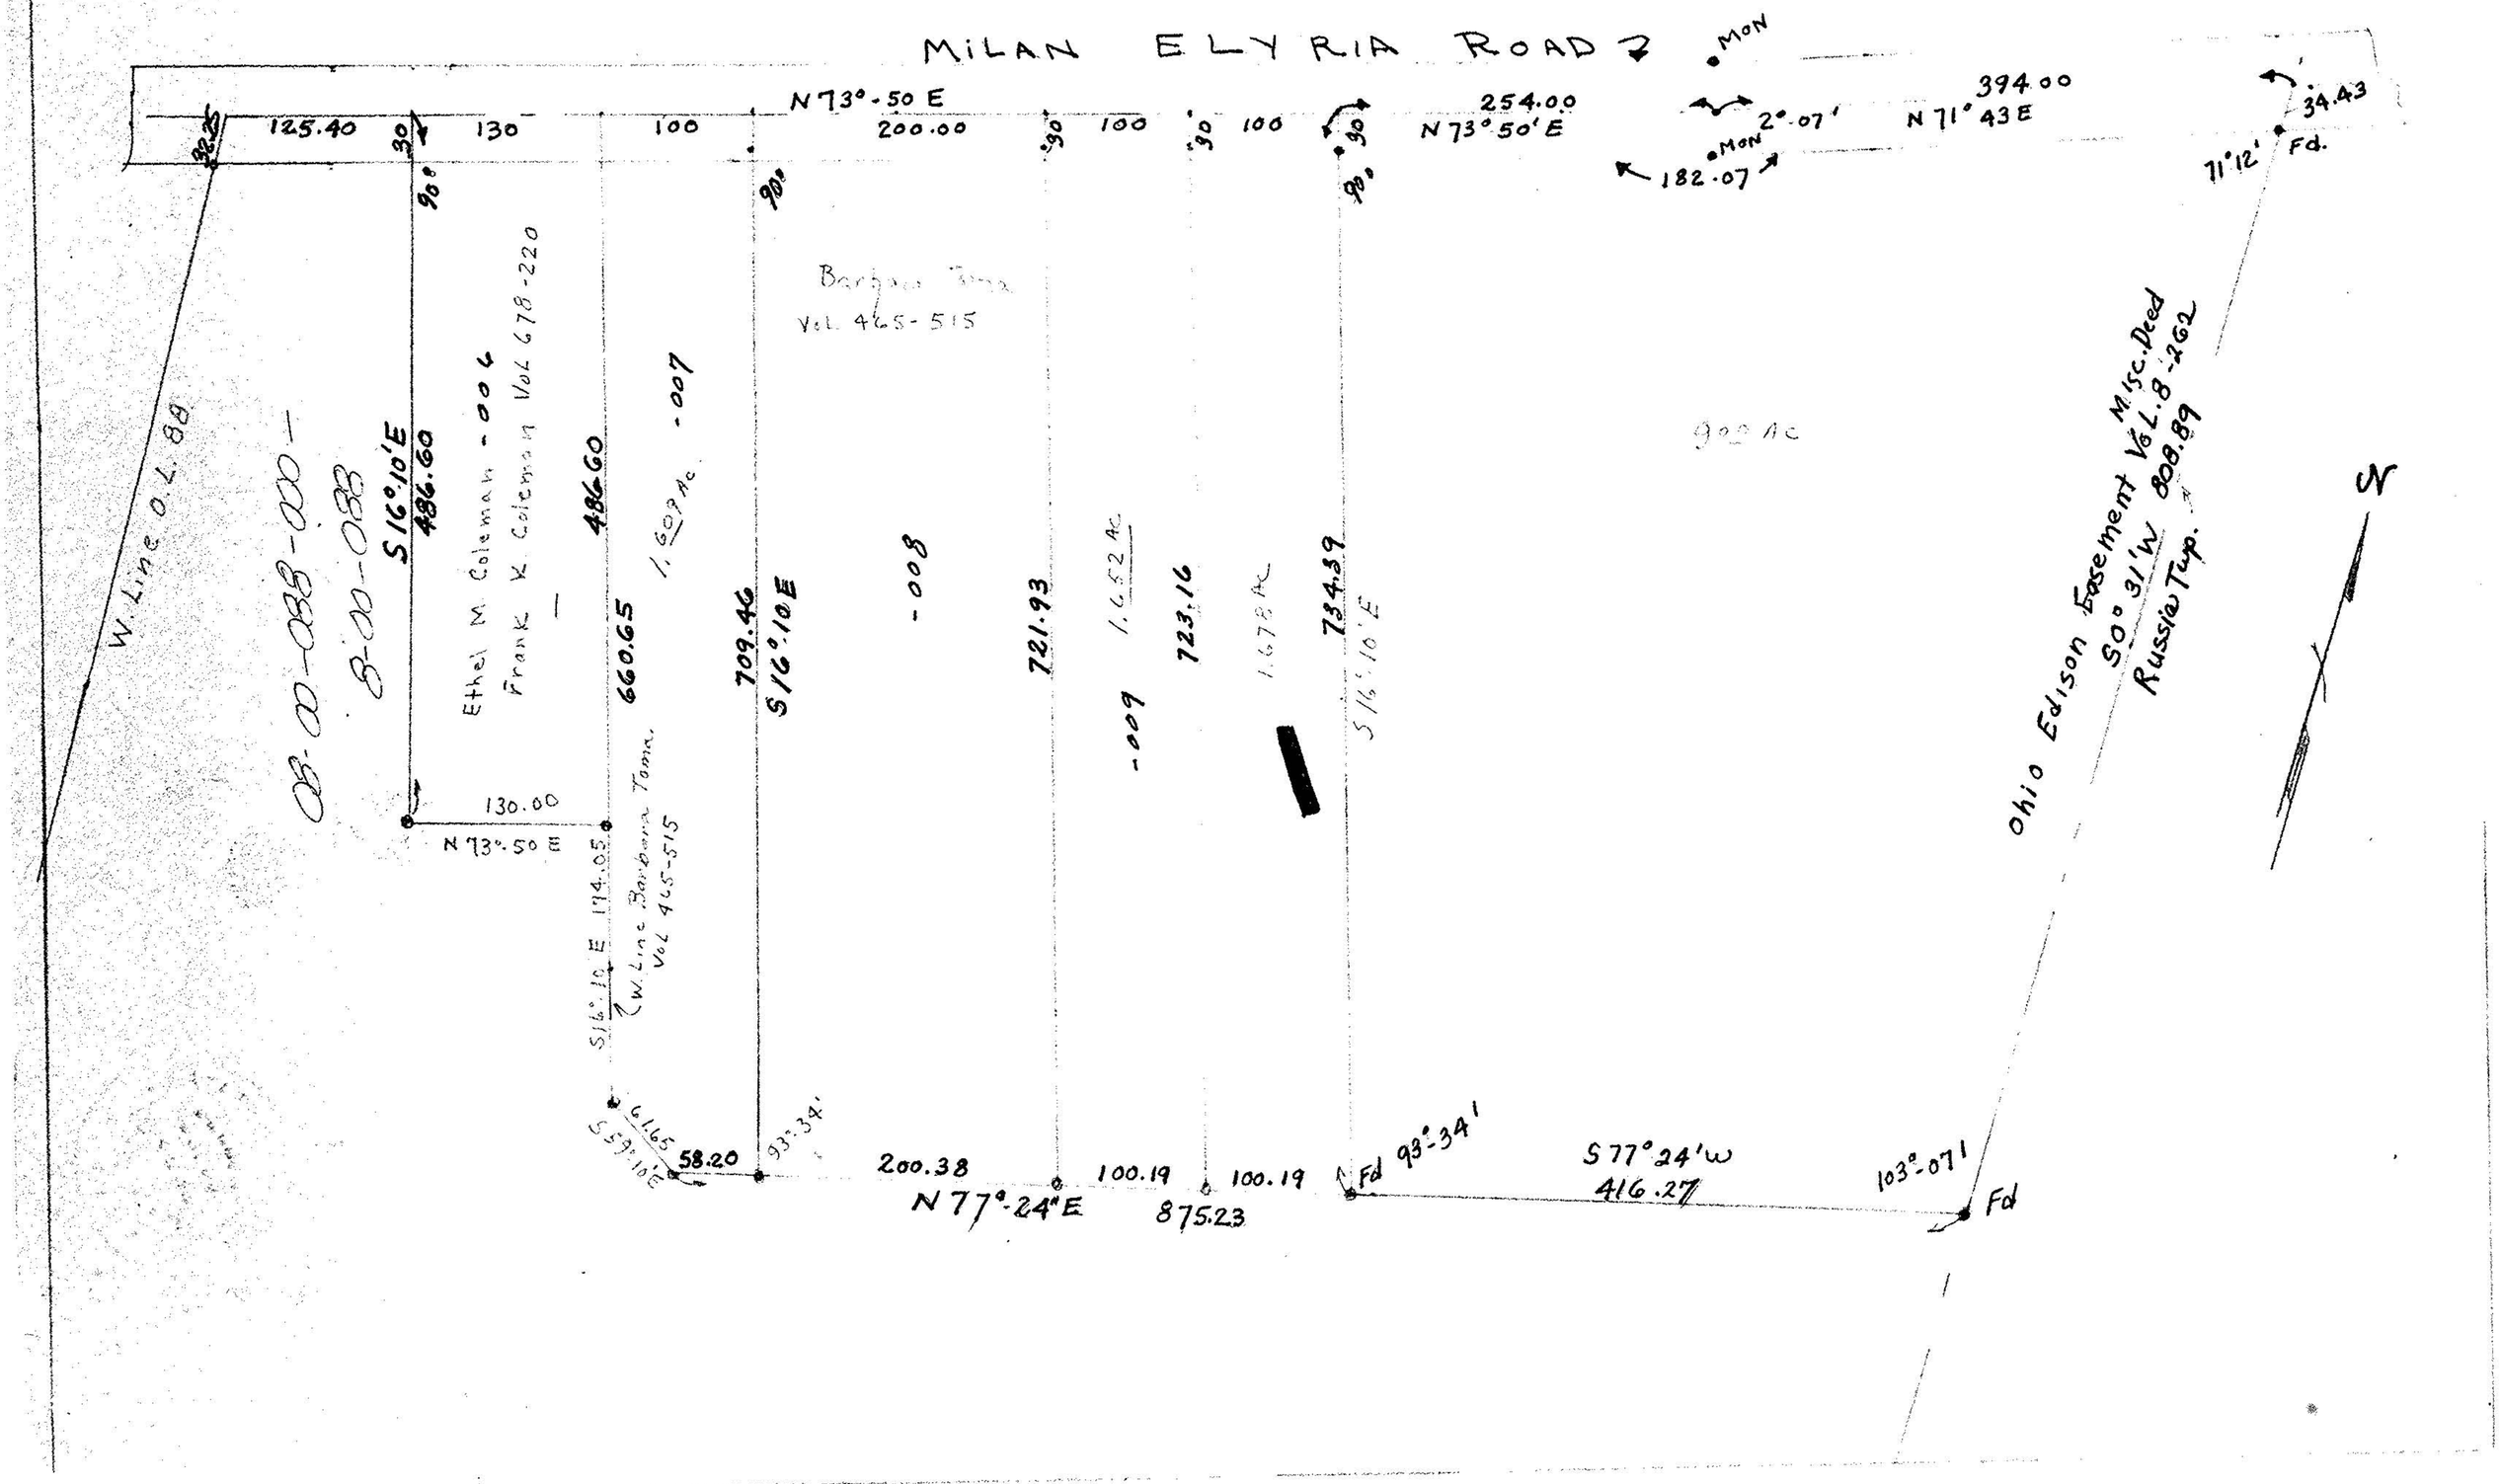MAP OF SURVEY FOR ANNA NOVAK
PART OF C.L. 88 HENRIETTA TWP.
LORAIN CO. OHIO [illegible]
SEPT 17, 1982
BY ARNOLD [illegible] REGISTERED SURVEYOR