
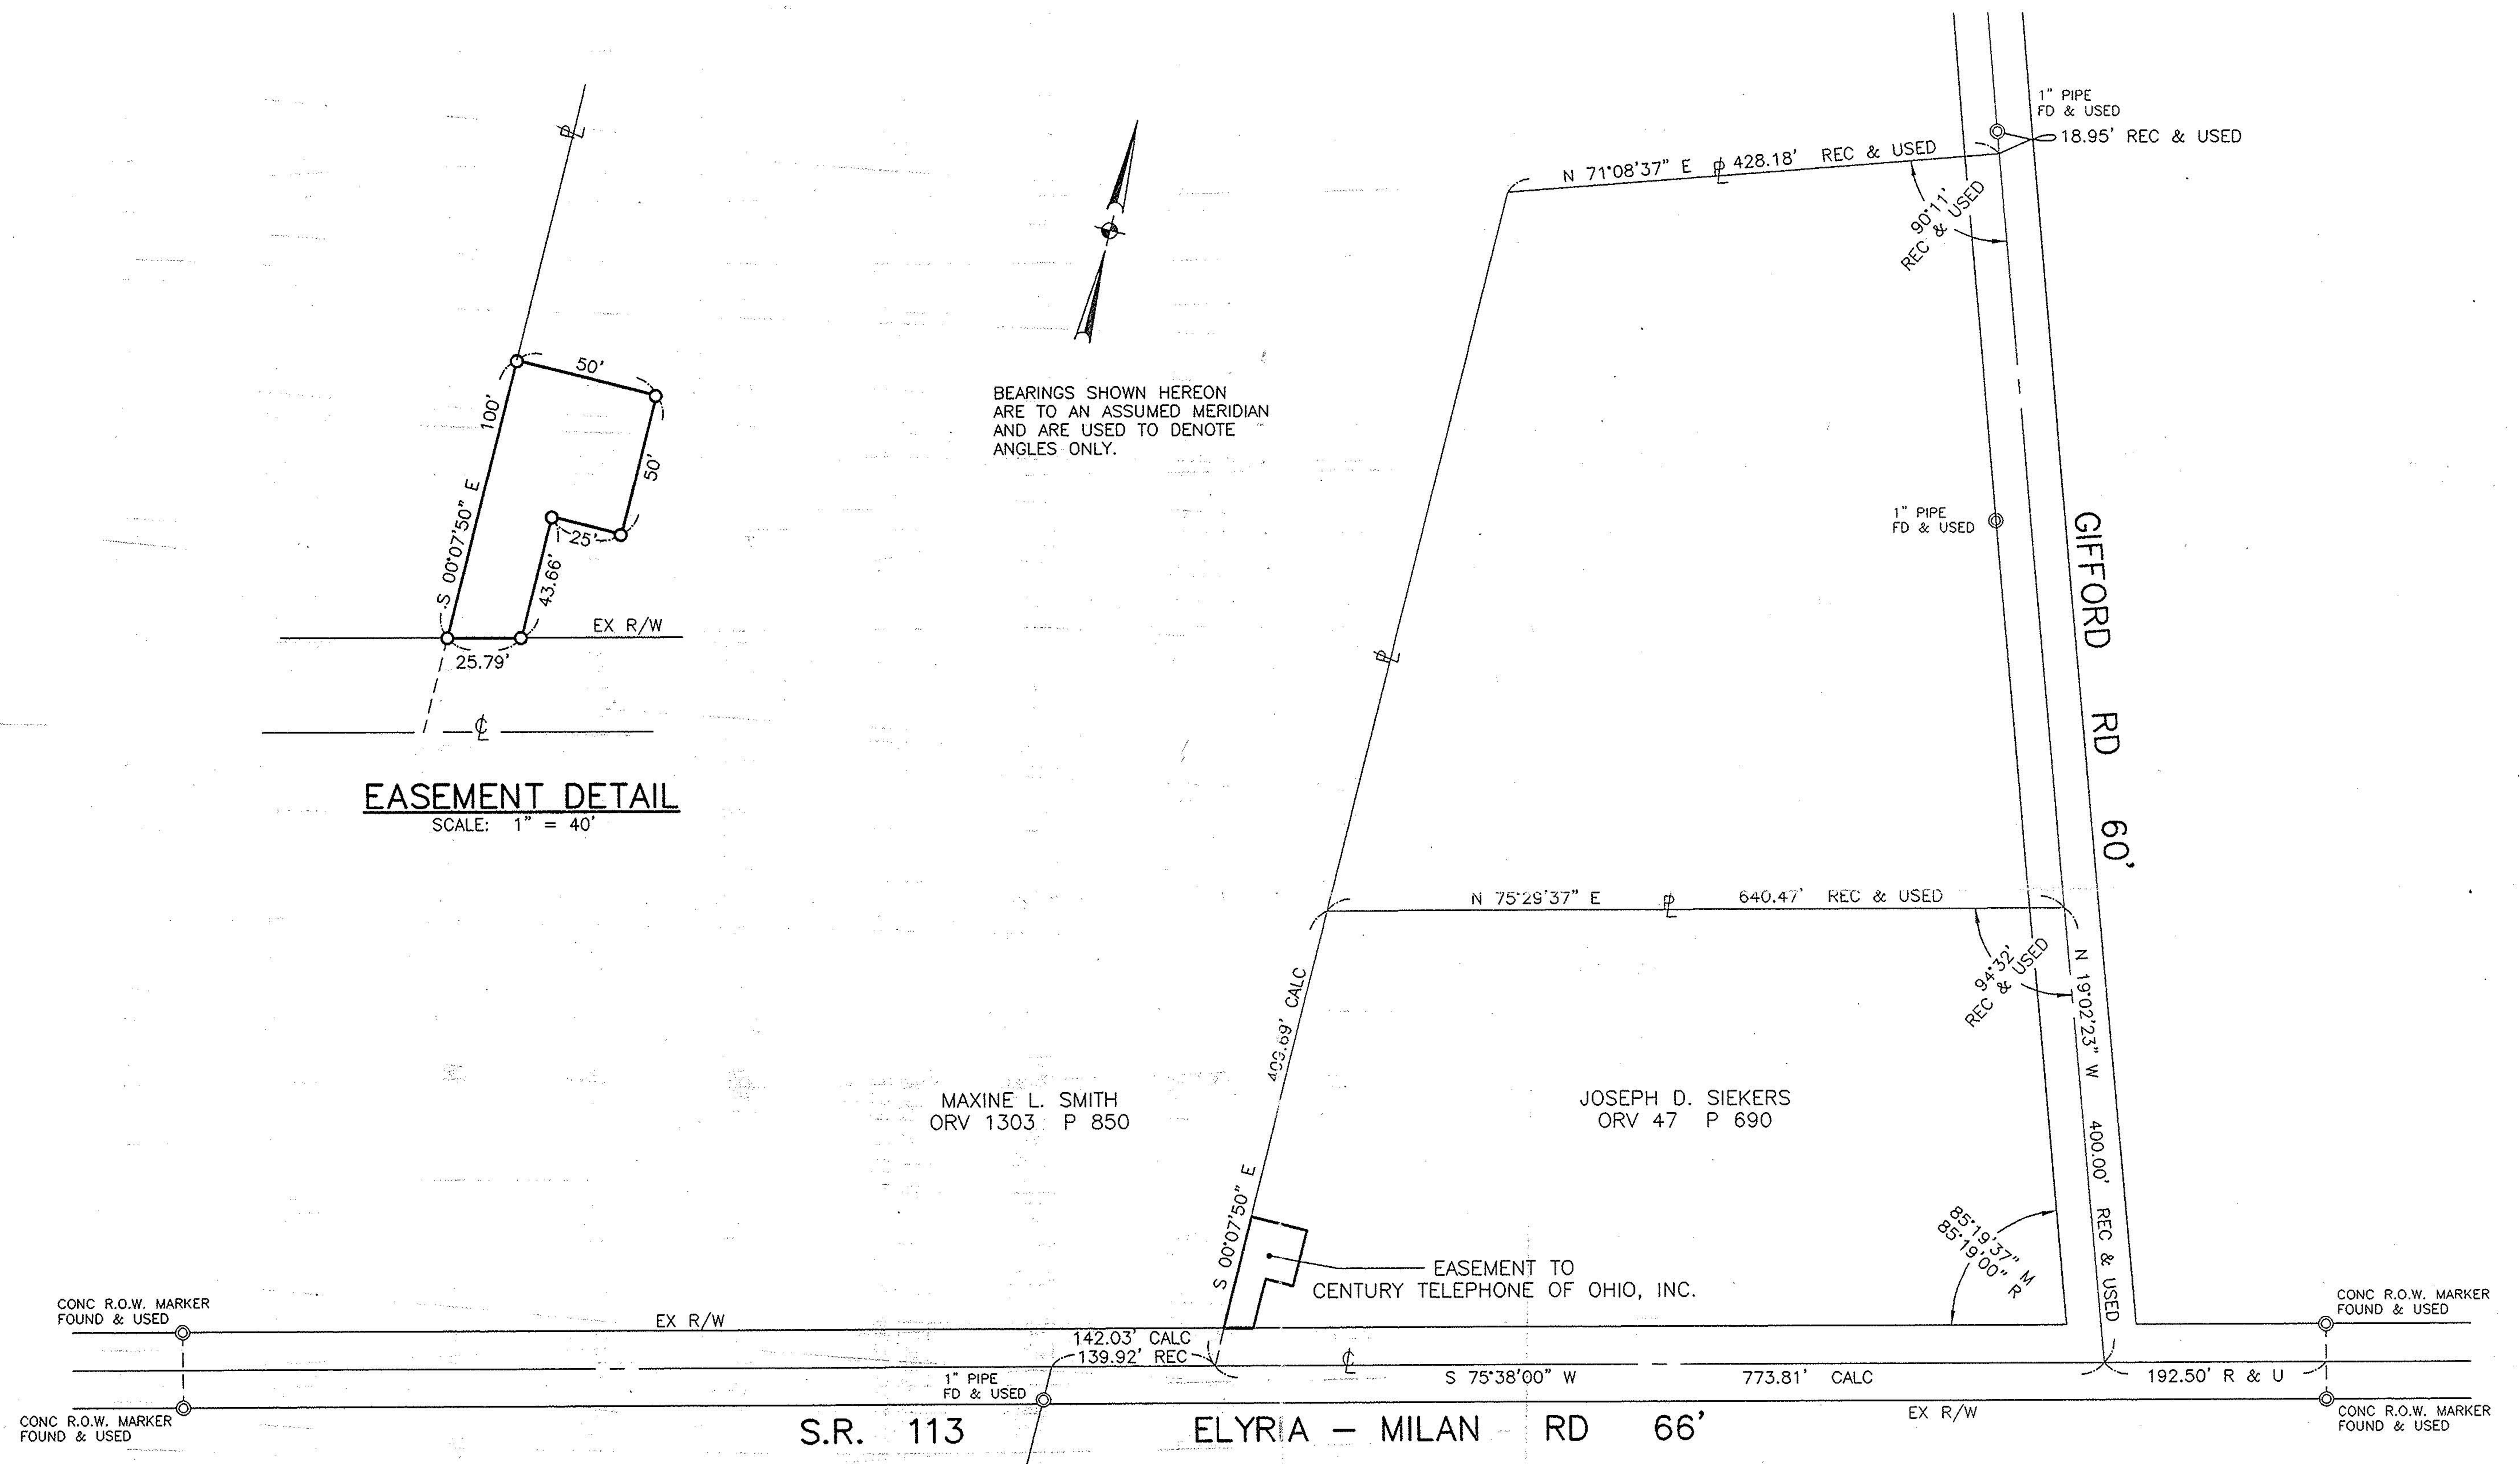


EASEMENT DETAIL
SCALE: 1" = 40'

BEARINGS SHOWN HEREON
ARE TO AN ASSUMED MERIDIAN
AND ARE USED TO DENOTE
ANGLES ONLY.

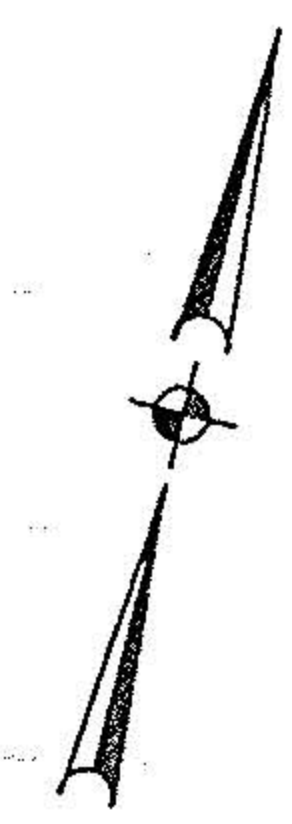

MAXINE L. SMITH
ORV 1303 P 850

JOSEPH D. SIEKERS
ORV 47 P 690

EASEMENT TO
CENTURY TELEPHONE OF OHIO, INC.

S.R. 113 ELYRIA - MILAN RD 66'

CONC R.O.W. MARKER
FOUND & USED


CONC R.O.W. MARKER
FOUND & USED

LEGEND

- 5/8" CAPPED REBAR SET
- ⊙ IRON PIN FOUND
- ☒ MONUMENT BOX FOUND

ABBREVIATIONS

- REC - RECORD
- R & U - RECORD & USED
- CALC - CALCULATED

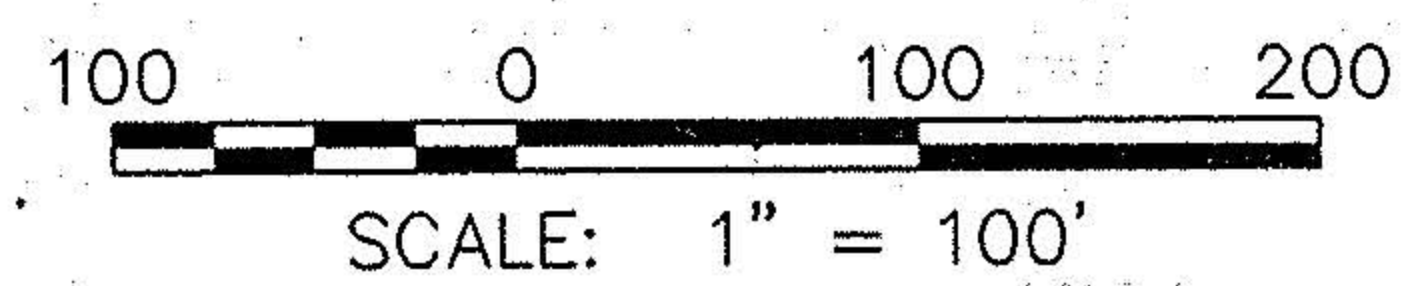

1" PIPE
FD & USED

David L. Elwell
DAVID L. ELWELL
REGISTERED SURVEYOR NO. 6333



SURVEY MAP
PART OF ORIG. HENRIETTA TWP.
LOT NO. 91
TOWNSHIP OF HENRIETTA
COUNTY OF LORAIN STATE OF OHIO
11-20-96

KS ASSOCIATES, INC.
ENGINEERS/SURVEYORS
424 Middle Avenue
P.O. Box 59
Elyria, Ohio 44026
PHONE (216) 322-6317 FAX (216) 284-0623

