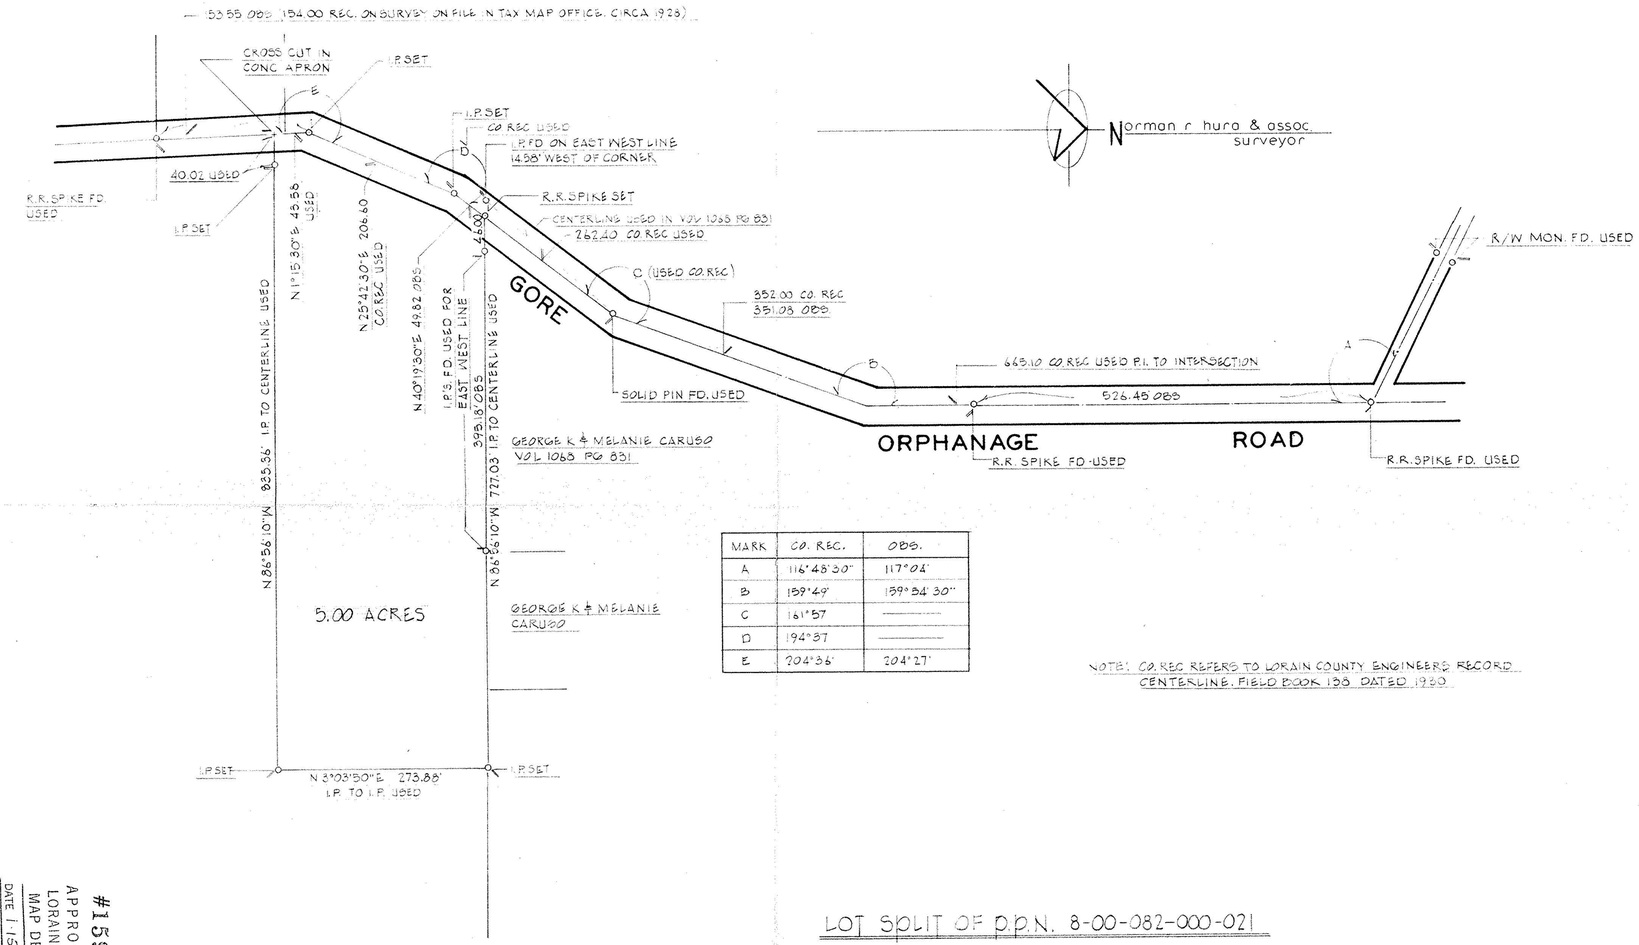

MARK	CO. REC.	088.
A	116°48'30"	117°04'
B	159°49'	159°54'30"
C	161°57'	———
D	194°37'	———
E	204°36'	204°27'

NOTE: CO. REC REFERS TO LORAIN COUNTY ENGINEERS RECORD CENTERLINE. FIELD BOOK 1133 DATED 1950

LOT SPLIT OF P.P.N. 8-00-082-000-021

PART OF ORIGINAL HENRIETTA TWP. LOT NO. 82

LORAIN COUNTY—OHIO

SCALE 1" = 100' NOV. 13 1984

#15988
APPROVED
LORAIN CO.
MAP DEPT.
DATE 1-15-85
PAGE 8-A
BY T. McFaul
VOID

STATE OF OHIO
N. R. HURA
S-5208
REGISTERED PROFESSIONAL SURVEYOR

2021

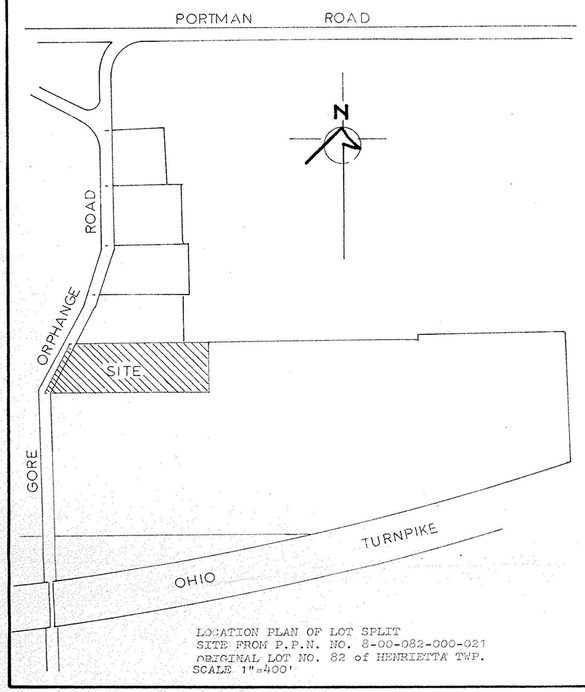

LOCATION PLAN OF LOT SPLIT
SITE FROM P.P.N. NO. 8-00-082-000-021
ORIGINAL LOT NO. 82 of HENRIETTA TWP.
SCALE 1" = 400'