

033  
 34.78A  
 23.66A


#21443  
 34.78 - 033 0.4.97  
 2.31 027 0.4.25  
 2.11 - 008 - 02. 1

---

39.20 A  
 23.66 A

---

15.54 A

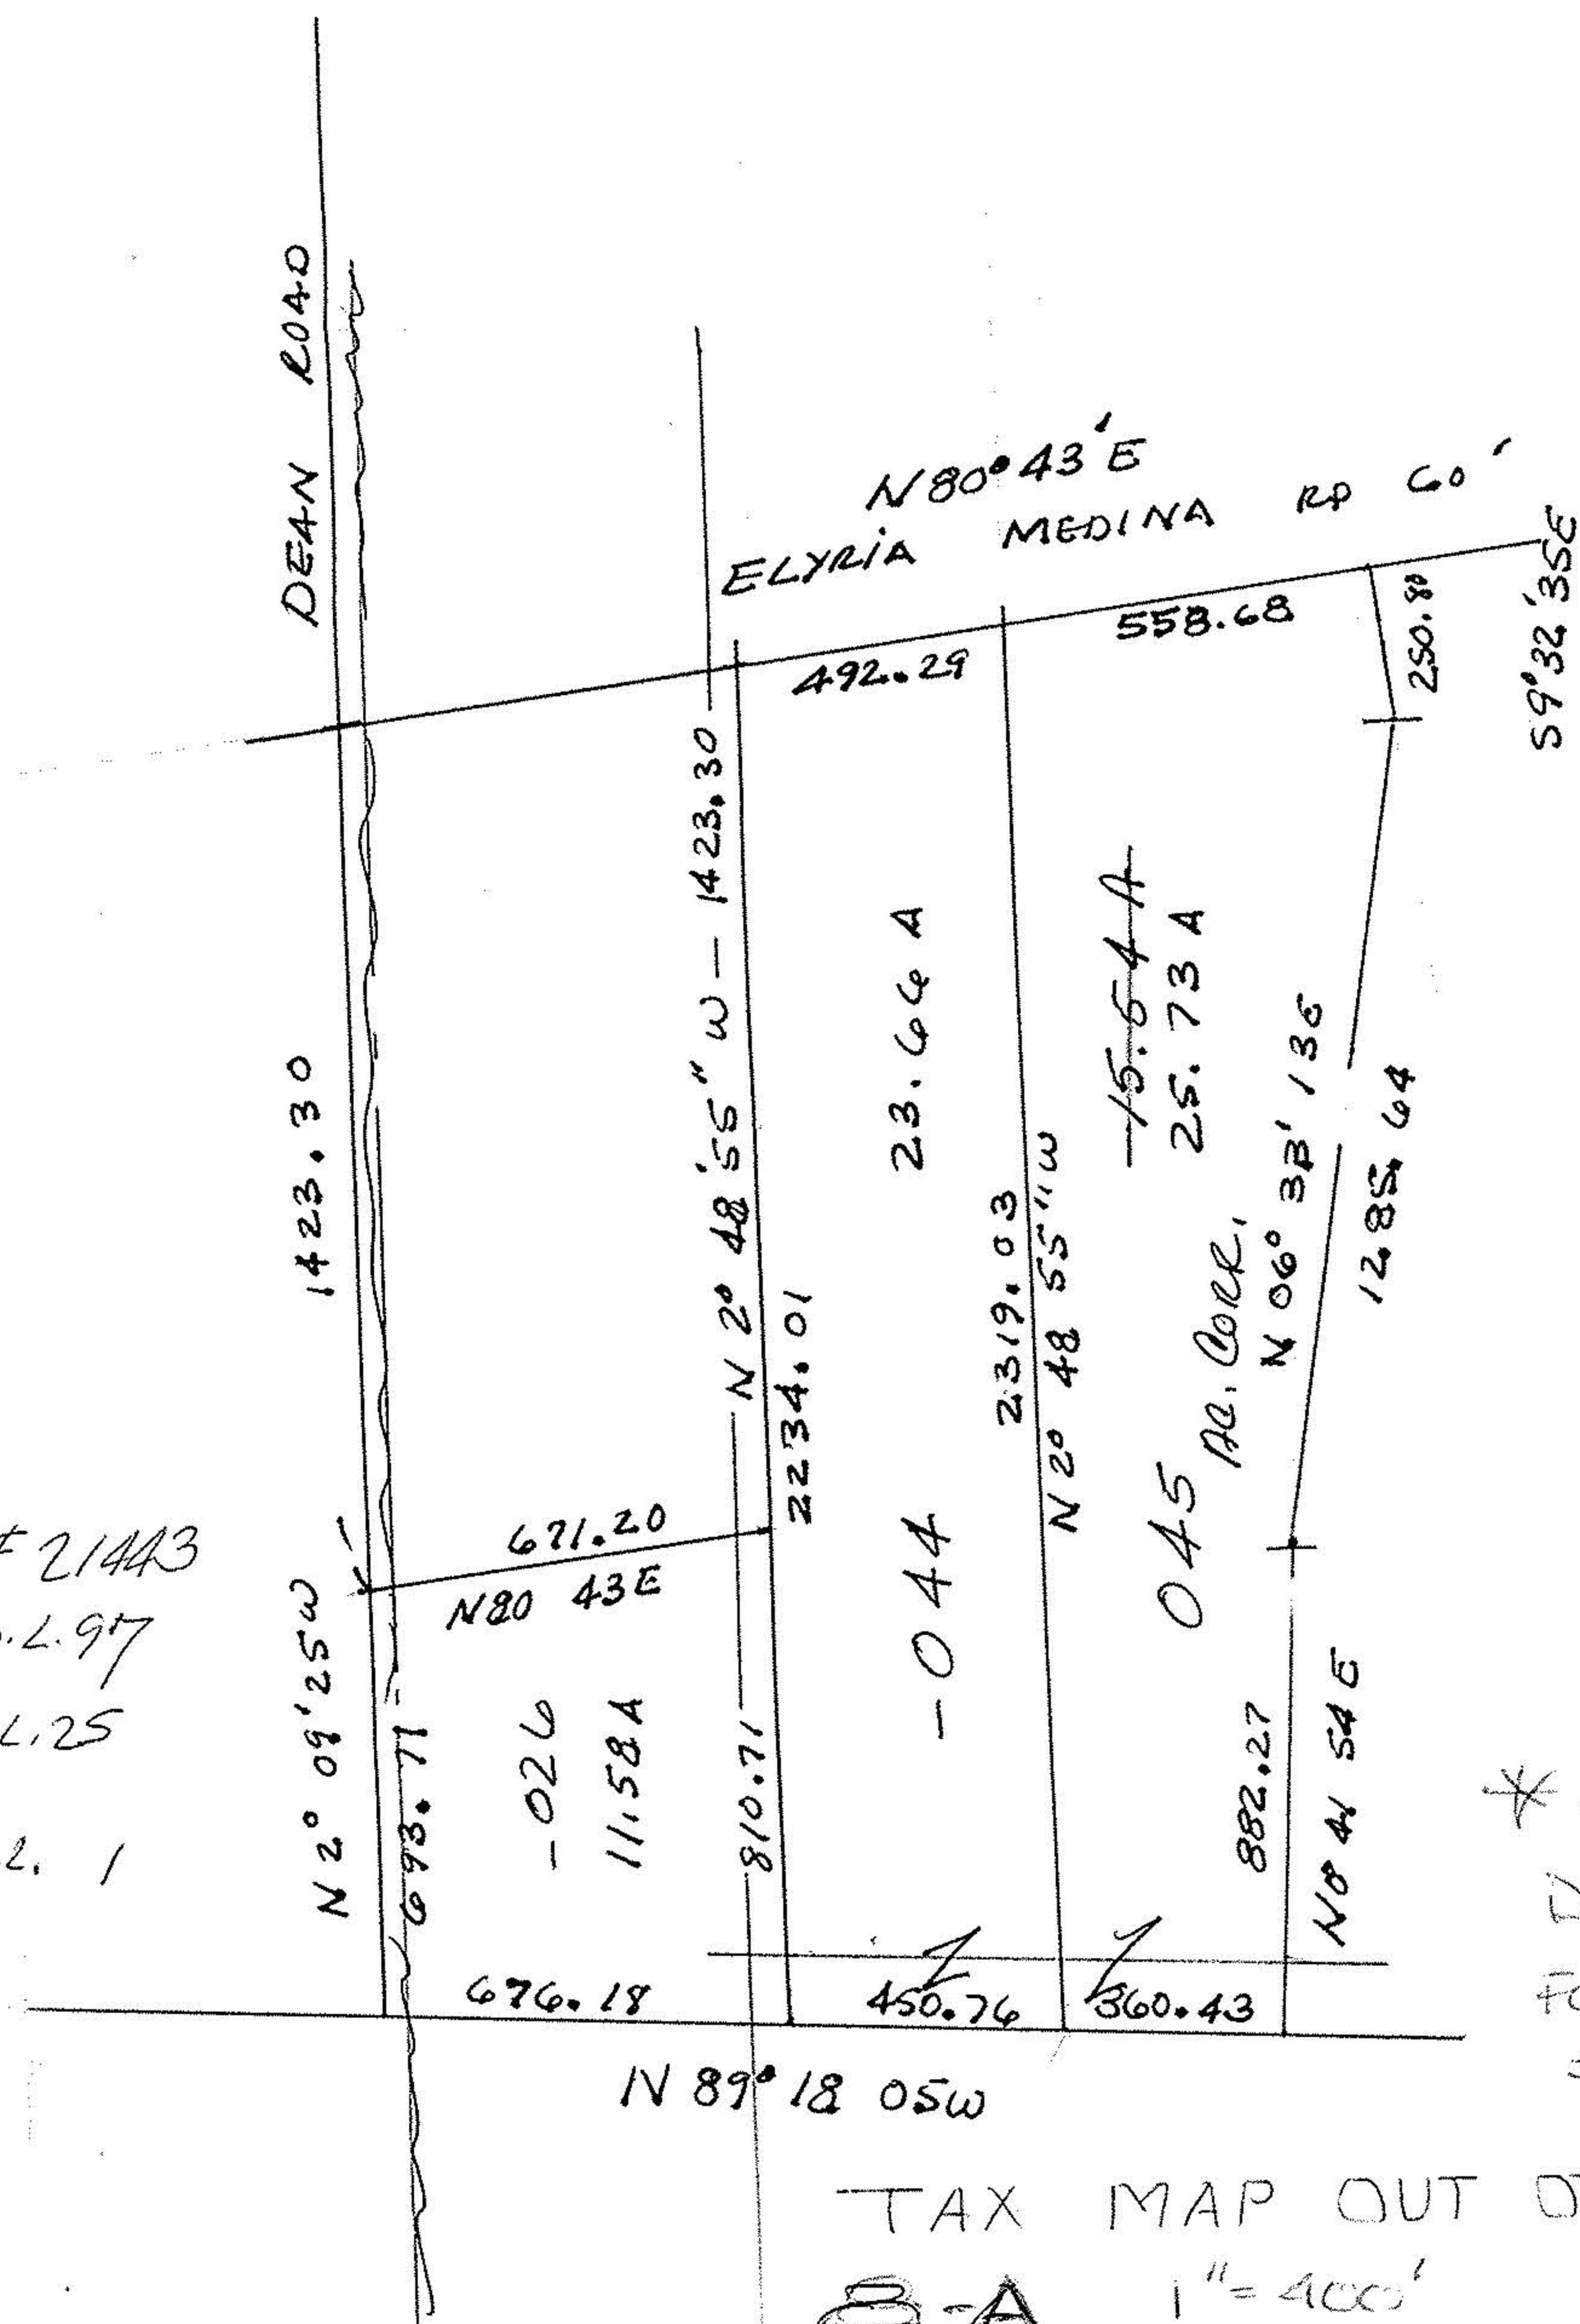

\* USE IN RE-DRAW OF MAP FOR SPLIT #21443

TAX MAP OUT OF SCALE  
 08-00-097-000-033  
 - 14-001-000-008  
 20-025-000-027