


Red indicates prop property lines when  
this property is Transferred

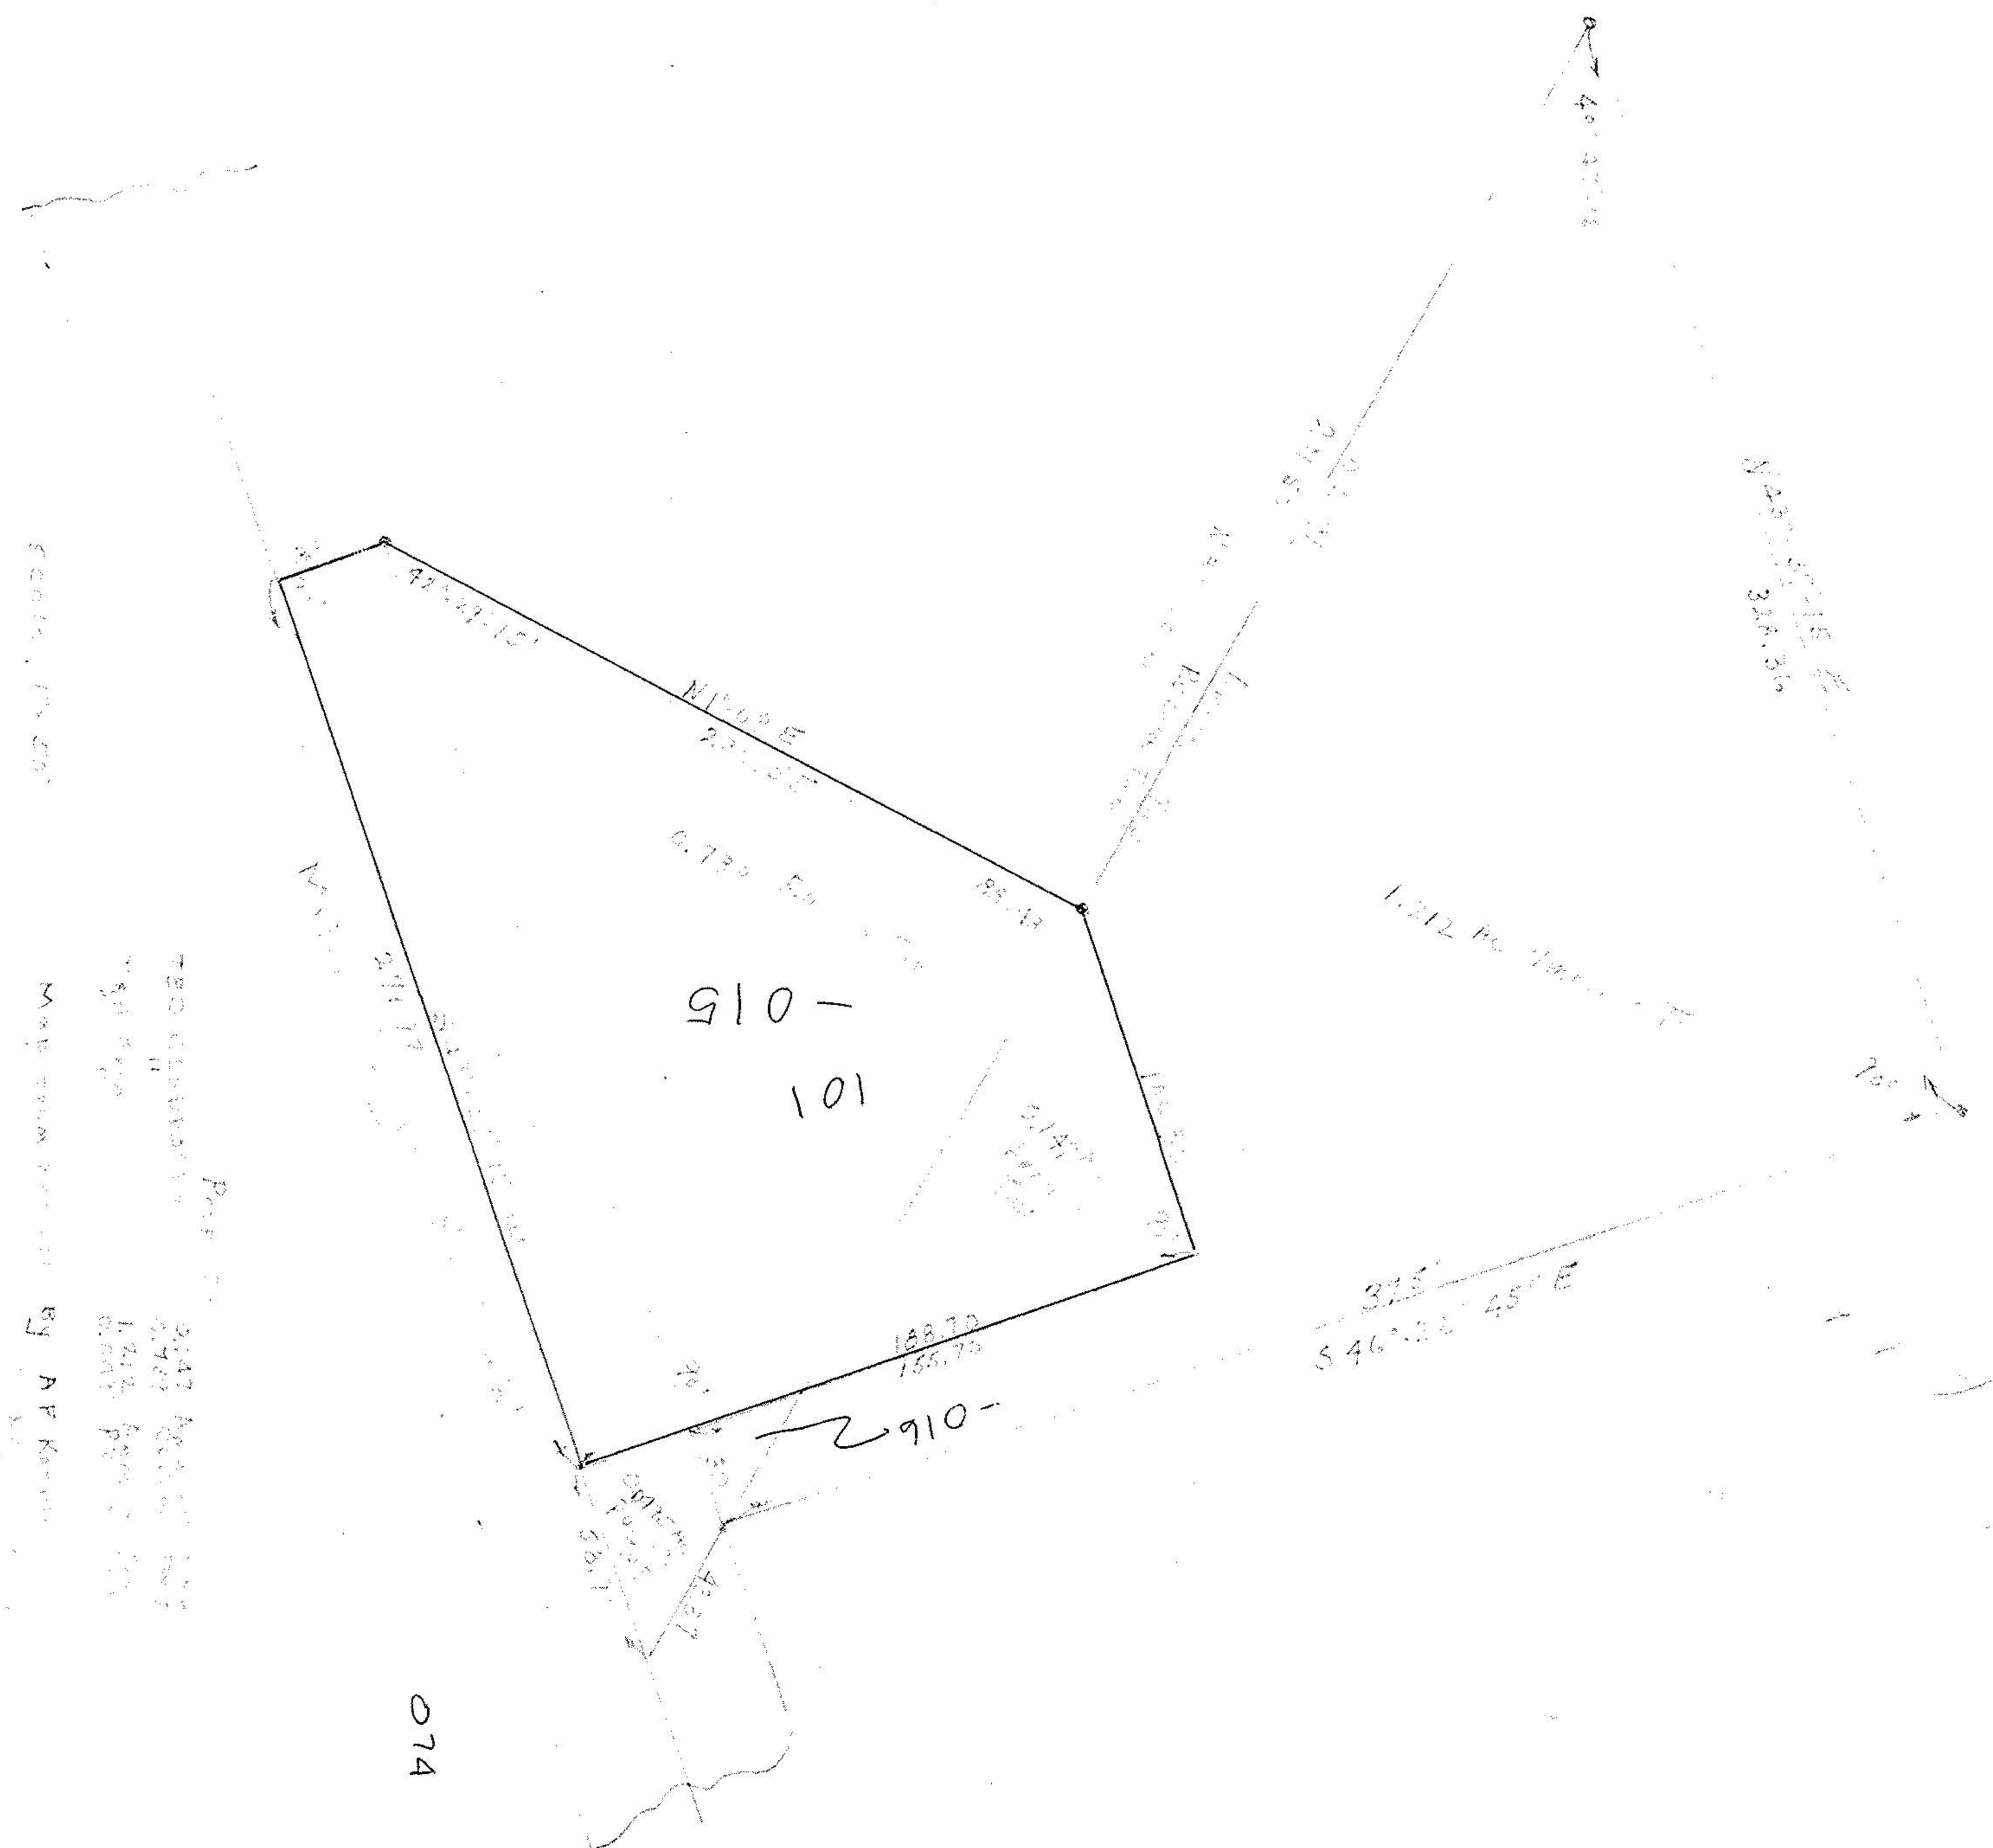

074