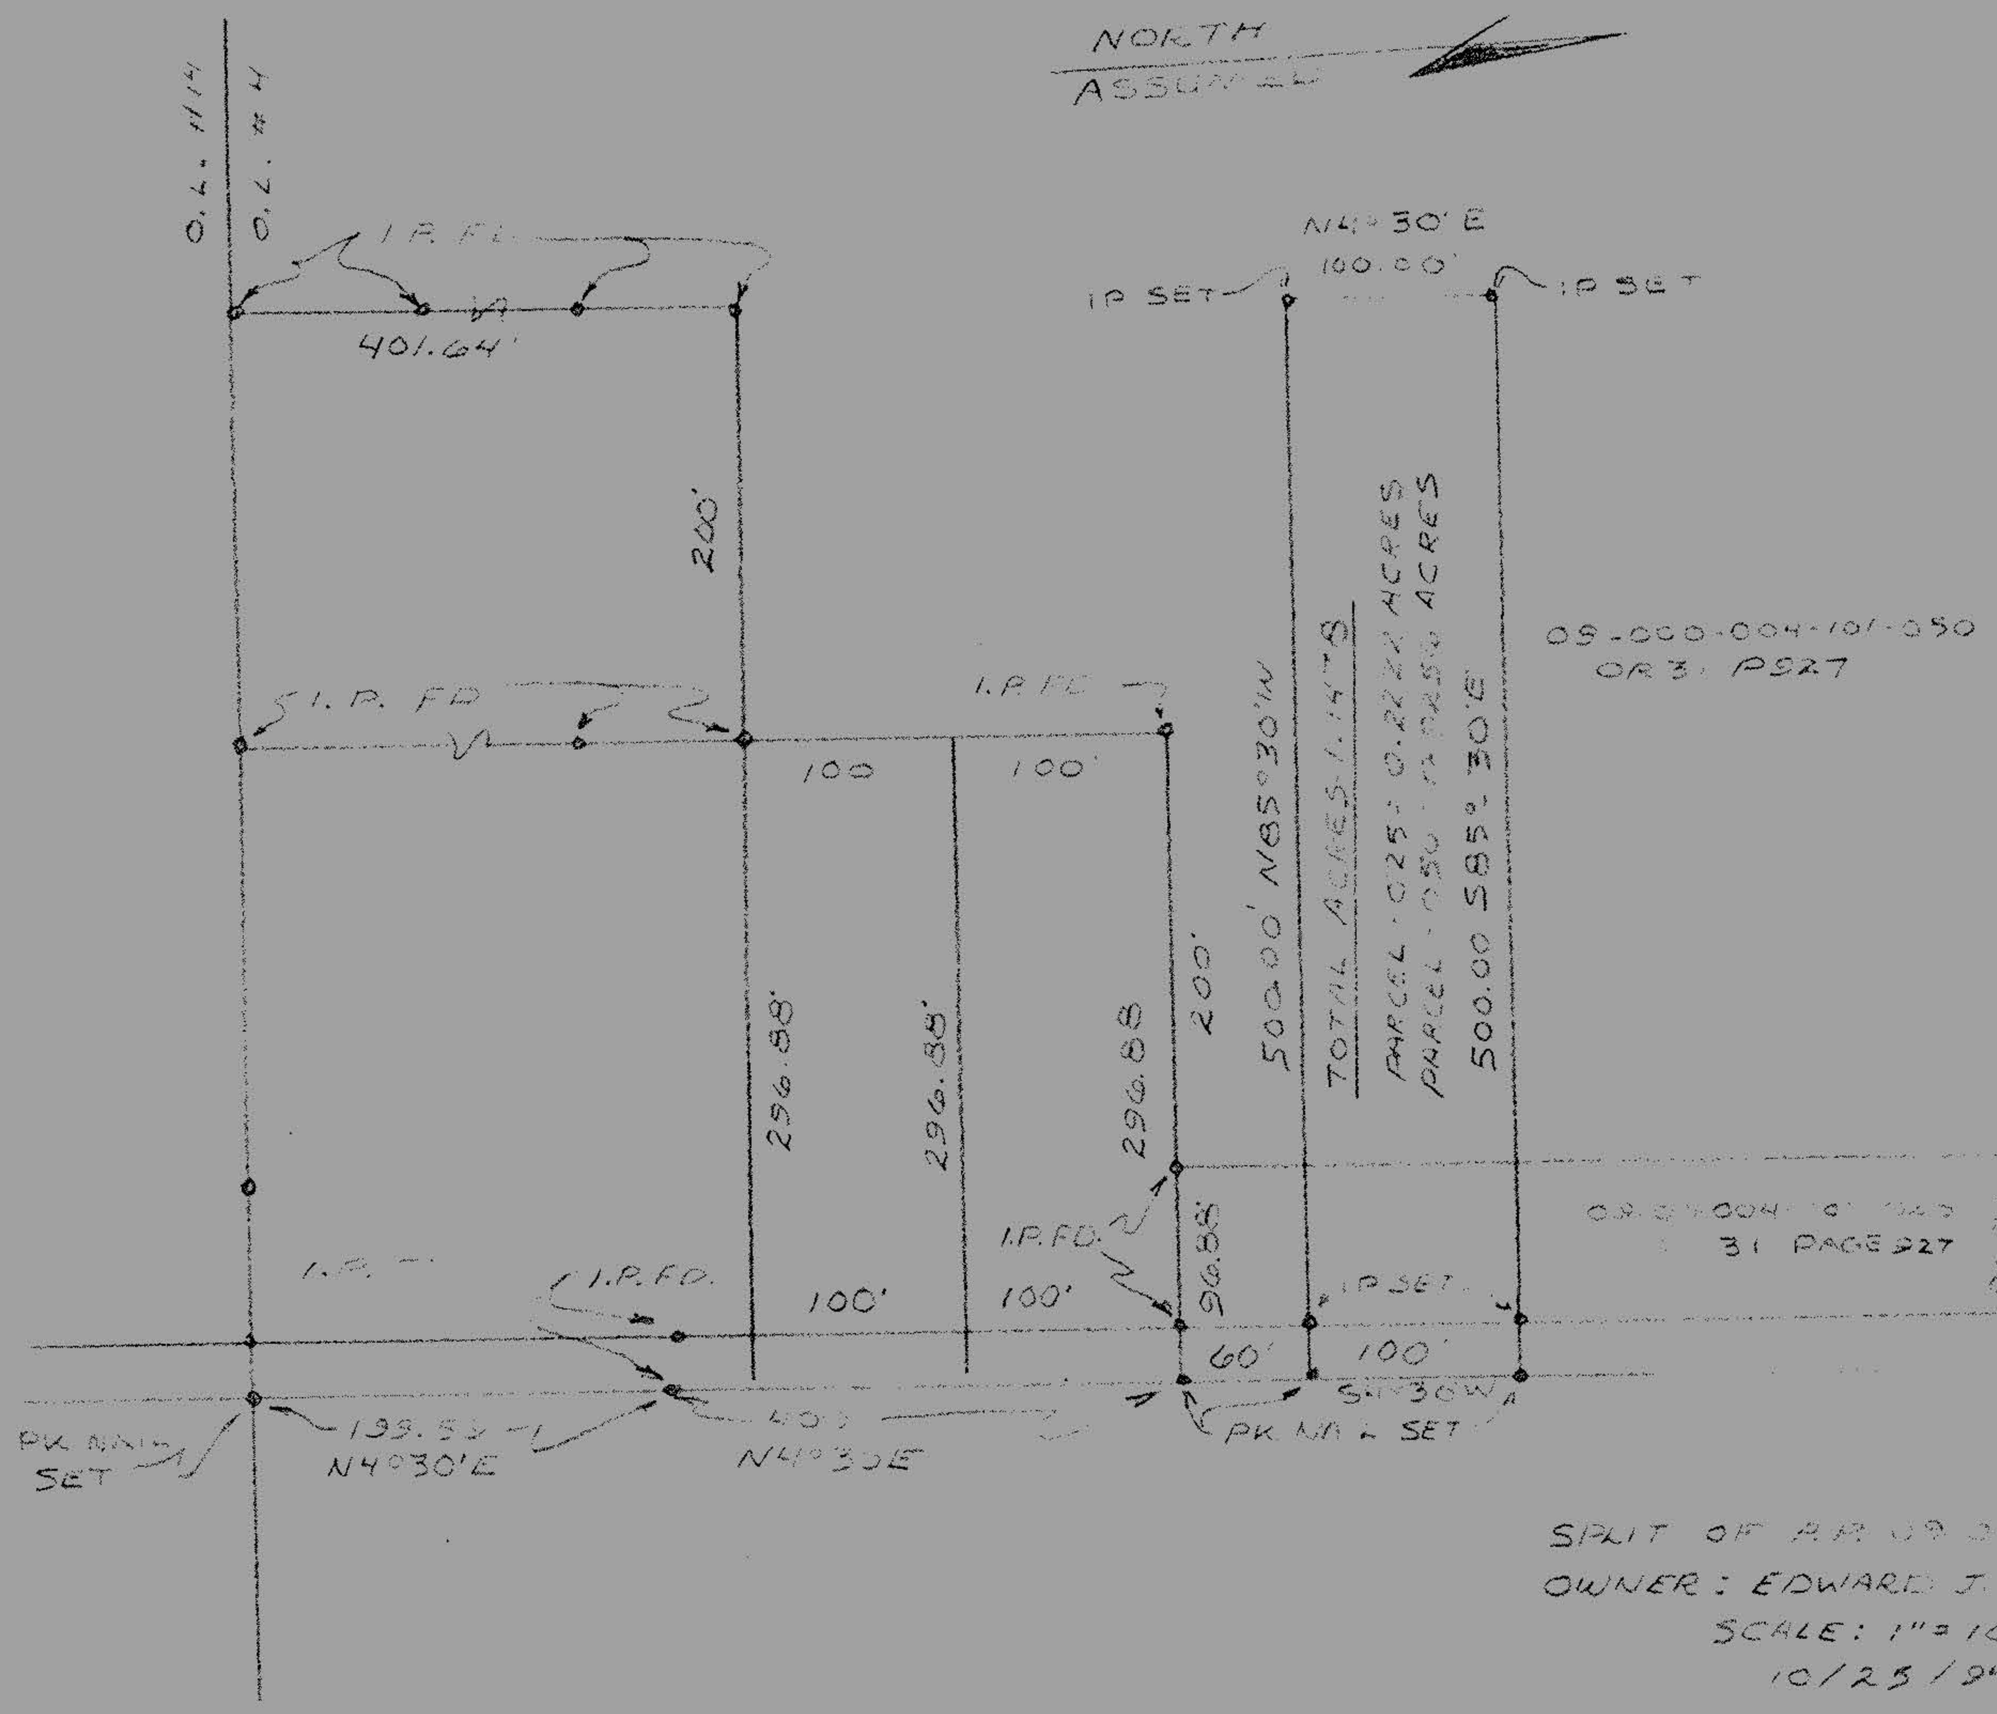

DEED REFERENCE OR 31 PS27
V1306 P850

STATE OF OHIO - COUNTY OF LORAIN
VILLAGE OF SOUTH AMHERST
ORIGINAL RUSSIA TOWNSHIP
ORIGINAL LOT NO. 4

BEARINGS ARE ASSUMED

IRON PINS SET ARE 5/8" ∅ REBAR - 30" LONG

CARL R. ANDERSON
REGISTERED SURVEYOR

Carl R. Anderson
CARL R. ANDERSON

SPLIT OF P.P. 09-000-004-101-050 & -025
OWNER: EDWARD J. & JUDITH M. LALONDE
SCALE: 1" = 100'
10/25/94

DRAWING NO. 178-94

#21263

APPROVED
LORAIN CO.
MAP DEPT.
DATE 4/17/95
PAGE 9-00-004-A
BY T. McMain DEP
VOID AFTER 21263