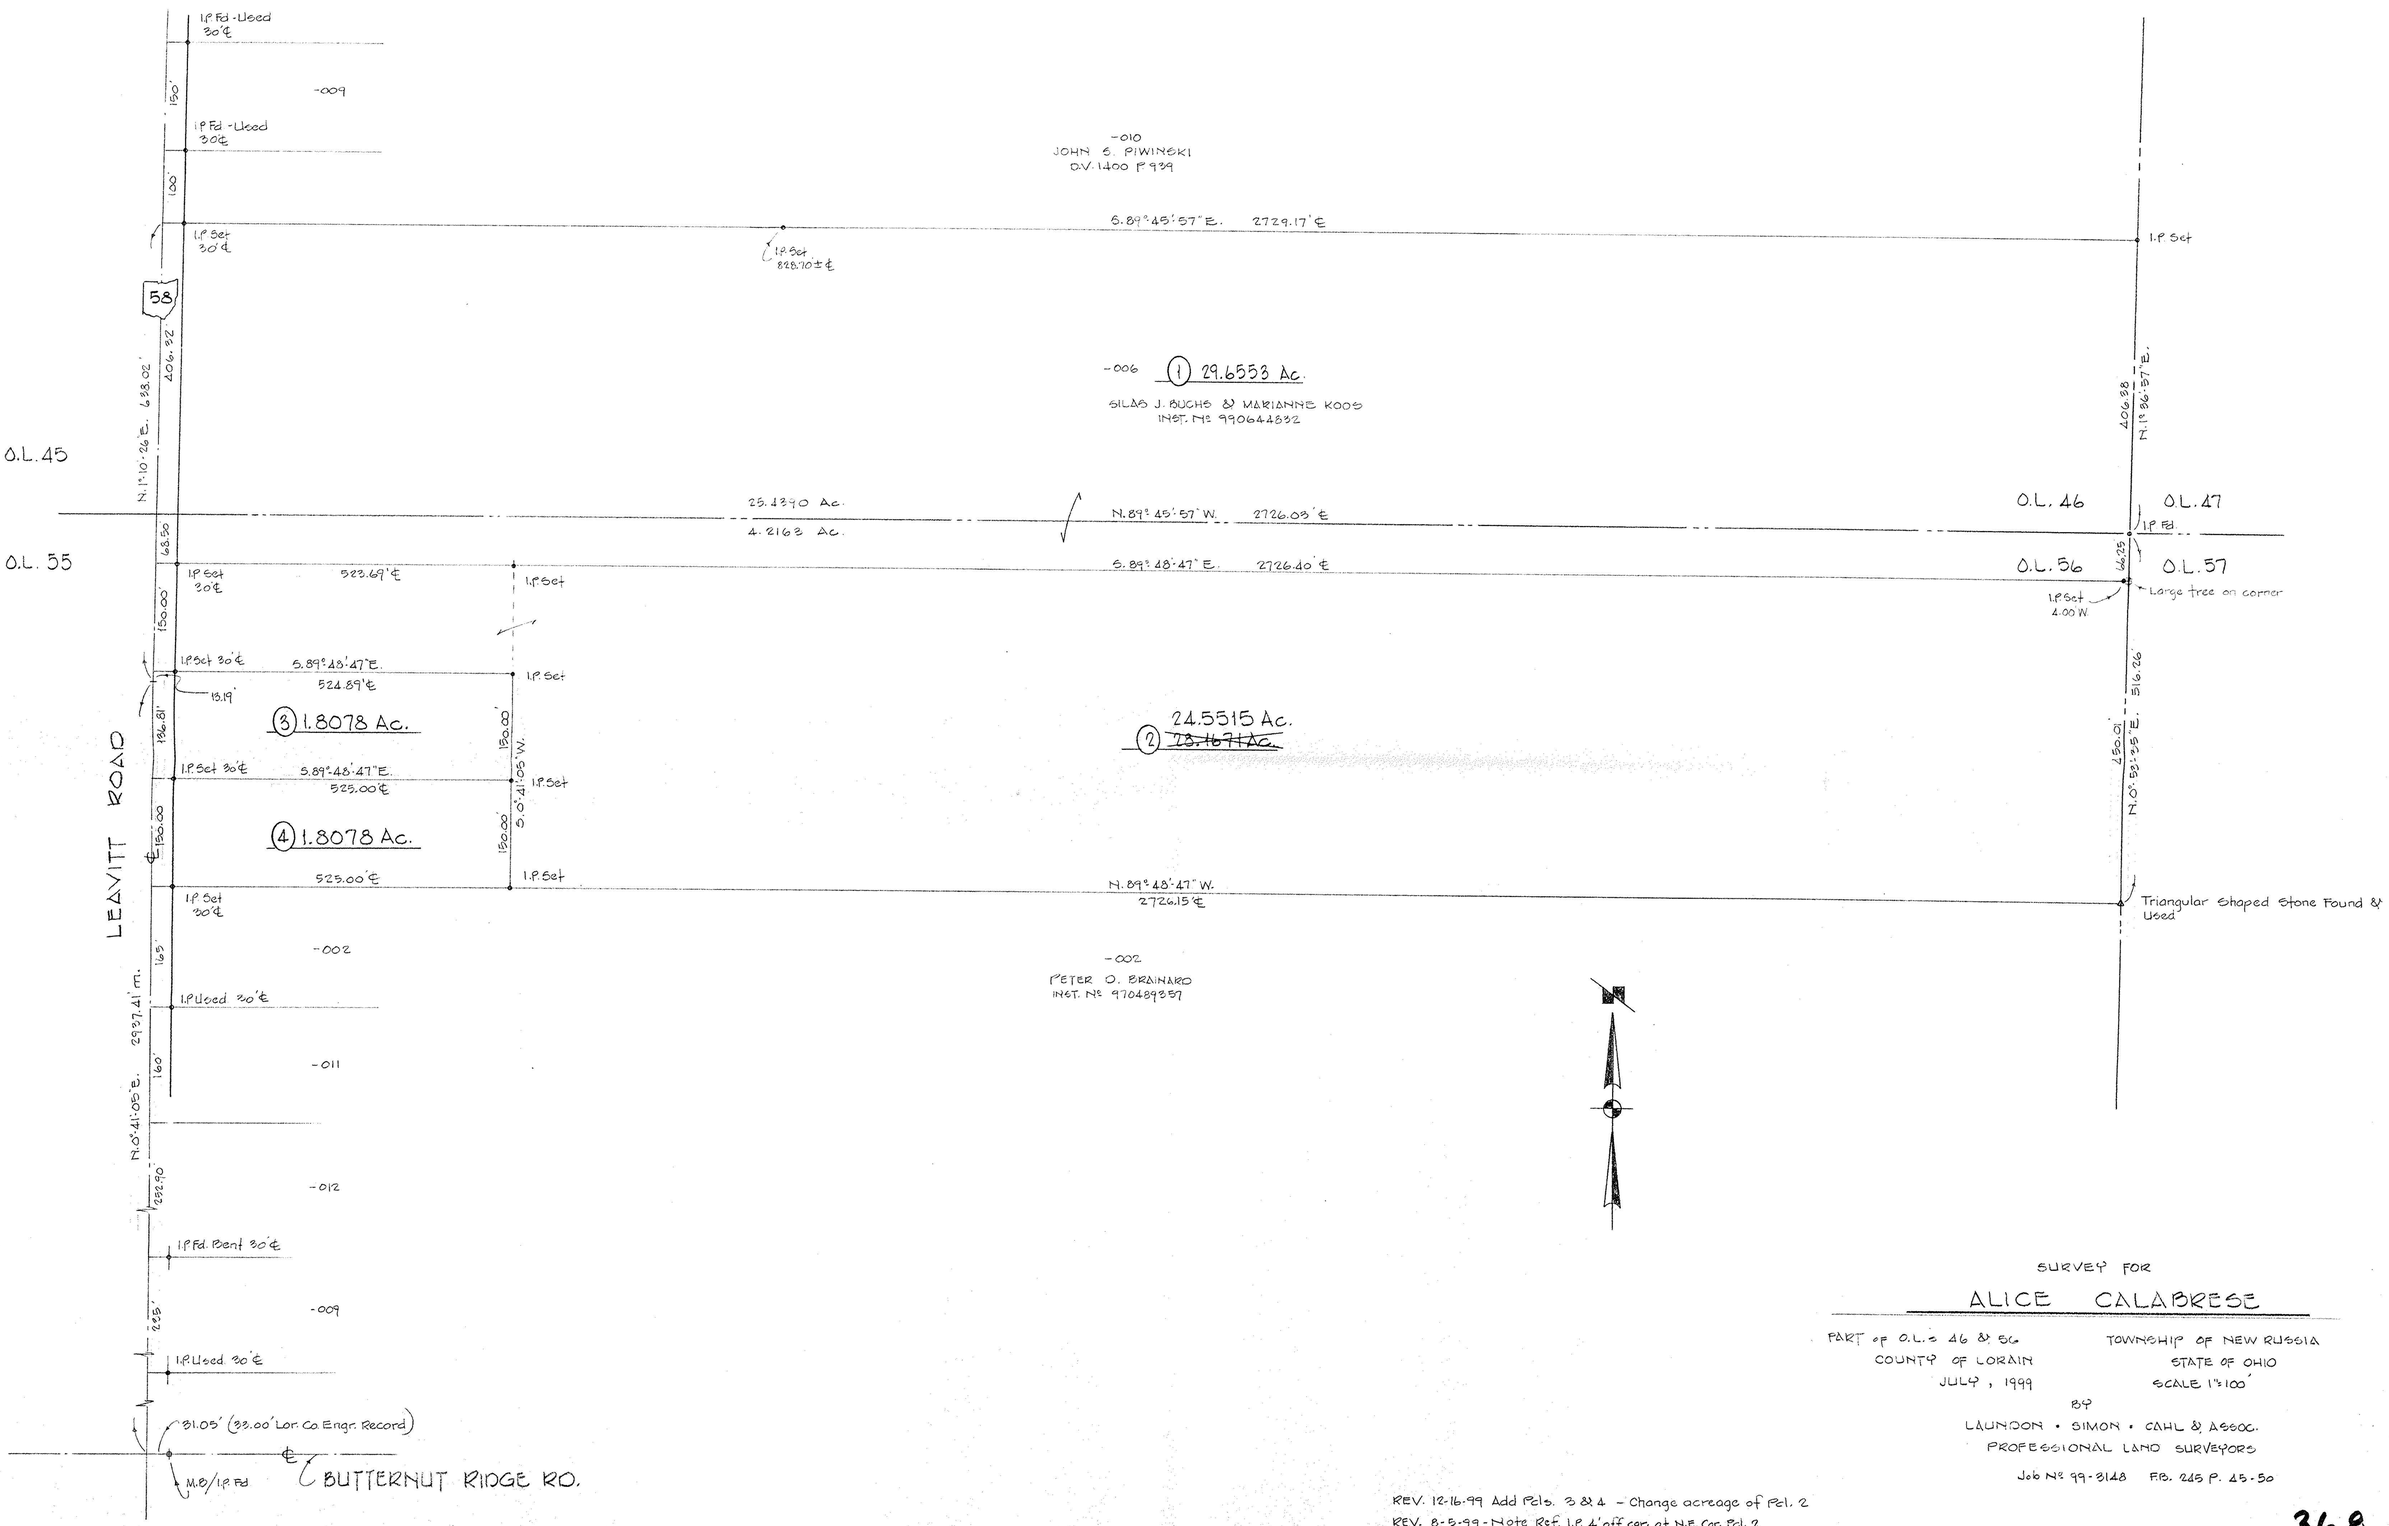


SURVEY FOR

ALICE CALABRESE

PART of O.L.s 46 & 56 — TOWNSHIP OF NEW RUSSIA

COUNTY OF LORAIN — STATE OF OHIO

JULY, 1999 — SCALE 1"=100'

BY

LAUNDON • SIMON • CAHL & ASSOC.

PROFESSIONAL LAND SURVEYORS

Job № 99-3148 FB. 245 P. 45-50

REV. 12-16-99 Add Pcls. 3 & 4 - Change acreage of Pcl. 2

REV. 8-5-99 - Note Ref. I.P. 4' off cor. at N.E. Cor. Pcl. 2