

Scale 1" = 200'


April 30, 1977

Pyle South Annex

By Arnold F. Koepf Registered Surveyor

#16521

APPROVED
LORAIN CO.
MAP DEPT.
DATE 2/21/86
PAGE 9-F
BY T. McMillan
VOID AFTER

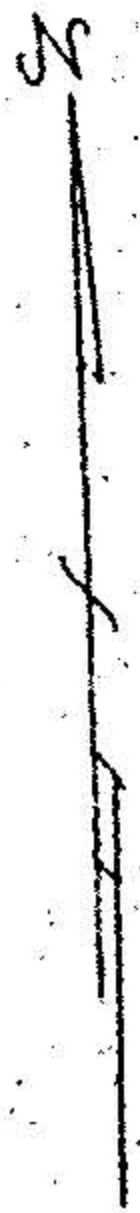

Garon J. Rittenhouse Vol 1117 Page 771

1468.31
No: 06 E

10.10 Ac

50:06' W
1465.09

10.27 Ac Incl (A. Atkins)

500-06 W

1461.86 To E (1236.36)

1236.36

09-00-05A-000-034

97589-32 E (97.44)

Albert P. Atkins

10.65 Ac

Salomon

50-06-00 W 225.00

11.08 Dup

1458.46

No: 49 E
No: 49 E

9.96 Ac

50:49 W

No: 49 E

1329.74

Nicholas & Donna Brella

Vol 1147 - Pages 220-228

1326.17

Arthur & Mary Rogers
Arthur & Dorothy Rogers Vol 1002-071

* FIGURES IN GREEN ARE CORRECT FIGURES PER PHONE CALL W/ A. KOEPP 2/21/86 @ 9:40

CL: 1:34483
CALC. 10.17 A.

1243.01
S 89:54 E

1826.80 Deed
To R.R. P/W

283.79

215.00

197.76

324.84

348.50

1326.17

Butternut Ridge Road

(MON TO MON Co. Record) = 2775.36 (Measured 2776.64)

11.08
10.65
0.43